


414-728-6737



LOTS 10290 - 10301, BLOCK 187,
LAKE COMO BEACH SUBDIVISION,
LOCATED IN T2N, R17E, WALWORTH
COUNTY, WISCONSIN.

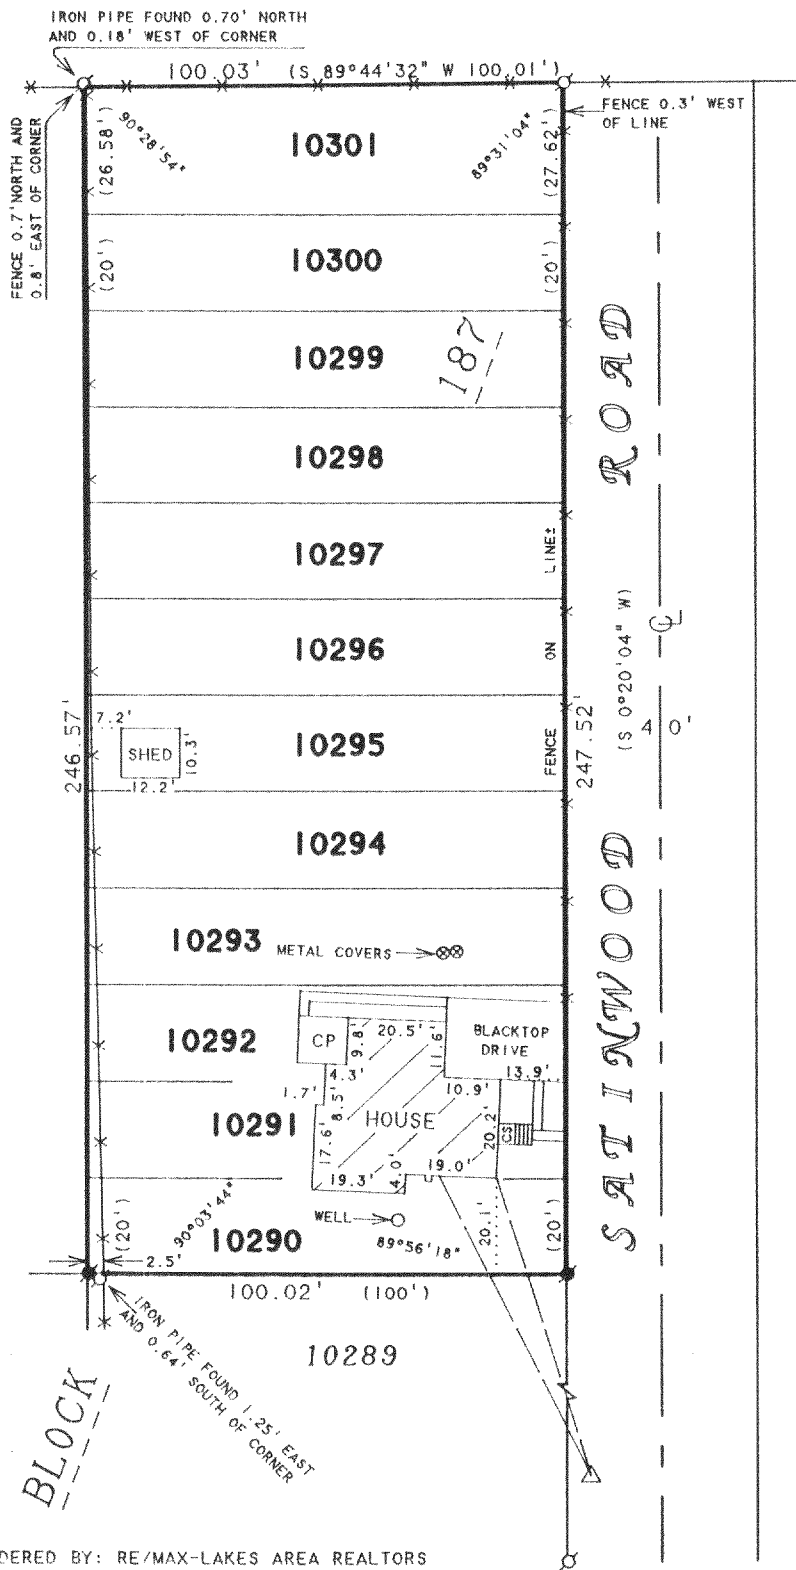

SCALE 1" = 40'

LEGEND

- ♂ - IRON PIPE FOUND
 ● - IRON ROD FOUND
 * - * - WIRE OR CHAINLINK FENCE
 △ - UTILITY POLE
 — — — — — OVERHEAD UTILITY LINES
 CP - CONCRETE PATIO
 CS - CONCRETE STOOP
 () - RECORDED AS

ORDERED BY: RE/MAX-LAKES AREA REALTORS
1815 N. SHORE DRIVE
DELAVAN, WI. 53115

I HEREBY CERTIFY THAT I HAVE SURVEYED THE ABOVE DESCRIBED PROPERTY AND THAT THE ABOVE MAP IS A TRUE REPRESENTATION THEREOF AND SHOWS THE SIZE AND LOCATION OF THE PROPERTY, ITS EXTERIOR BOUNDARIES, THE LOCATION OF ALL VISIBLE STRUCTURES AND DIMENSIONS OF ALL PRINCIPAL BUILDINGS THEREON, BOUNDARY FENCES, APPARENT EASEMENTS, ROADWAYS AND VISIBLE ENCROACHMENTS, IF ANY, TO THE BEST OF MY KNOWLEDGE AND BELIEF.

THIS SURVEY IS MADE FOR THE USE OF THE PRESENT OWNERS OF THE PROPERTY, AND ALSO THOSE WHO PURCHASE, MORTGAGE, OR GUARANTEE THE TITLE THERETO WITHIN ONE (1) YEAR FROM DATE HEREON.

DAVID F. ABELL
WISCONSIN REGISTERED LAND SURVEYOR, S-1596

August 11, 1993

DATE 9-2-77 JOB NUMBER - 93174
NOTE: THIS IS NOT A CERTIFIED COPY UNLESS SEALED.

RECEIVED
OCT 28 1964
dg

JLCB-2227

217-1178