


# KOLB LAND CONSULTING, INC.

LAND SURVEYING • SUBDIVIDING • LAND PLANNING

929 WILLIAMS STREET

LAKE GENEVA, WISCONSIN 53147

414 248 3697

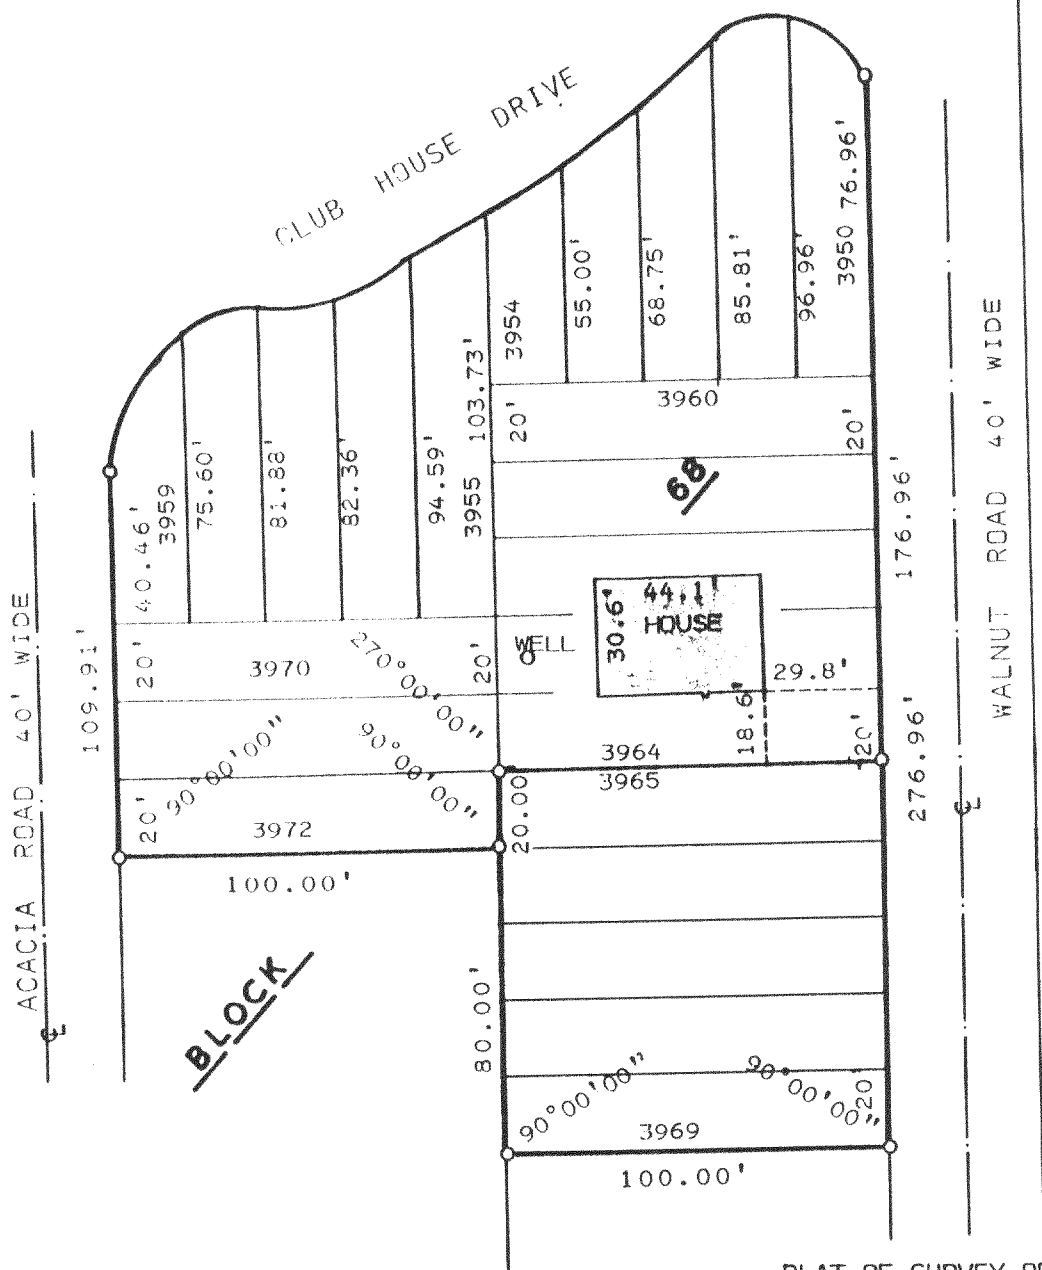

PLAT OF SURVEY OF

ORDERED BY: LOIS KUEHN %  
FRANK LINDLEY  
3617 HWY 67  
WILLIAMS BAY, WI. 53191


LOTS 3950-3972, BLOCK 68 OF LAKE COMO  
BEACH SUBDIVISION LOCATED IN T2N, R17E,  
TOWN OF GENEVA, WALWORTH COUNTY, WISCONSIN.



SCALE: 1" = 50'

## LEGEND

- ♂ - IRON PIPE FOUND
- o - IRON PIPE SET

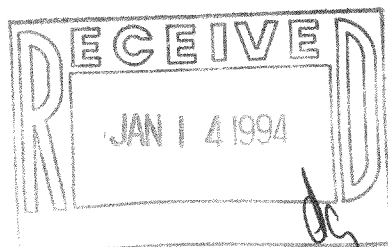

I, HAROLD H. KOLB, DO HEREBY CERTIFY  
THAT I HAVE SURVEYED THE PROPERTY  
HEREON DESCRIBED ACCORDING TO THE  
OFFICIAL RECORDS AND THAT THE PLAT  
HEREON IS A CORRECT REPRESENTATION  
OF THE LOT LINES AND THE PRINCIPAL  
LINES OF THE BUILDING, TO THE BEST  
OF MY KNOWLEDGE AND BELIEF.  
SURVEY NOT VALID UNLESS SURVEYOR'S SIGNATURE  
IS IN RED.

HAROLD H. KOLB

WISCONSIN REGISTERED LAND SURVEYOR, S-187

DATE JULY 30, 1993

REVISED AUGUST 20, 1993


REVISED

KOLB LAND CONSULTING, INC.  
LAND SURVEYING • SUBDIVIDING • LAND PLANNING

929 WILLIAMS STREET

LAKE GENEVA, WISCONSIN 53147


414 248 3697

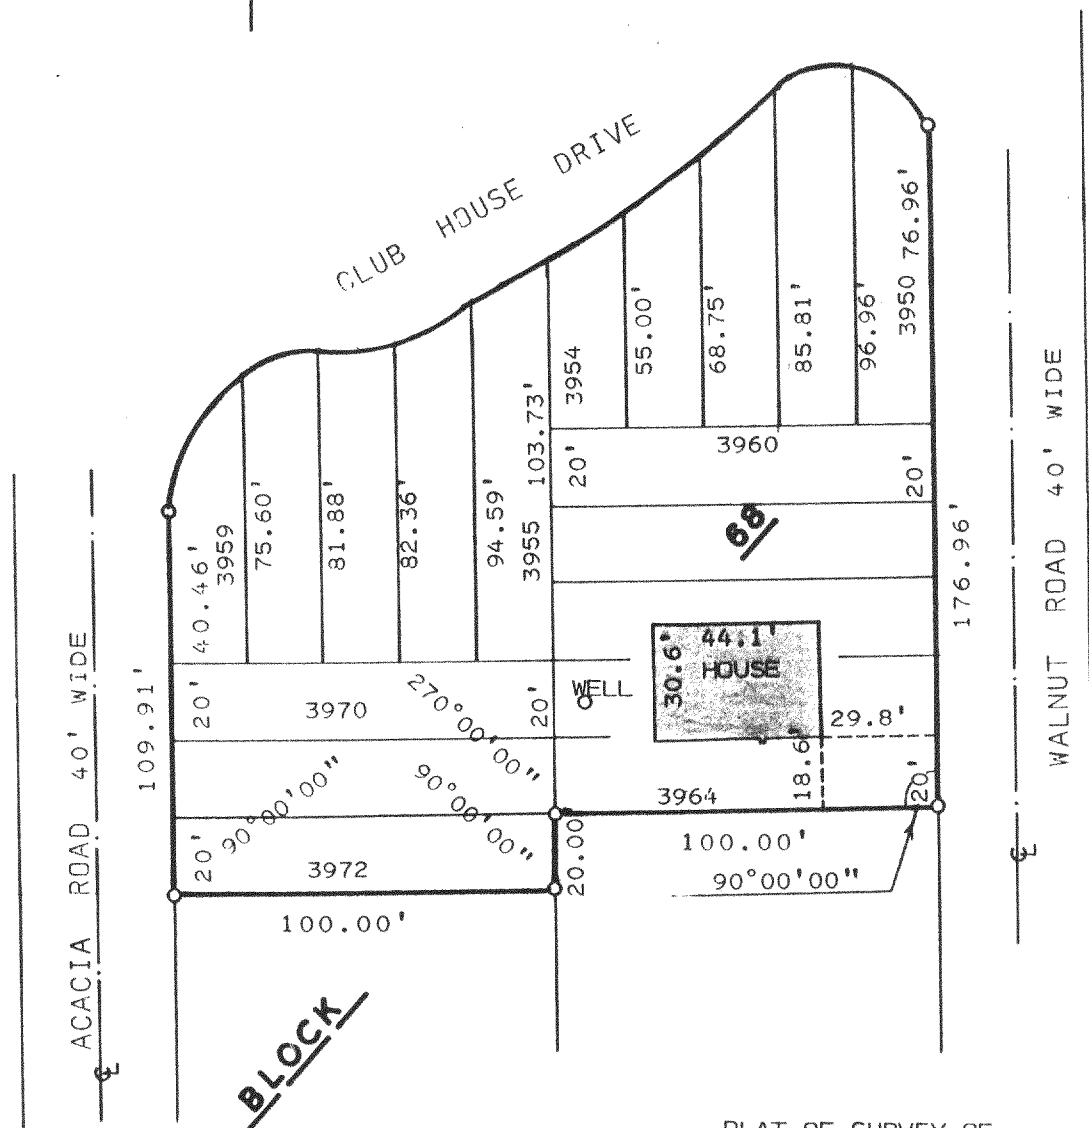

PLAT OF SURVEY OF

LOTS 3950-3964 AND LOTS 3970-3972, BLOCK 68  
OF LAKE COMO BEACH SUBDIVISION LOCATED IN  
T2N, R17E, TOWN OF GENEVA, WALWORTH COUNTY,  
WISCONSIN.

ORDERED BY: LOIS KUEHN %  
FRANK LINDLEY  
3617 HWY 67  
WILLIAMS BAY, WI. 53191

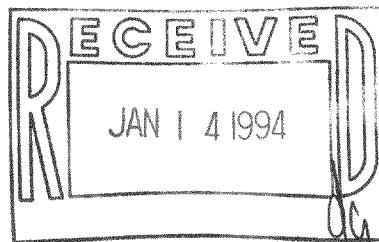

SCALE: 1" = 50'

LEGEND

- ♂ - IRON PIPE FOUND  
○ - IRON PIPE SET

I, HAROLD H. KOLB, DO HEREBY CERTIFY  
THAT I HAVE SURVEYED THE PROPERTY  
HEREON DESCRIBED ACCORDING TO THE  
OFFICIAL RECORDS AND THAT THE PLAT  
HEREON IS A CORRECT REPRESENTATION  
OF THE LOT LINES AND THE PRINCIPAL  
LINES OF THE BUILDING, TO THE BEST  
OF MY KNOWLEDGE AND BELIEF.  
SURVEY NOT VALID UNLESS SURVEYOR'S SIGNATURE  
IS IN RED.

HAROLD H. KOLB

WISCONSIN REGISTERED LAND SURVEYOR, S- 187

DATE JULY 30, 1993

REVISED

REVISED

JLCB-756  
JLCB-758