


COMO ROAD

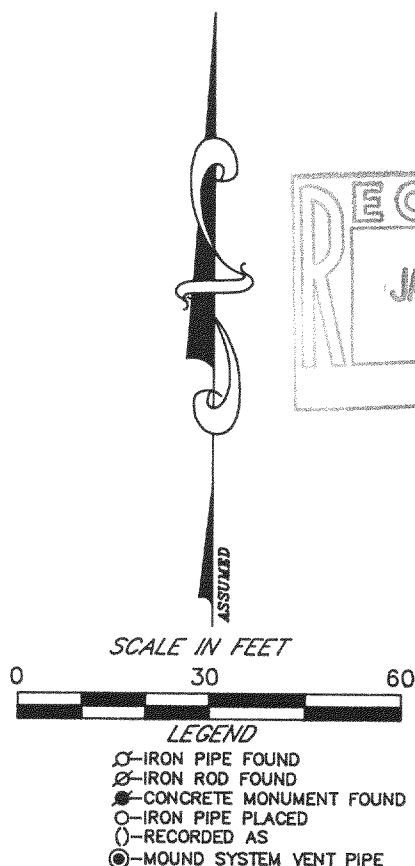

217-1215