



CENTURY LAND SURVEYING

PLAT OF SURVEY

Lots 11629 thru 11636 in Block 209 of Lake Como Beach,
a Subdivision located in Township 2 North, Range 17 East,
in Walworth County, Wisconsin.



SCALE 1" = 20'

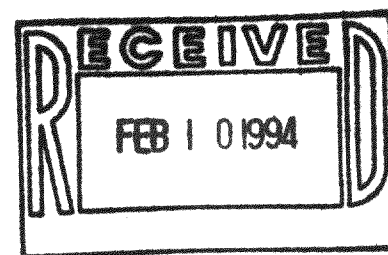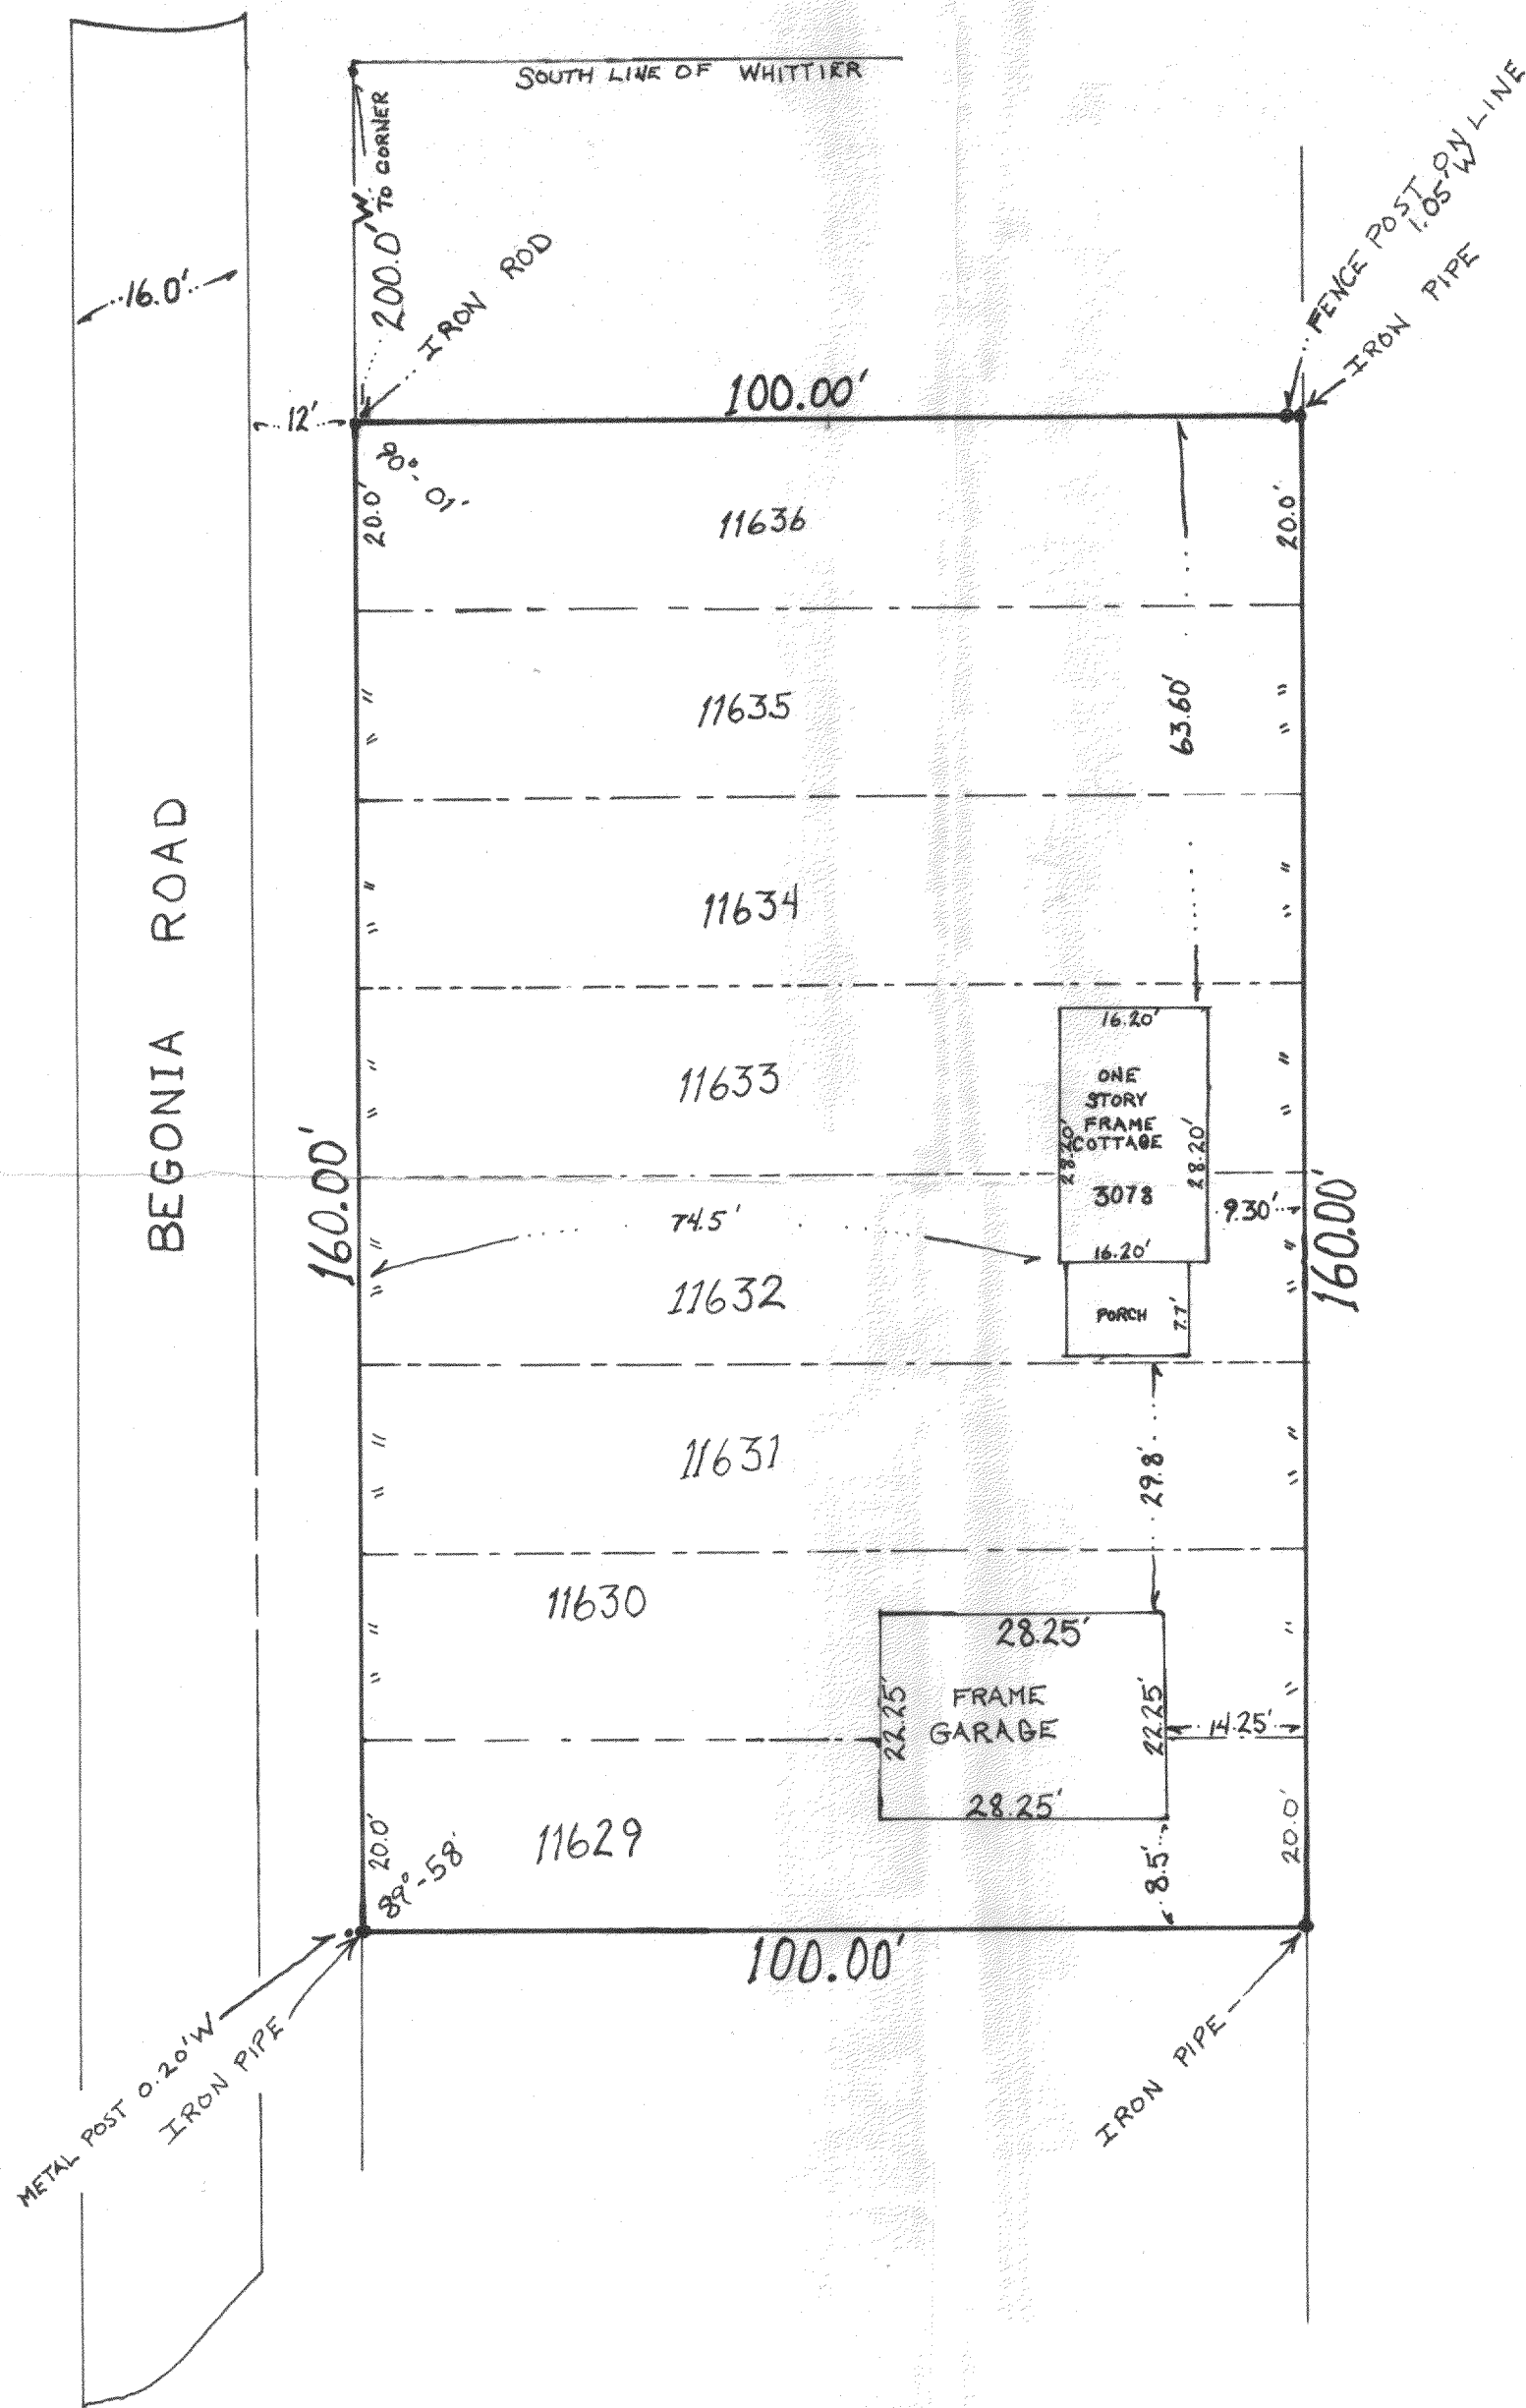

DATE: July 20, 1993
ORDERED BY: Carol Bernacky

SURVEY NO. 220
FIELD BOOK 2 - Walworth County
Page 2

NOTE: Any discrepancy in measurement discovered
upon the ground should be promptly reported
to the surveyor for explanation or correction.

DATE: July 20, 1993
STATE OF WISCONSIN
WALWORTH COUNTY

Charles E. Smith hereby certifies
that he has surveyed the above described
property and that the
plat hereon drawn is a correct
representation of same.

Charles E. Smith
Wisconsin Registered Land
Surveyor No. 1038

