


48-43

DESCRIPTION: The West 50.0 feet of Lot 71, Consumer's Subdivision of a portion of Sections 28, 32, and 33, Town 2, north, Range 17 east of the 4th Principal Meridian.

CERTIFICATE: I, hereby certify that I have on this the 17th day of April, 1948, surveyed the above described property according to the official records on file in the office of the Recorder of Deeds in and for Walworth County, Wisconsin, and find that the measurements and bearings of the boundary lines of said property as taken at the site on this day, substantially agree with those in said official record and that no encroachments exist.
SIGNED AND SEALED THIS 19TH DAY OF APRIL 1948.

Joseph M. Biagi
Joseph M. Biagi, Professional Engineer
Elkhorn Wisconsin.

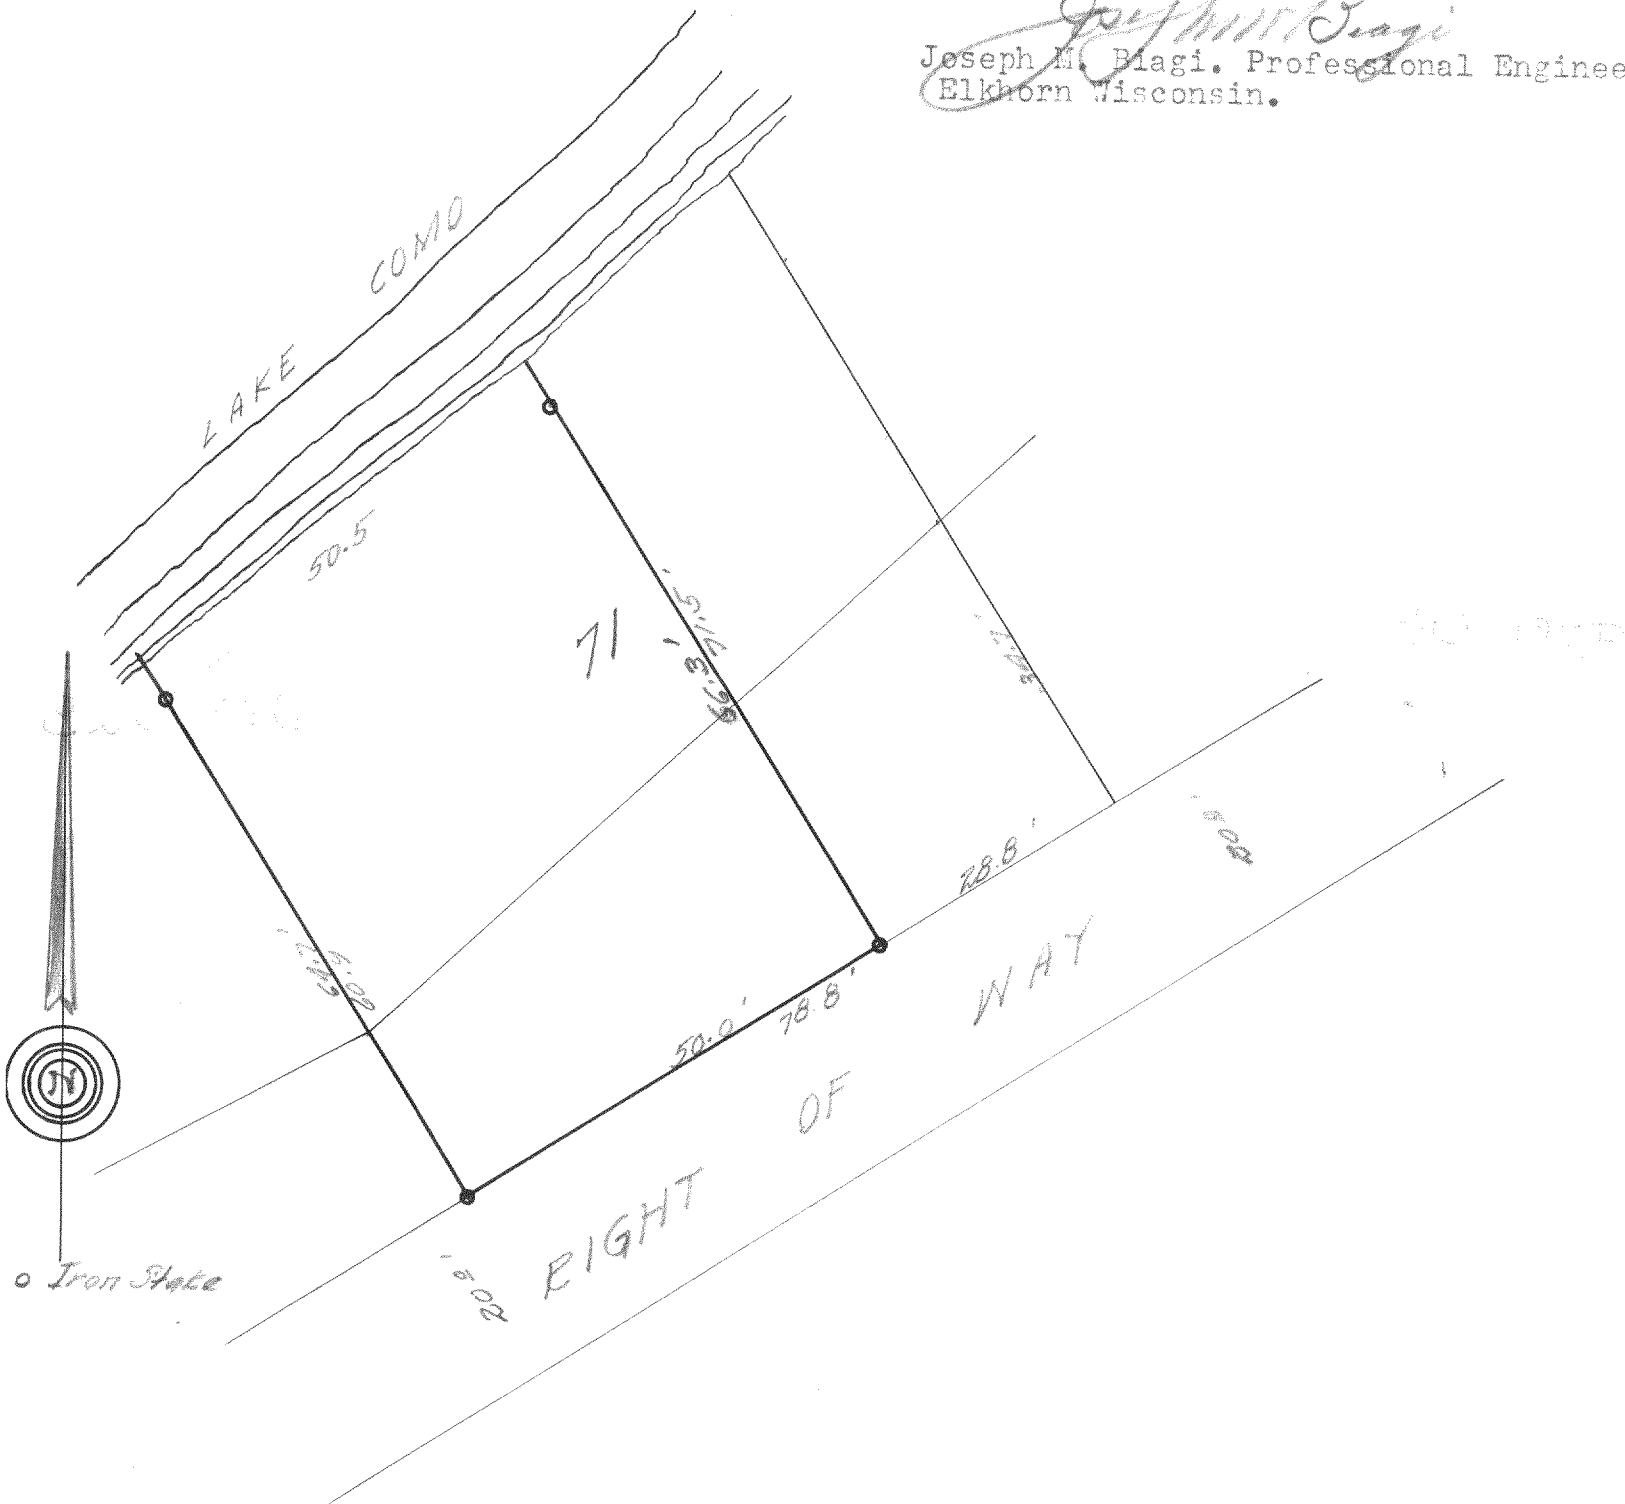

JCON-40

217-122B