


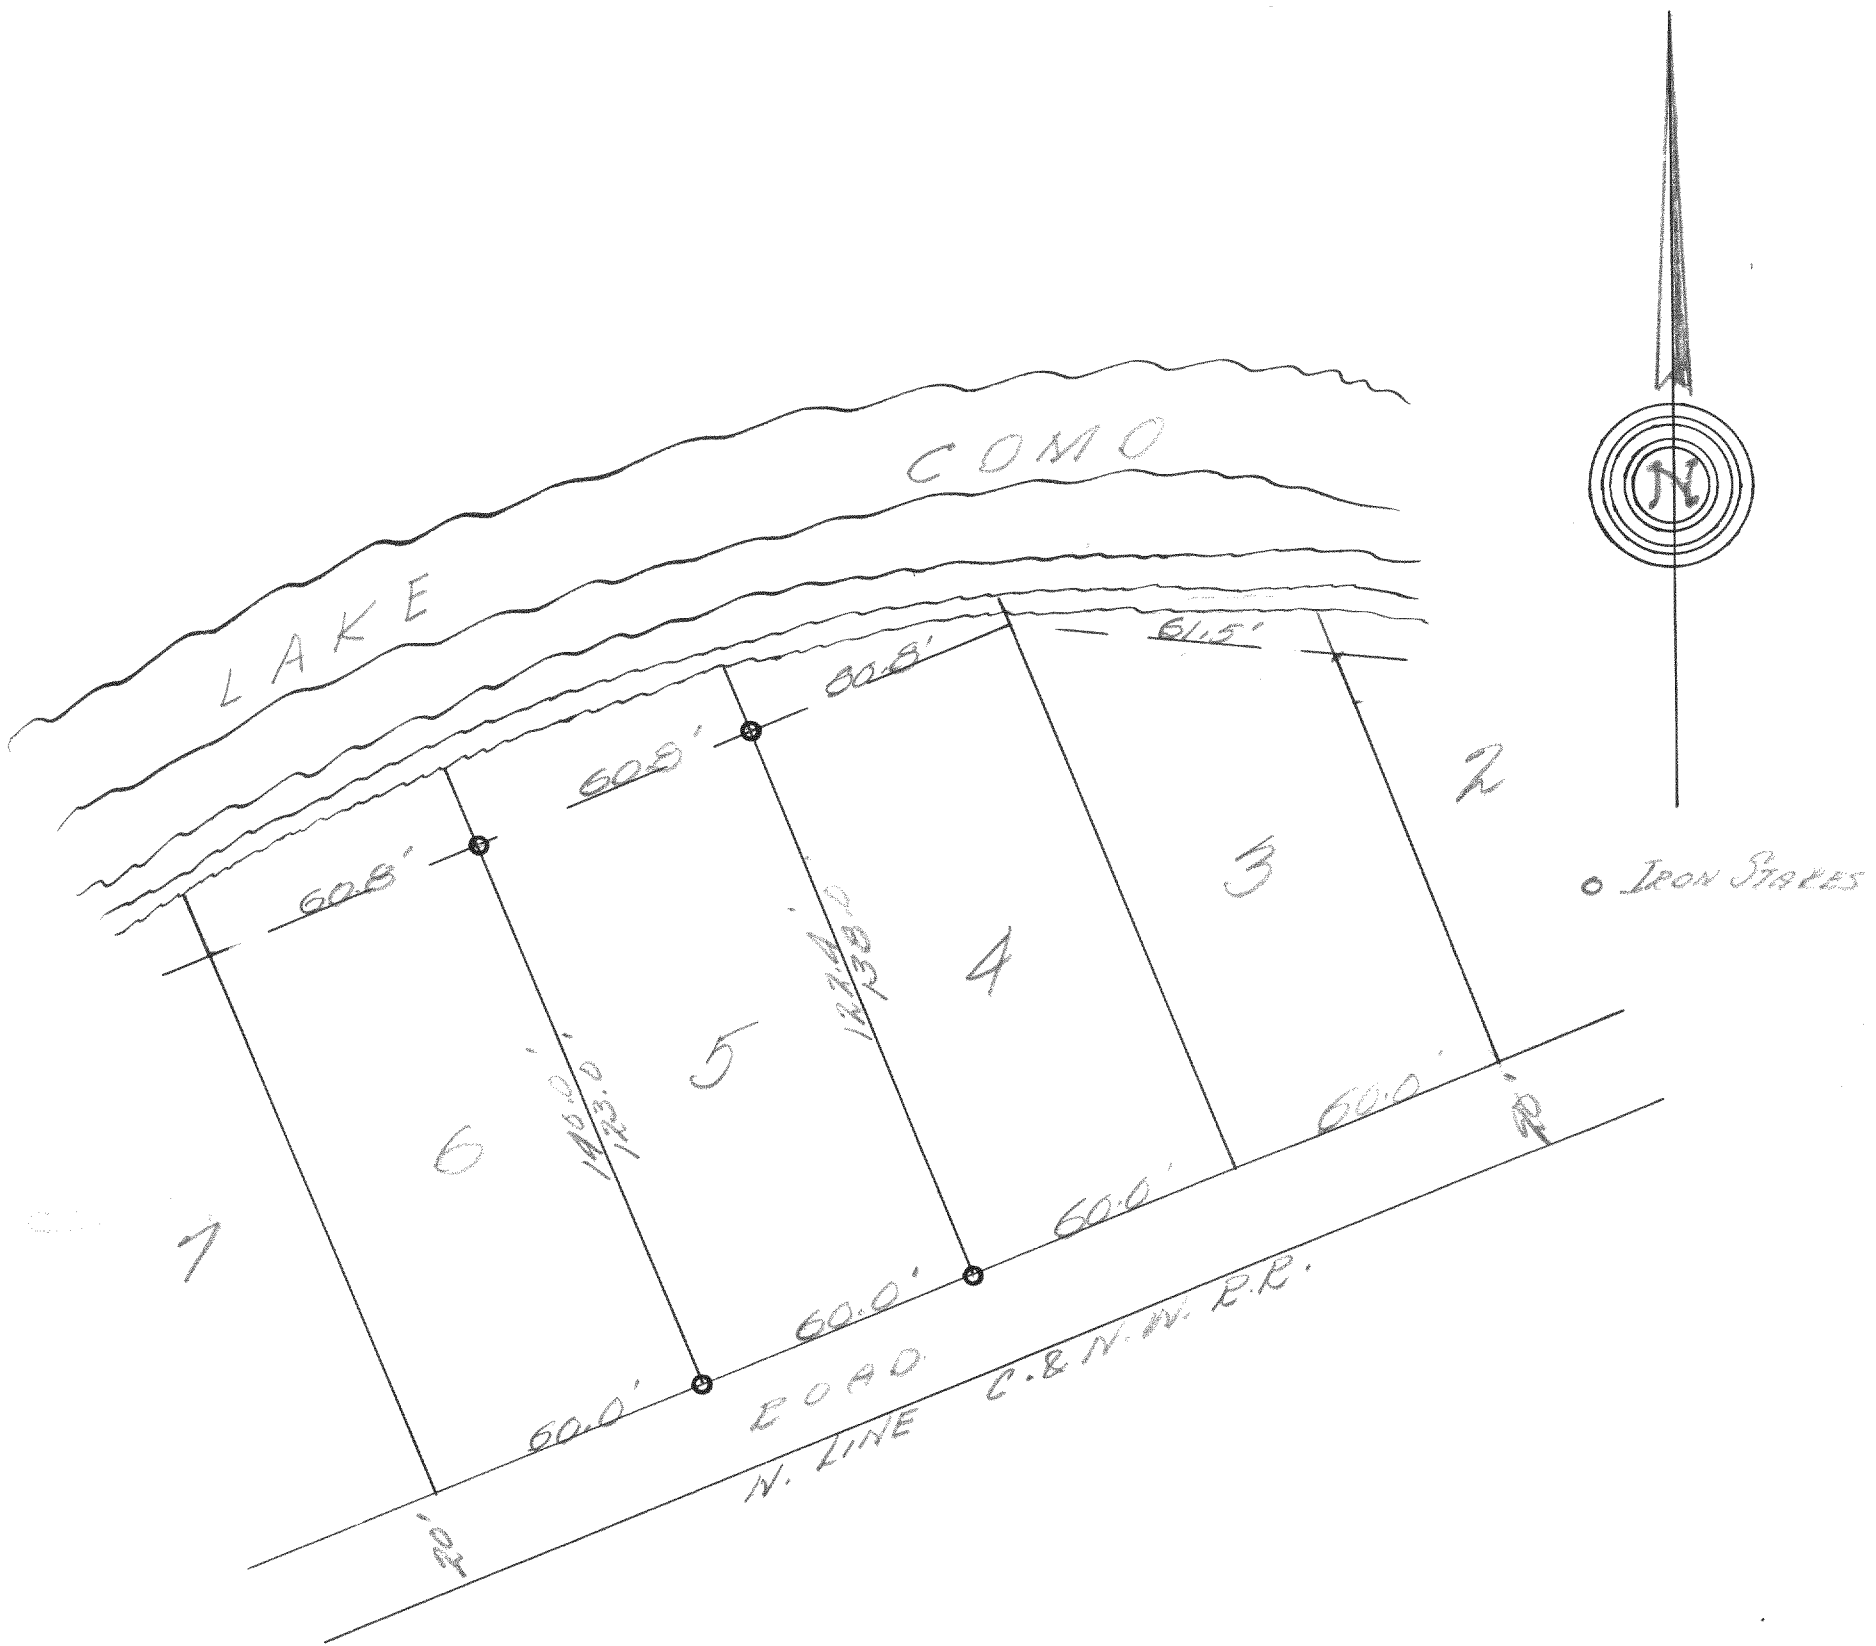

DESCRIPTION:

Lot #5 Consumer's Company Subdivision of a portion of Sections 28, 32, & 33; Township 1 north, Range 17 east of the 4th Principal Meridian.

CERTIFICATE:

I, hereby certify that I have on this the 3rd day of September 1947, surveyed the above described property according to the official records on file in the office of the Recorder of Deeds in and for Walworth County, Wisconsin, and find that the measurements and bearings of the boundary lines of said property as taken at the site on this day substantially agree with those on the above plat and that no encroachments exist.

SIGNED AND SEALED THIS 17TH DAY OF SEPTEMBER 1947.

Joseph M. Biagi, Professional Eng.
Elkhorn Wisconsin.