



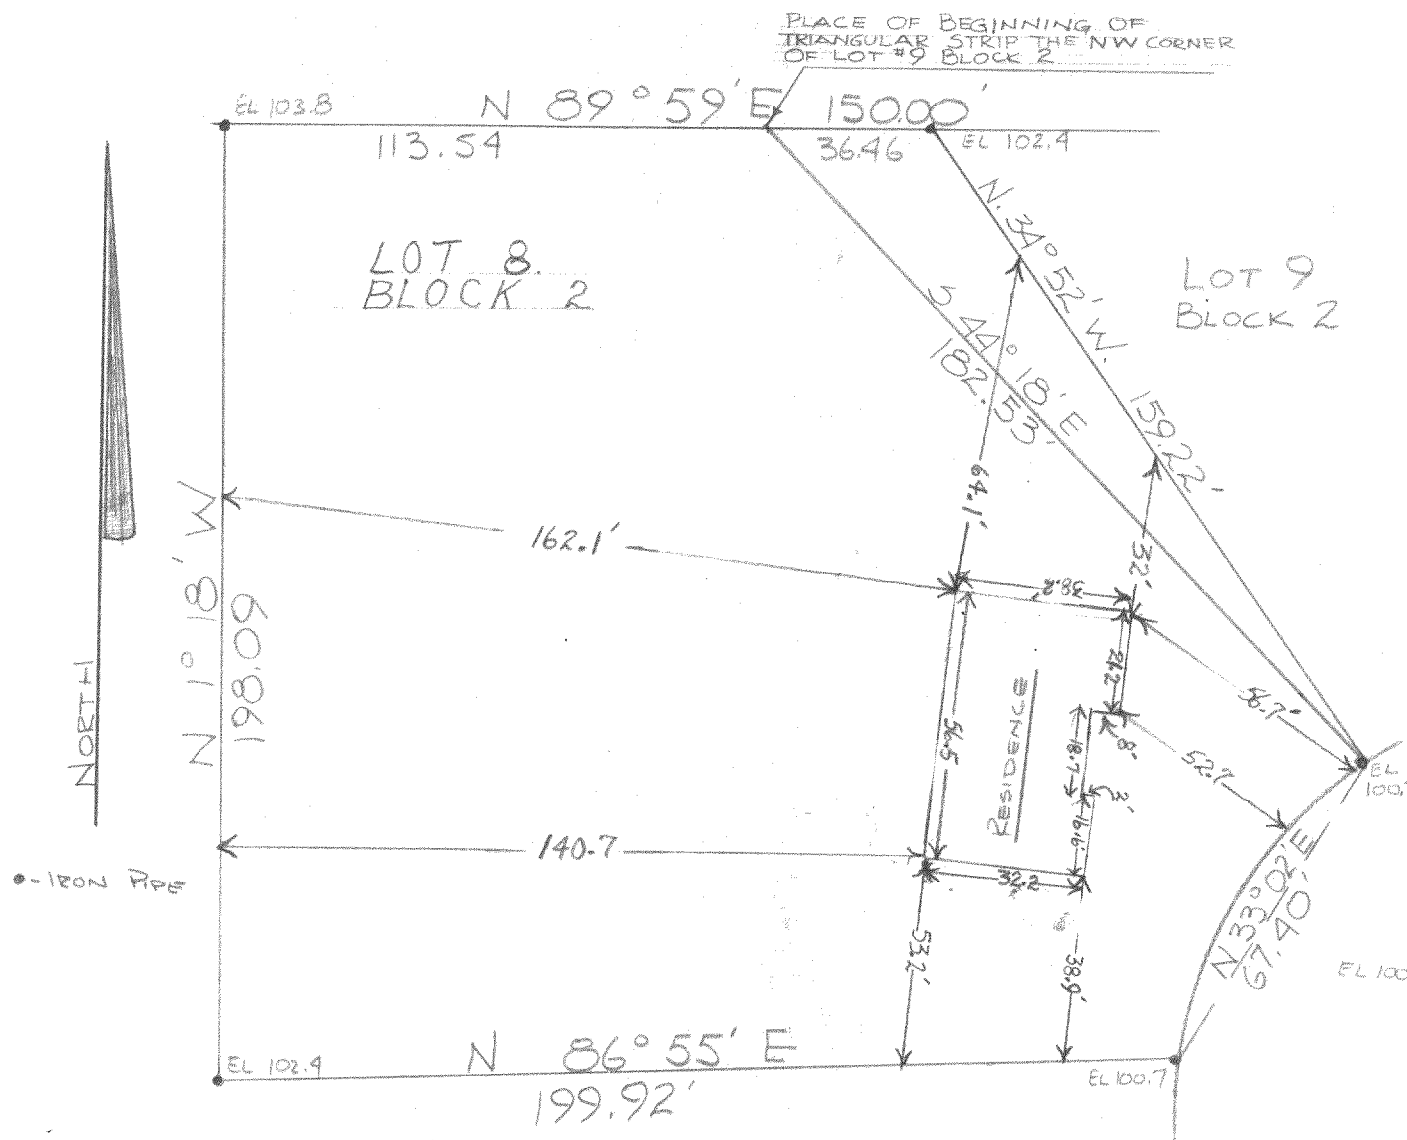

DESCRIPTION: All of Lot 8 Block 2 of Geneva Bay Estates, and the following triangular portion of Lot 9 Block 2 of Geneva Bay Estates; commencing at the NW corner of said Lot 9 thence S. 44° 18' E 182.53 feet, thence N 34° 52' W 159.22 feet thence S 89° 59' W 36.46 feet to the place of beginning; all of said lands being in the town of Geneva, Walworth County, Wisconsin.

CERTIFICATE: I, James F. Biagi, surveyor, do hereby certify that I have surveyed the property hereon described on this 3rd day of June 1961.

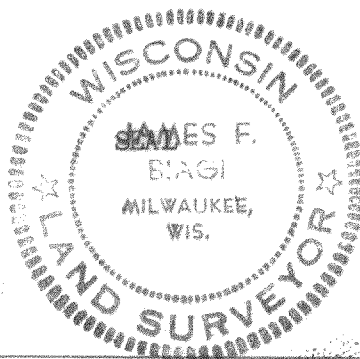

*James F. Biagi*

James F. Biagi RLS 272

Location of all improvements are as shown on the drawing.