

Wisconsin Registered Land Surveyor S-1594

Rt. 3, Box 273
Elkhorn, Wisconsin 53121
Phone: (414) 723-4260 (office)
(414) 723-4813 (residence)

PLAT OF SURVEY


FD. IRON PIPE AS REFERENCED BY
KOLB SURVEY AS BEING 0.50' EAST
OF LINE.

LOTS 5831 AND 5832 AND LOTS 5857
- 5866 OF BLOCK 103 OF LAKE COMO
BEACH SUBDIVISION, TOWN OF
GENEVA, WALWORTH COUNTY,
WISCONSIN.

SELLER: ANTHONY AND MYRA AMATO
RT. 2 BOX 335K-2
LAKE GENEVA, WI. 53147

BUYER: WILLIAM E. COREY


ORDERED BY: LAKE GENEVA PROPERTIES
816 WILLIAMS ST.
LAKE GENEVA, WI. 53147

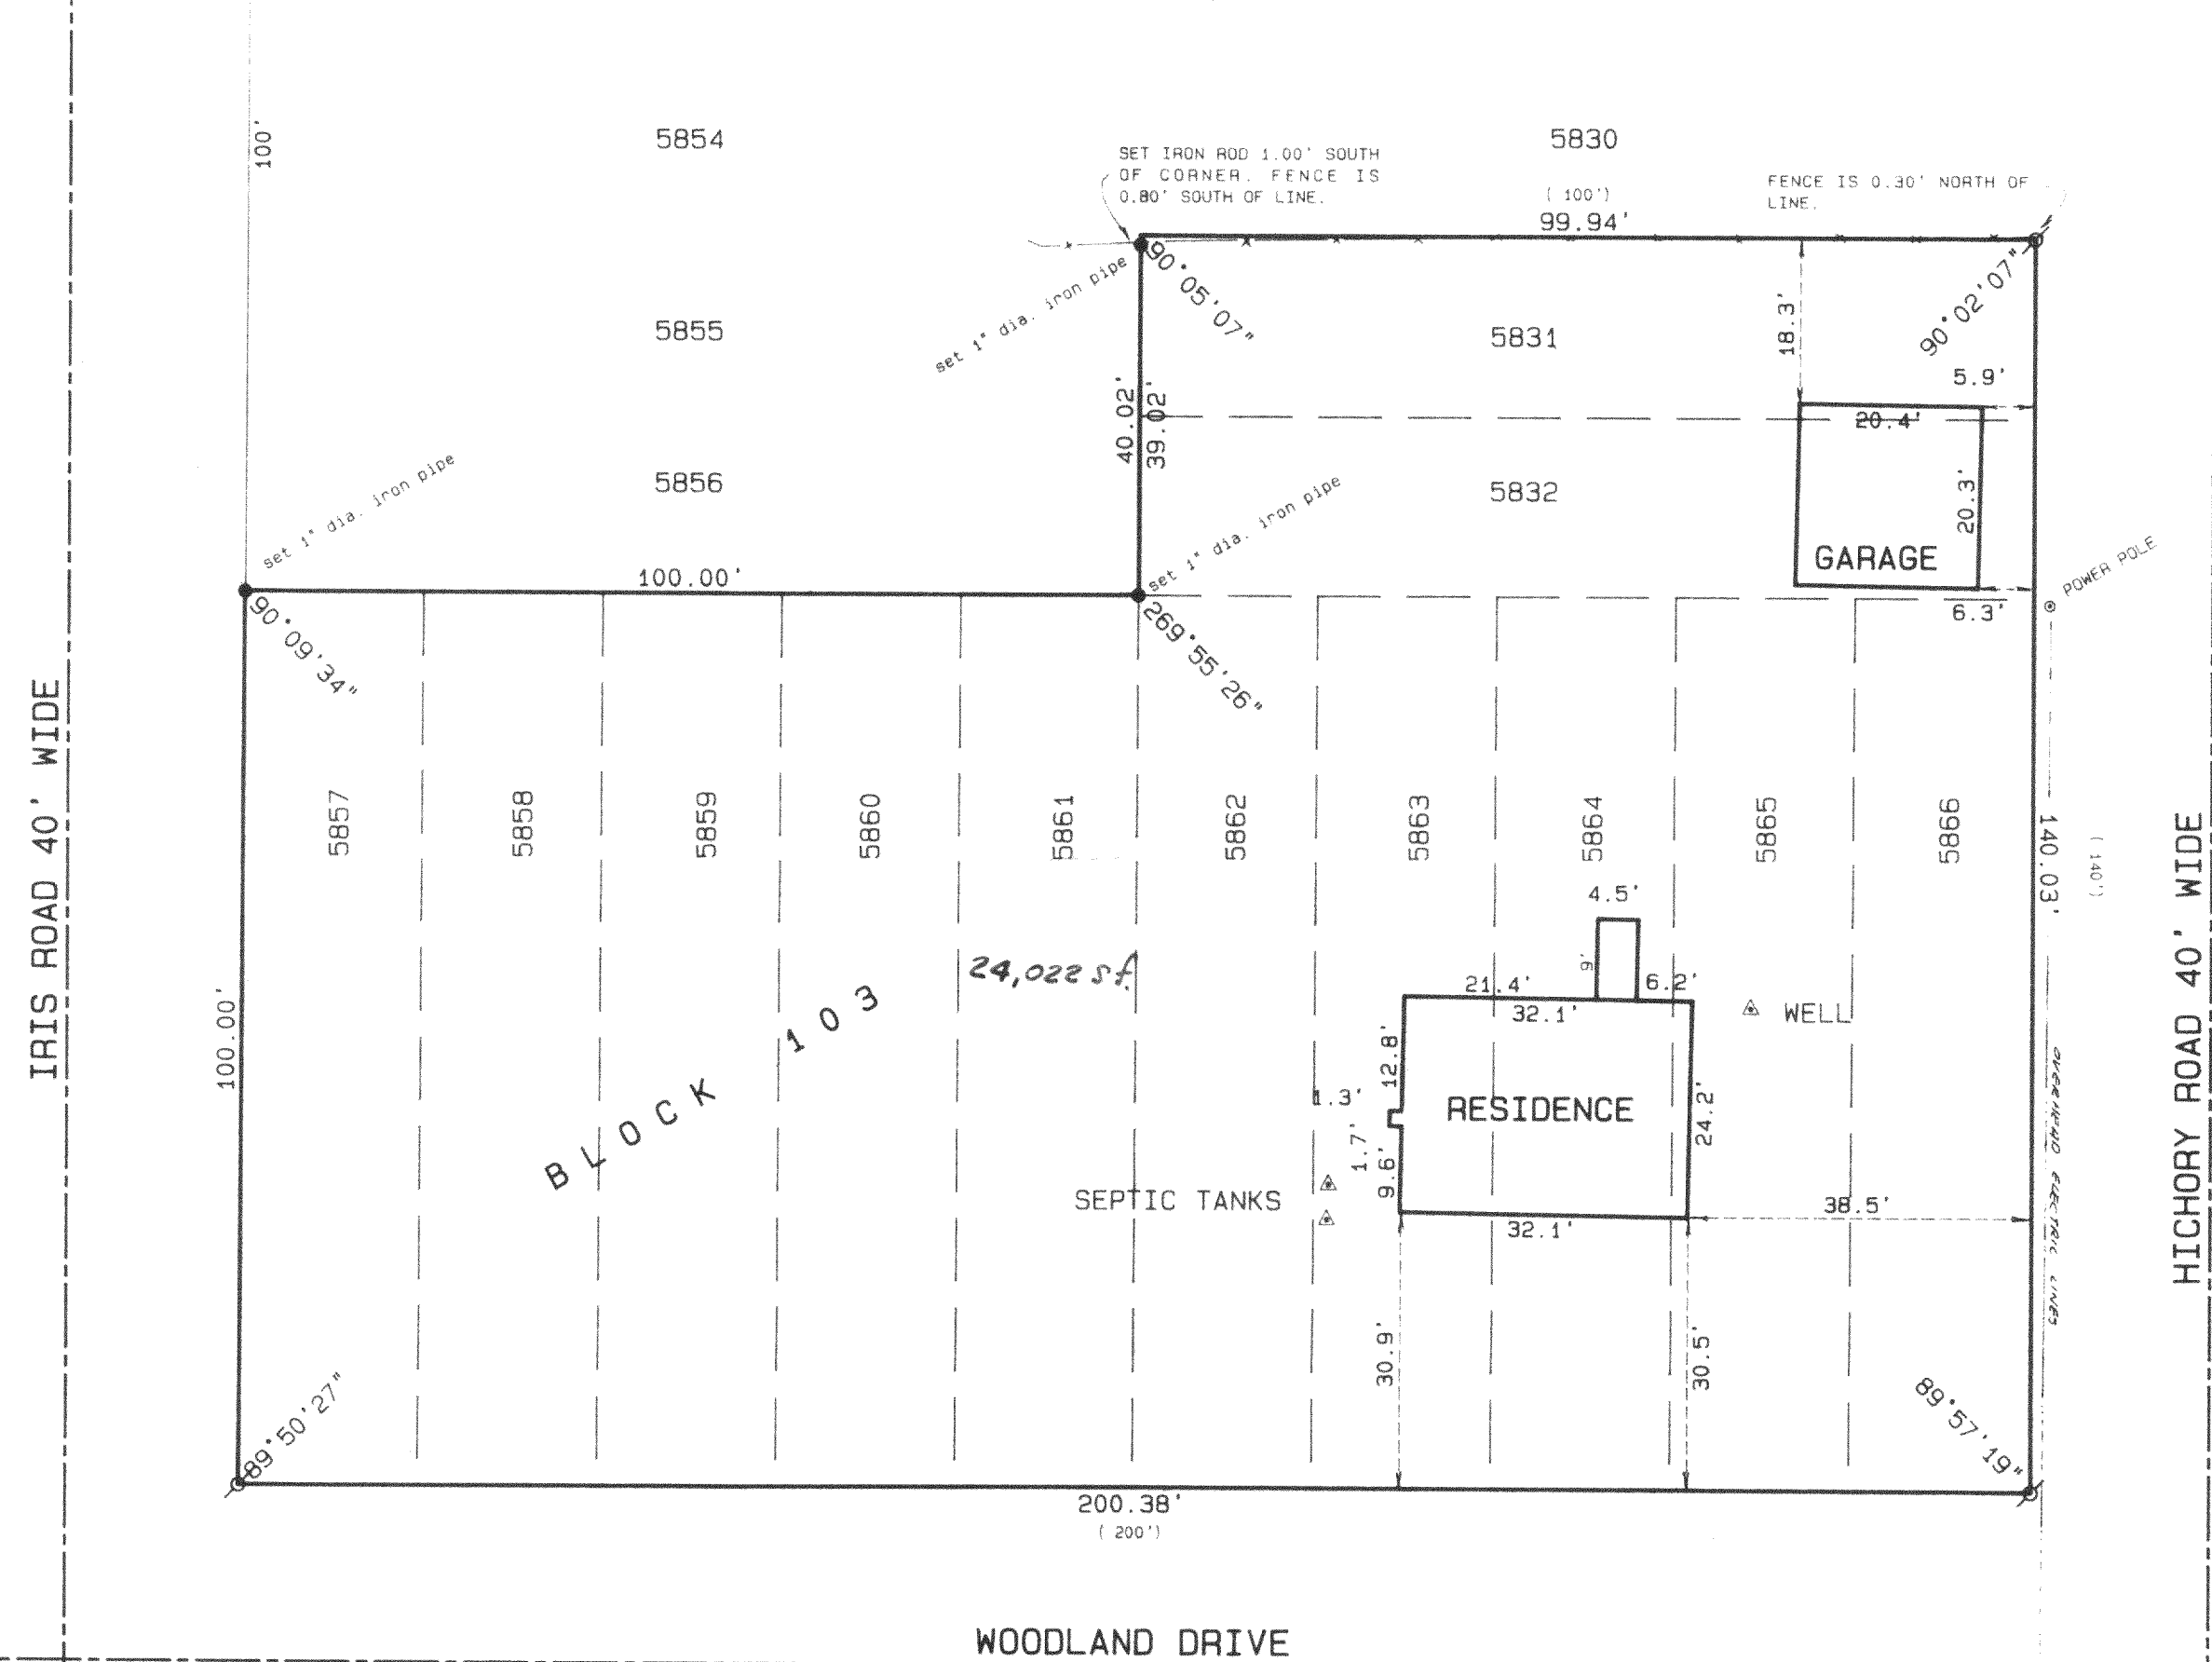

SCALE 1" = 20 FEET

Legend

- * FOUND IRON PIPE
 ● FOUND IRON ROD
 ○ FOUND BRASS CAPPED MONUMENT
 * FOUND CONCRETE MONUMENT
 + CHISEL CUT IN CONCRETE
 ● SET IRON ROD, 24" LONG, WEIGHING
 1.5 LBS. LINEAL FT., 3/4" DIA.
 ● SET IRON ROD, 30" LONG, WEIGHING
 4.5 LBS. LINEAL FT., 1-11/16" DIA.
 (xx) RECORDED AS DIMENSION
 ---x---x---x---
 EXISTING FENCE

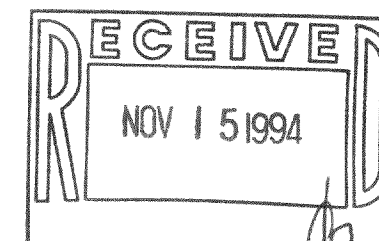

SCALE: 1" = 20 FEET

"I hereby certify that I have surveyed the above described property and that the above map is a true representation thereof and shows the size and location of the property, its exterior boundaries, the location of all visible structures and dimensions of all principal buildings thereon, boundary fences, apparent easements, roadways and visible encroachments, if any."

"This survey is made for the use of the present owners of the property, and also those who purchase, mortgage, or guarantee the title thereto within one year from date hereof."

KENNETH B. ABERNATHY, JR.
WISCONSIN REGISTERED LAND SURVEYOR,

Date: 9-19-94 Job No. 94.907

 $217 + 125$