


WALWORTH COUNTY
SURVEYING & MAPPING
727 HENRY STREET
LAKE GENEVA, WISCONSIN
414-248-0505

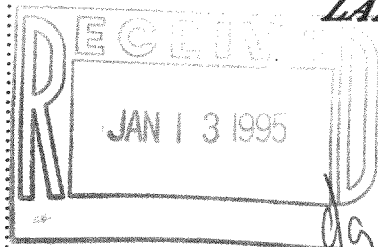

PLAT OF SURVEY OF

LOTS 917, 950-953 AND THE SOUTH 20 FEET OF LOTS 912-916,
BLOCK 16 OF LAKE COMO BEACH SUBDIVISION, LOCATED IN SECTION
22, T 2 N, R 17 E, WALWORTH COUNTY, WISCONSIN.

ALSO, ALL THAT PART OF THE SOUTH 1/2 OF SECTION 22, T 2 N,
R 17 E, WALWORTH COUNTY, WISCONSIN, DESCRIBED AS FOLLOWS:
COMMENCING AT THE NORTHEAST CORNER OF LOT 917 IN LAKE
COMO BEACH SUBDIVISION; THENCE N75°51'13"W, ASSUMED
BEARING, 103.17 FEET; THENCE SOUTH 26.25 FEET; THENCE
N89°24'00"E 100.00 FEET TO THE PLACE OF COMMENCEMENT.

ALSO, ALL THAT PART OF LOTS 912-916 IN LAKE COMO BEACH
SUBDIVISION, BEING A PART OF THE SOUTH 1/2 OF SECTION 22,
IN T 2 N, R 17 E IN THE TOWN OF GENEVA, WALWORTH COUNTY,
WISCONSIN, DESCRIBED AS FOLLOWS: COMMENCING AT A POINT
IN THE EAST LINE OF LOT 912, 20 FEET NORTH OF THE SOUTHEAST
CORNER OF SAID LOT 912; THENCE DUE NORTH, ASSUMED BEARING,
ON SAID EAST LINE OF LOT 912, 26.25 FEET; THENCE N75°06'06"W
79.80 FEET; THENCE S25°34'09.2"W 53.00 FEET TO A POINT IN
THE NORTH LINE OF THE SOUTH 20 FEET OF SAID LOTS 912-916;
THENCE N89°24'00"E 100.00 FEET, ALONG SAID NORTH LINE TO
THE PLACE OF COMMENCEMENT.

ORDERED BY: KEEFE REAL ESTATE
704 MAIN STREET
LAKE GENEVA, WISCONSIN
53147

I HEREBY CERTIFY THAT I HAVE SURVEYED THE ABOVE DESCRIBED
PROPERTY AND THAT THE ABOVE MAP IS A TRUE REPRESENTATION
THEREOF AND SHOWS THE SIZE AND LOCATION OF THE PROPERTY,
ITS EXTERIOR BOUNDARIES, THE LOCATION OF ALL VISIBLE STRUCTURES
AND DIMENSIONS OF ALL PRINCIPAL BUILDINGS THEREON, BOUNDARY
FENCES, APPARENT EASEMENTS, ROADWAYS AND VISIBLE ENCROACH-
MENTS, IF ANY, TO THE BEST OF MY KNOWLEDGE AND BELIEF.

THIS SURVEY IS MADE FOR THE USE OF THE PRESENT OWNERS OF
THE PROPERTY AND ALSO THOSE WHO PURCHASE, MORTGAGE OR
GUARANTEE THE TITLE THERETO WITHIN ONE (1) YEAR FROM DATE
HEREOF.

Robert M. Baerenwald
ROBERT M. BAERENWALD
WISCONSIN REGISTERED LAND SURVEYOR, S-1508


April 18, 1994
DATE JOB NO. 4214

NOTE: THIS IS NOT A CERTIFIED COPY UNLESS SEALED.

NOTE: DOTTED LINES DENOTE
ORIGINAL LOT LINES



σ-IRON PIPE FOUND
()-RECORDED AS

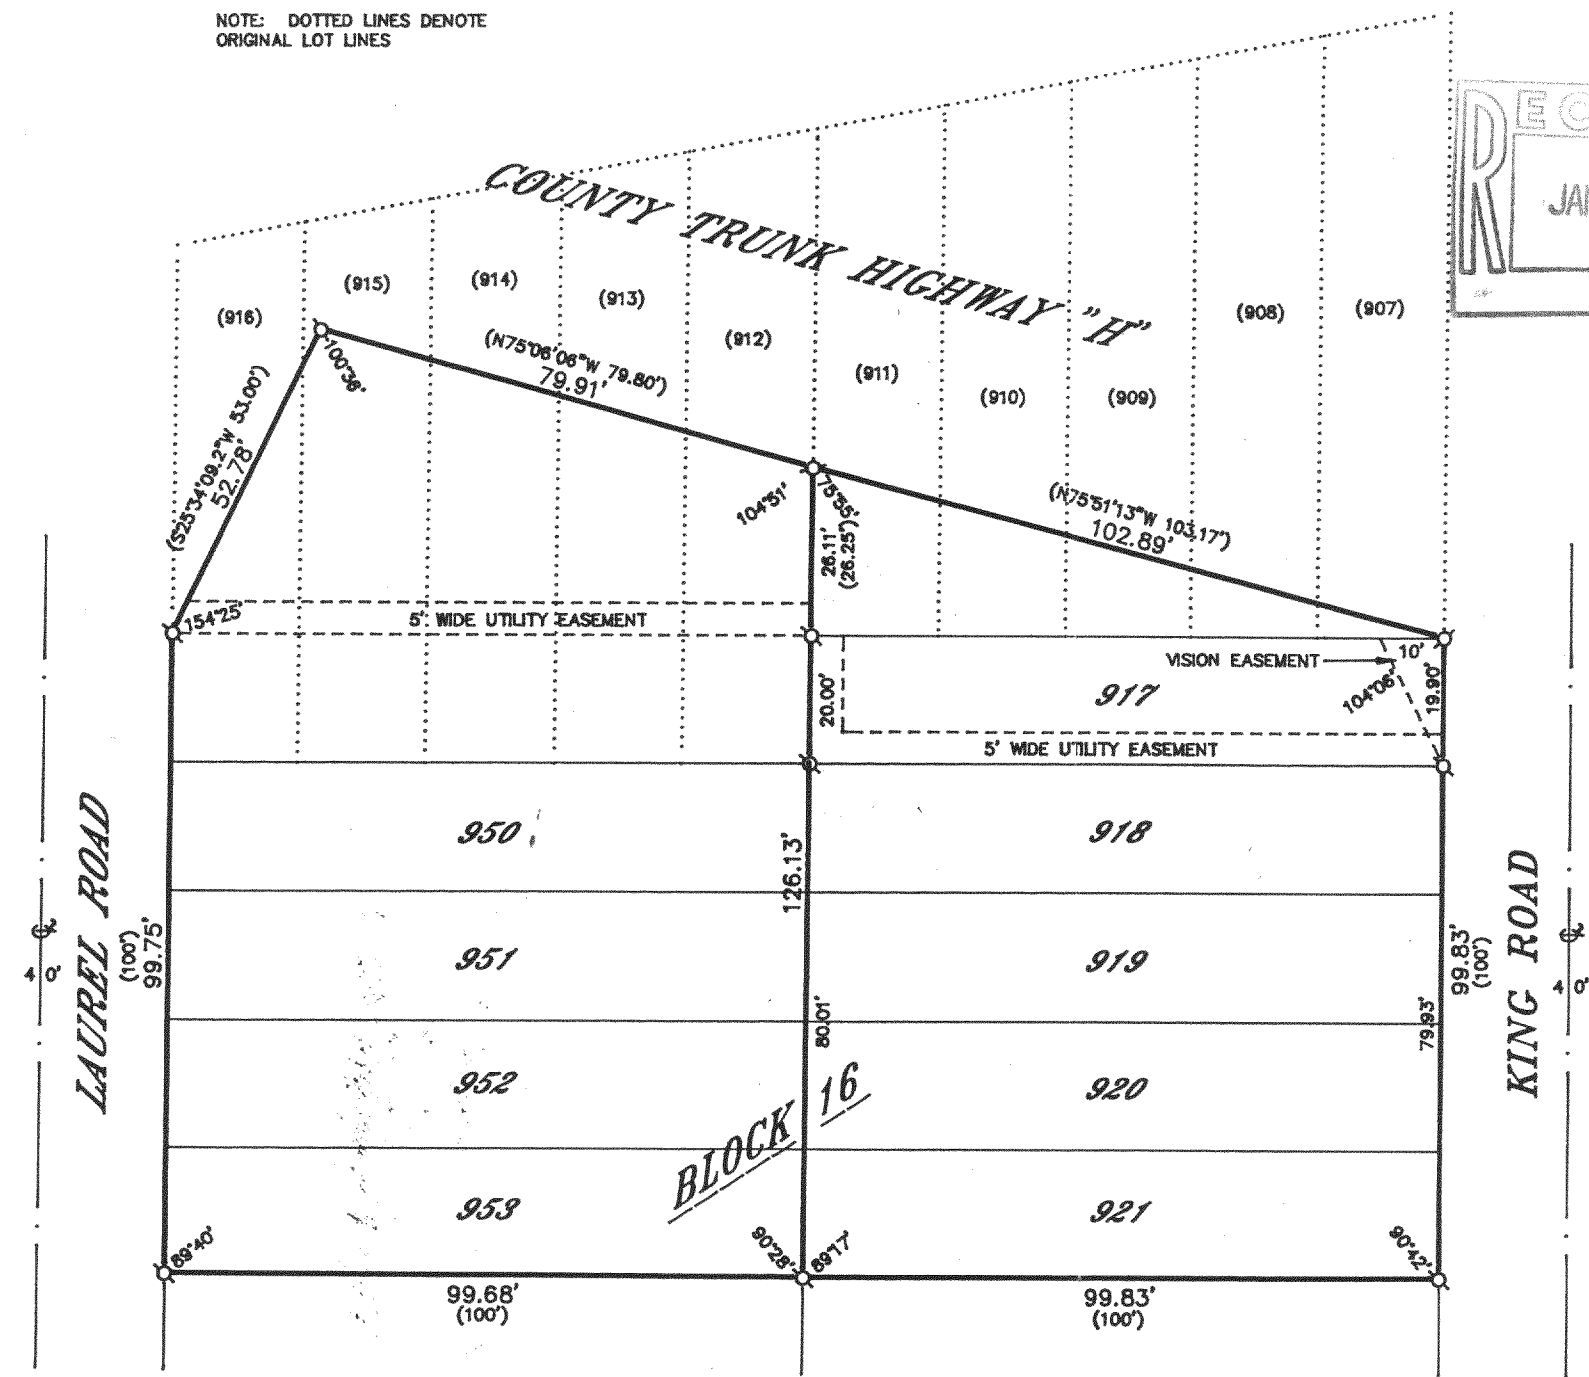

GRAPHIC SCALE



(IN FEET)
1 inch = 30 ft.

JLCB-102

217-1279