


PLAT OF SURVEY

LOTS 6816 - 6820, 6852, AND
6853 OF BLOCK 117 OF LAKE COMO
BEACH SUBDIVISION, LOCATED IN
TOWN 2 NORTH, RANGE 17 EAST,
WALWORTH COUNTY, WISCONSIN.


THIS PARCEL CONTAIN 13,984
S.F. OF LAND.

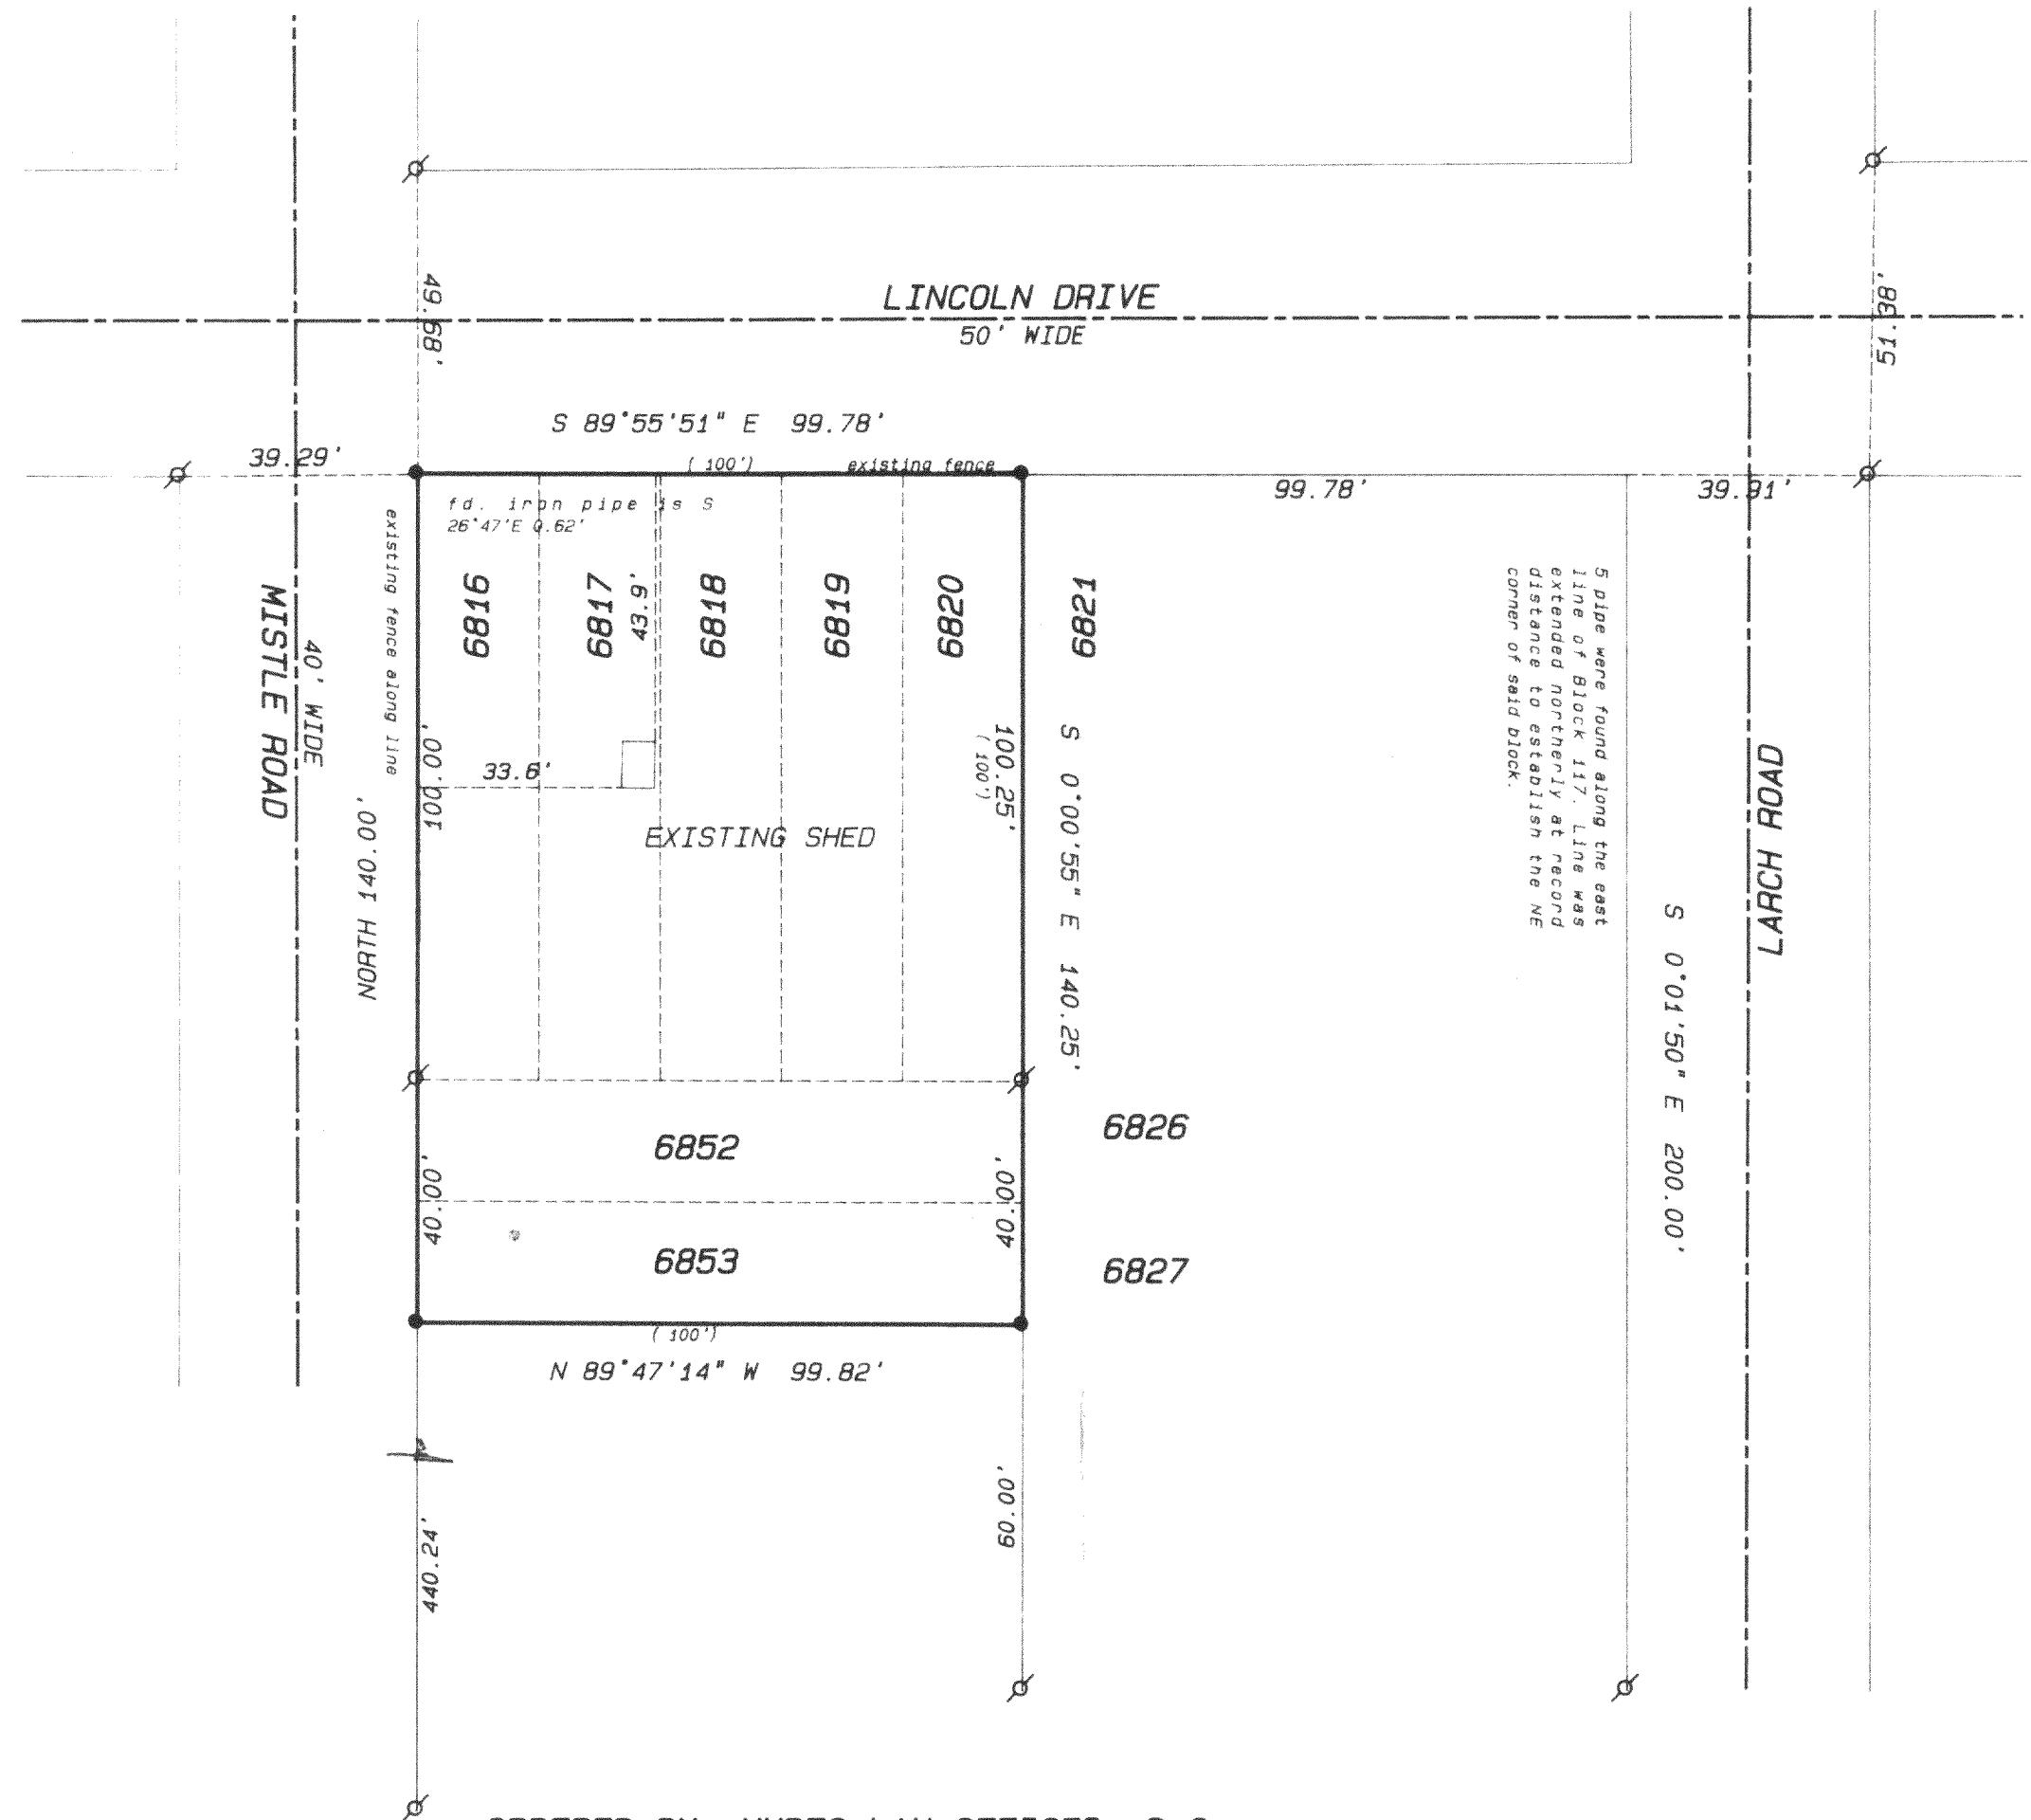

THE WEST LINE OF
BLOCK 117 WAS ASSUMED
TO BEAR NORTH.

SCALE 1" = 30 FEET


- Legend
- FOUND IRON PIPE
 - FOUND IRON ROD
 - FOUND BRASS CAPPED MONUMENT
 - FOUND CONCRETE MONUMENT
 - CHISEL CUT IN CONCRETE
 - SET IRON ROD, 24" LONG, WEIGHING 1.5 LBS./LINEAL FT., 3/4" DIA.
 - SET IRON ROD, 30" LONG, WEIGHING 4.5 LBS./LINEAL FT., 1-11/16" DIA.
 - RECORDED AS DIMENSION
 - EXISTING FENCE

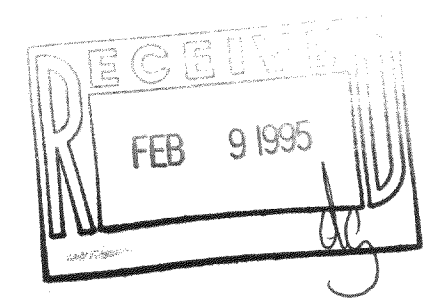

ORDERED BY: HUDEC LAW OFFICES, S.C.
721 GENEVA ST.
LAKE GENEVA, WI. 53147

OWNER: FRANK STEIGERWALD
2158 N. PARKSIDE
CHICAGO, ILL. 60639

SCALE: 1"= 30 FEET

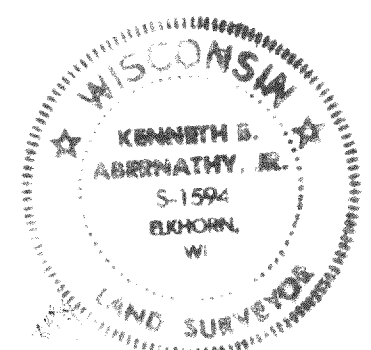

I hereby certify that the above described property has been surveyed by me or under my direction and that the above map is a true representation thereof and shows the size and location of the property, its exterior boundaries, the location of all visible structures and dimensions of all principal buildings thereon, boundary fences, apparent easements, roadways and visible encroachments, if any.

This survey is made for the use of the present owners of the property, and also those who purchase, mortgage, or guarantee the title thereto within one year from date hereof.

Kenneth B. Abernathy, Jr.
KENNETH B. ABERNATHY, JR.
WISCONSIN REGISTERED LAND SURVEYOR,
S-1594
Date: 12-2-94 Job No. 94.1112