



PLAT OF SURVEY

LOTS 6671, 6672, AND 6673 OF LAKE COMO BEACH SUBDIVISION,
LOCATED IN SECTION 28, TOWN 2 NORTH, RANGE 17 EAST, WALWORTH
COUNTY, WISCONSIN

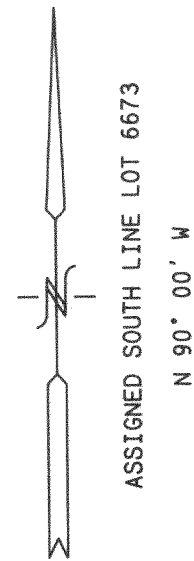


LARCH ROAD 40' WIDE

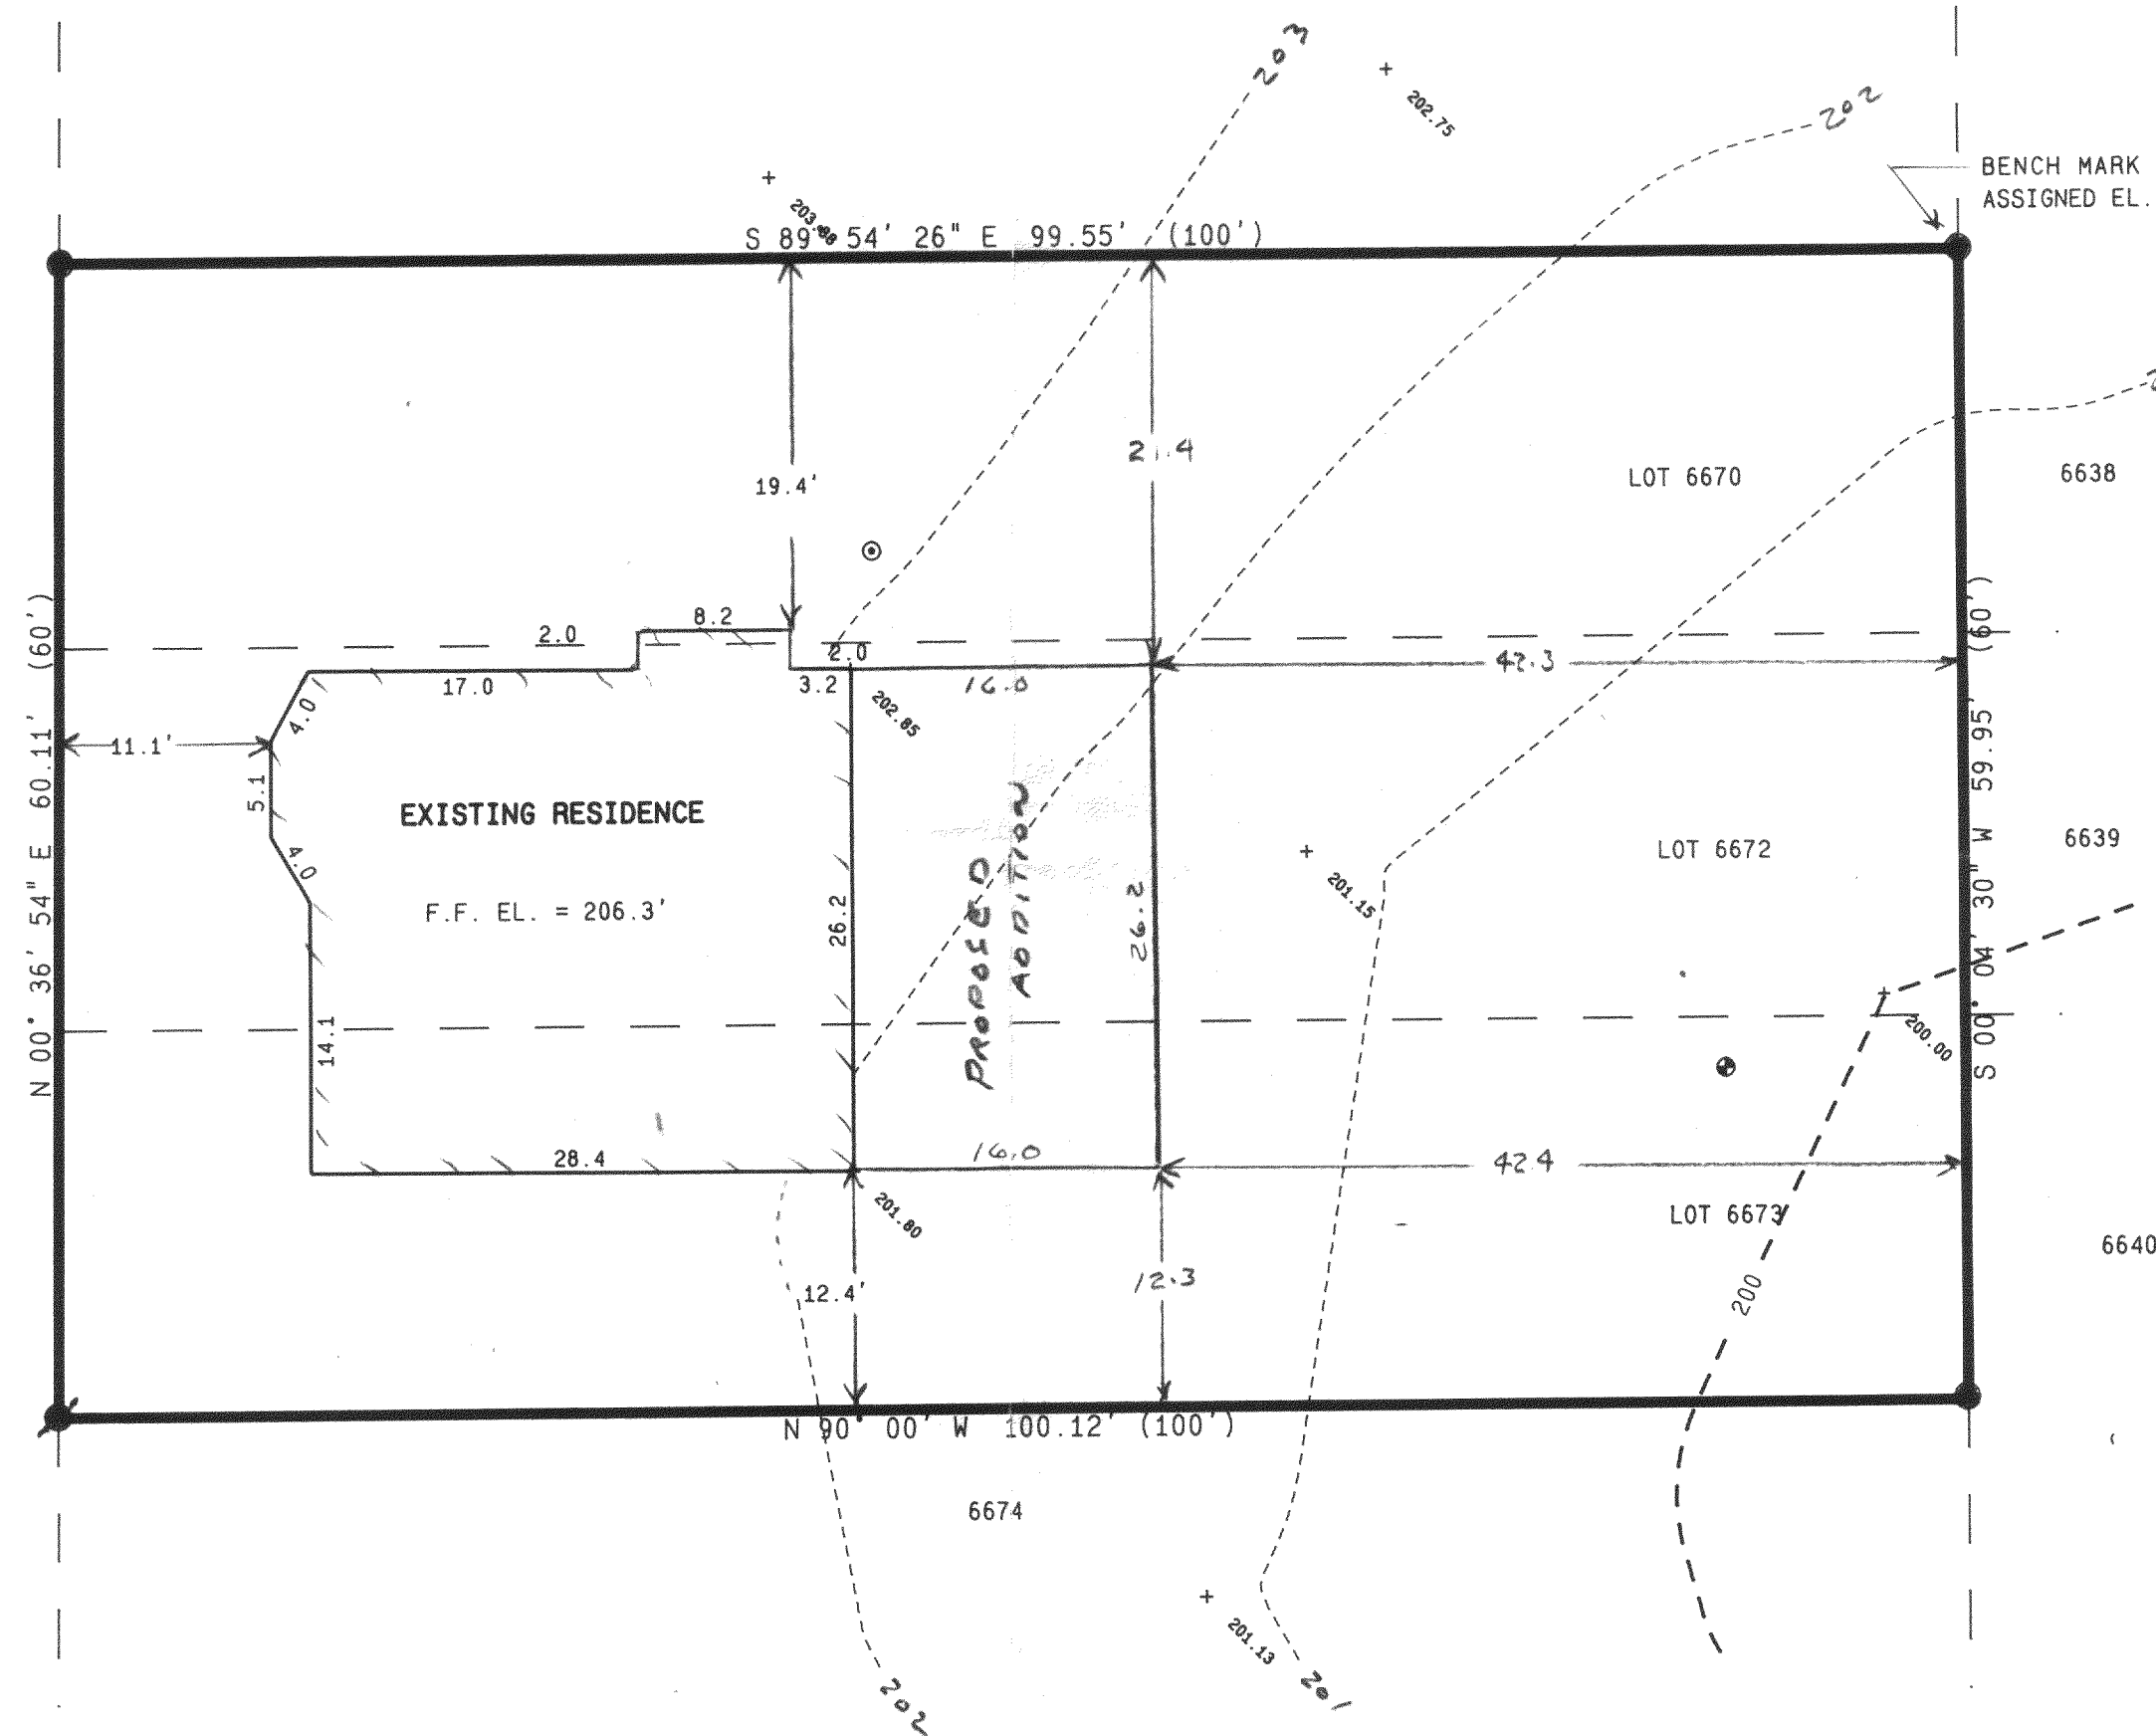

- LEGEND
- = FOUND IRON PIPE STAKE
 - ⦿ = FOUND IRON REBAR STAKE
 - ⊙ = SANITARY SYSTEM COVER
 - ⊕ = WELL
 - (x x x) = RECORDED AS

NOTE ICE ELEVATION OF LAKE COMO
ON DATE OF SURVEY = 181.0'

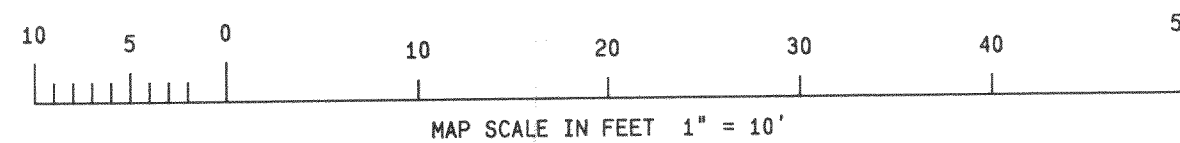


NOTE: COPIES OF THIS MAP TO WHICH THE FOLLOWING
CERTIFICATE WILL APPLY ARE BLUE LINE PRINTS SHOWING
SURVEYOR'S ORIGINAL SEAL AND SIGNATURE IN BLACK INK.
COPIES BY ANY OTHER MEANS MAY HAVE ALTERATIONS WHICH
DO NOT REPRESENT THE SURVEYOR'S WORK PRODUCT.

I HEREBY CERTIFY THAT THE ABOVE DESCRIBED PROPERTY
HAS BEEN SURVEYED UNDER MY DIRECTION AND THAT THE
ABOVE MAP IS A TRUE REPRESENTATION THEREOF AND SHOWS
THE SIZE AND LOCATION OF THE PROPERTY AND ITS
EXTERIOR BOUNDARIES. THIS SURVEY IS MADE FOR THE
USE OF THE PRESENT OWNERS OF THE PROPERTY, AND ALSO
THOSE WHO PURCHASE, MORTGAGE, OR GUARANTEE THE TITLE
THERE TO WITHIN ONE YEAR FROM THE DATE HEREOF.

DATED: 2-13-95



PETER S. GORDON R.L.S. 2101

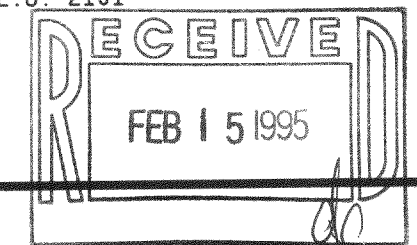

WORK ORDERED BY: KEN WOLLER
455 E. GENEVA STREET
ELKHORN, WISCONSIN

FARRIS, HANSEN & ASSOCIATES, INC.
Engineering, Architecture, Surveying
7 Ridgway Court P.O. Box 437
ELKHORN, WISCONSIN 53121
Office: (414) 723-2098
Fax: (414) 723-5886

REVISIONS

PROJECT NO.
4259
DATE
02-13-95
SHEET NO.
1 OF 1

JLCB-1397

217-1299