




DUNHAM SURVEYING, S.C.  
SURVEYING & SUBDIVIDING  
DELAVER, WISCONSIN 53115

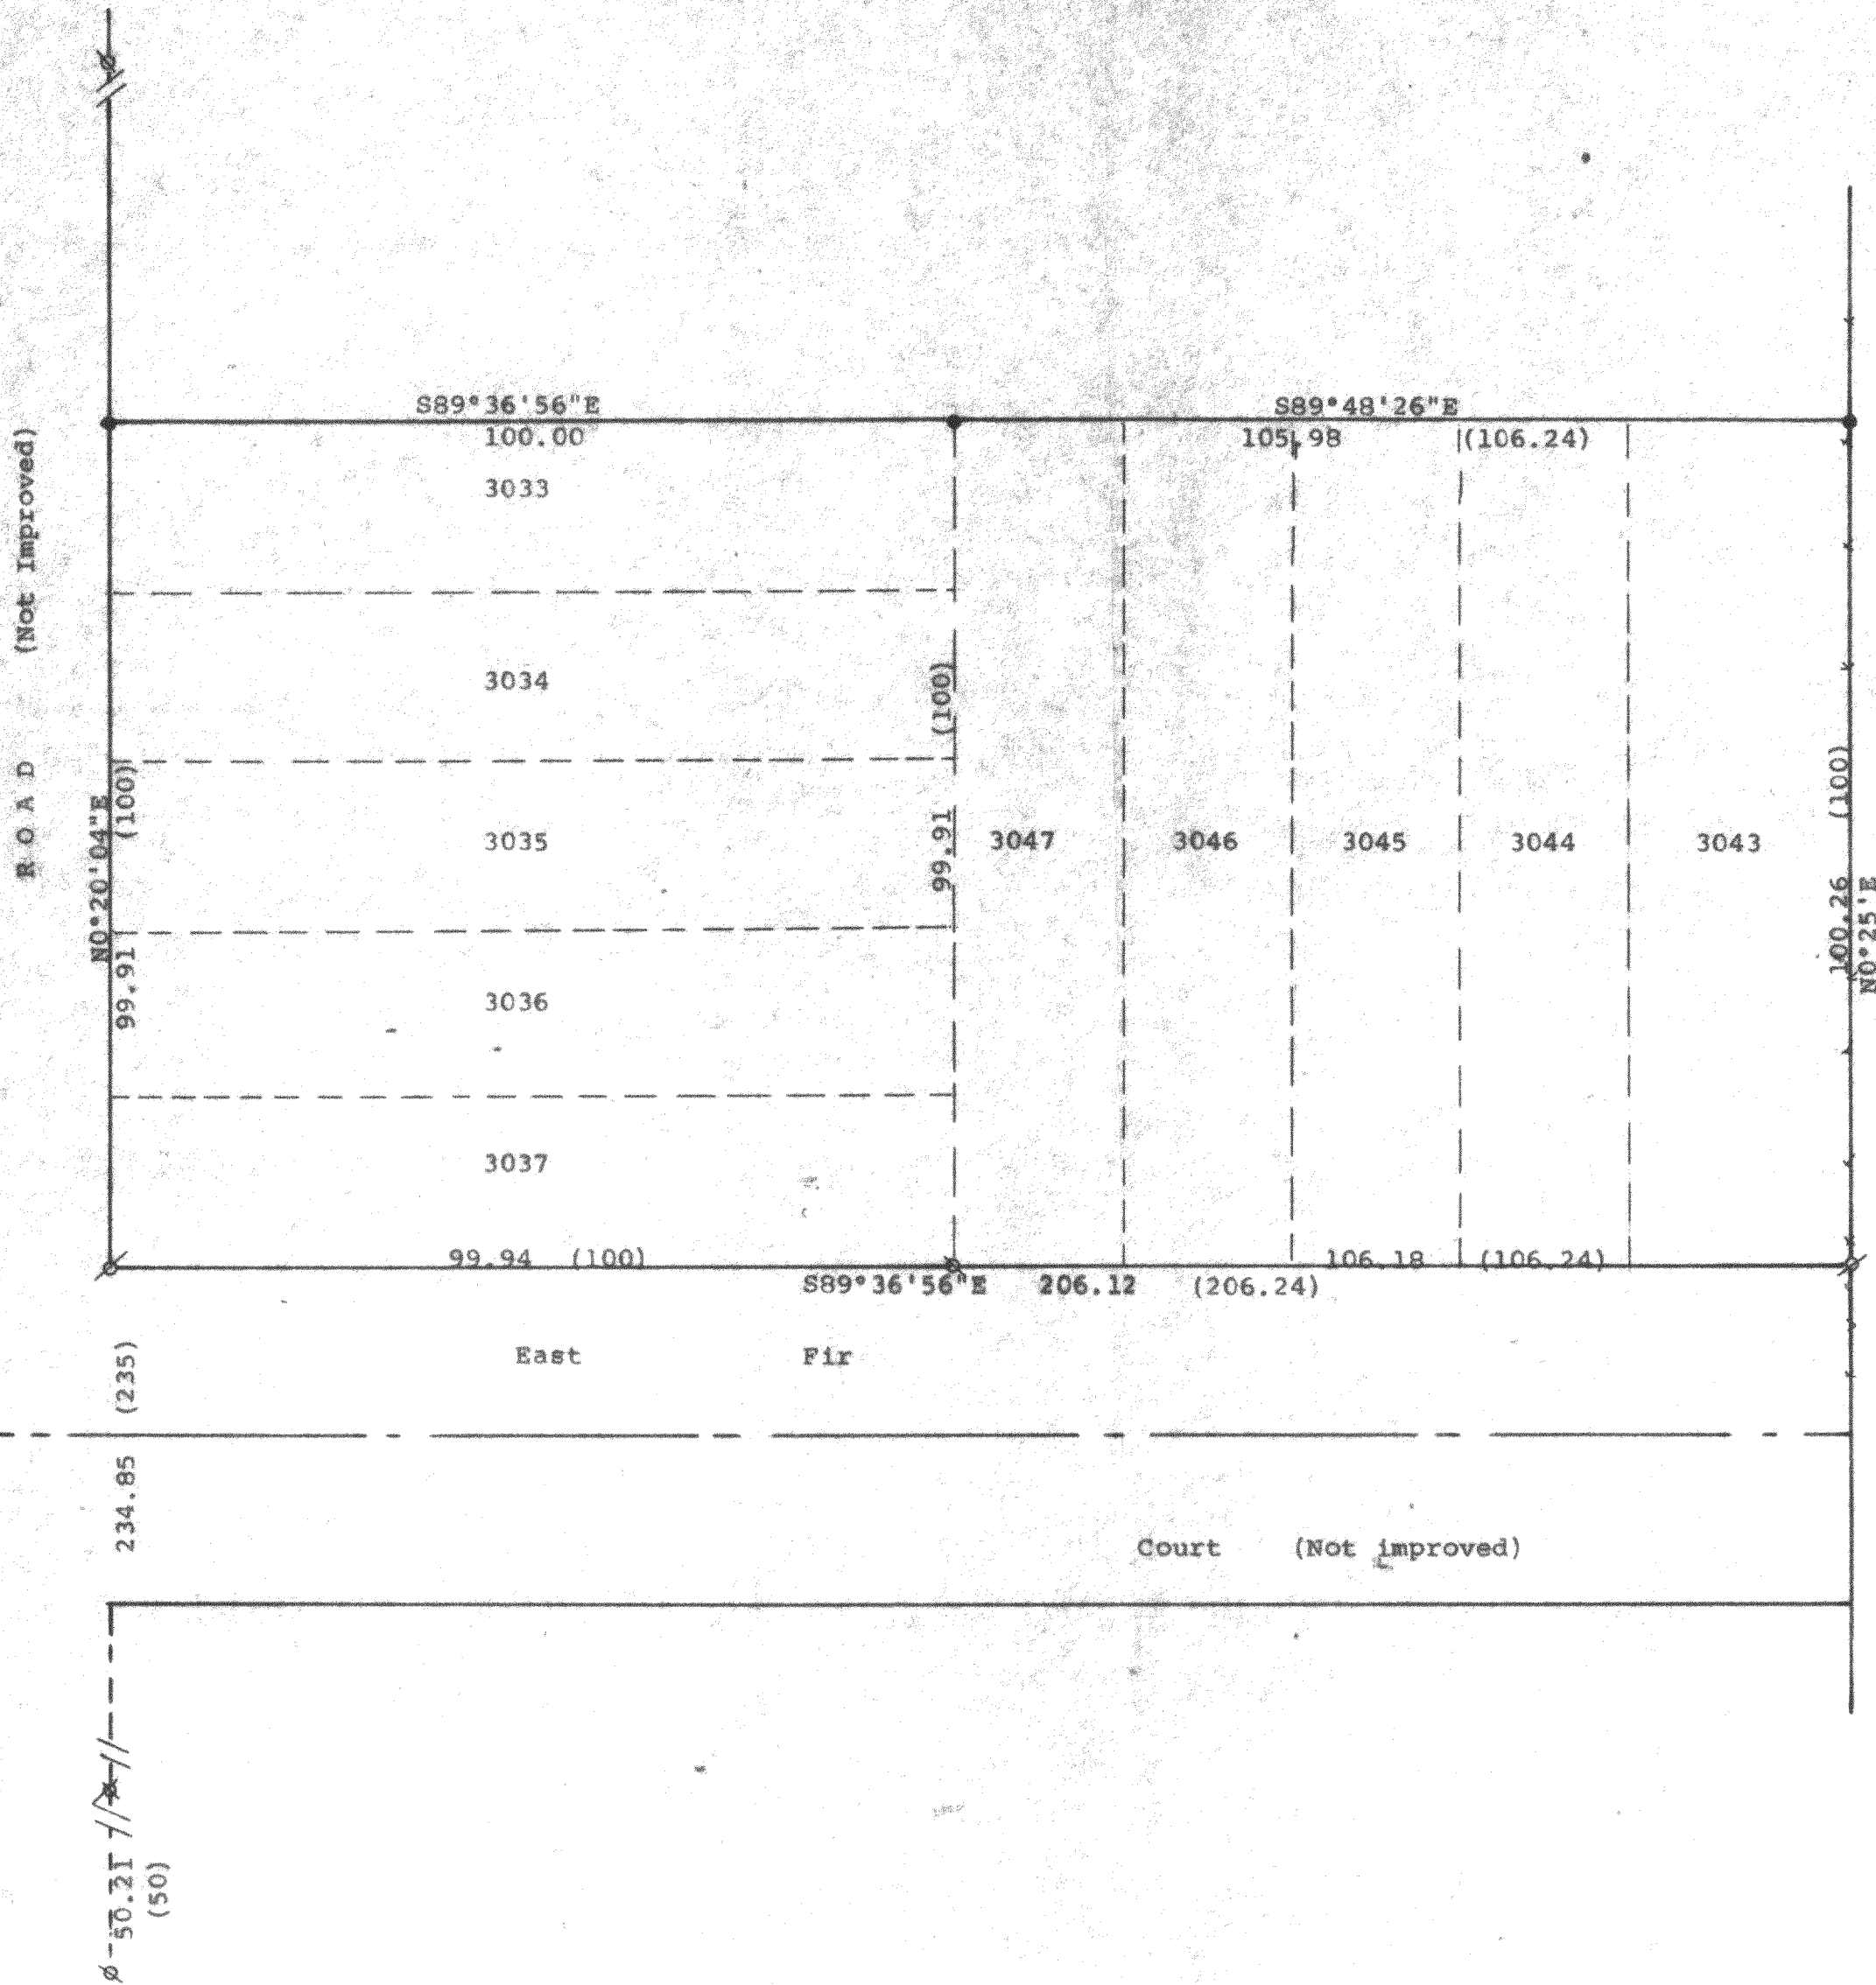

Scale - 1" = 20'  
 ● = 2" Iron Pipe Found  
 ○ = 1 1/2" Iron Pipe Found  
 ○ = 1" Iron Pipe Found  
 X = 3/4" Iron Pipe Set  
 X = 1/2" Iron Pipe Found  
 --- = Old Fence Line  
 Bearings referenced to the re-  
 corded bearing of  $N0^{\circ}20'04''E$  along  
 the east line of University Road  
 Survey ordered by:  
 Lake Geneva Properties  
 816 Williams Street  
 Lake Geneva, WI 53147  
 (0.00) = recorded distance

STATE OF WISCONSIN) ss  
 COUNTY OF WALWORTH)  
 I, George T. Dunham, Surveyor, certify that I have surveyed the property  
 described as follows:  
 Lots 3033-3037 inclusive and Lots 3043-3047 inclusive in Block 54 of  
 Lake Como Beach Subdivision, Town of Geneva, Walworth County, Wisconsin  
 and that the plat shown hereon is a correct representation thereof and shows  
 the size and location of the property, its exterior boundaries, the location  
 of all visible structures and dimensions of all principal buildings thereon,  
 boundary fences, apparent easements, roadways and visible encroachments, if  
 any, and that I have surveyed the property hereon described, according to the  
 official records, to the best of my knowledge and belief.  
 March 29, 1994

*George T. Dunham*  
 George T. Dunham, Surveyor

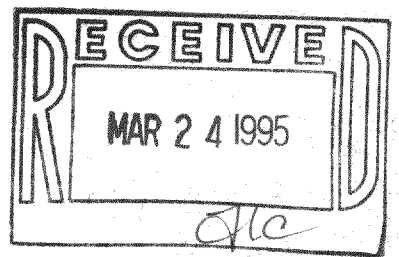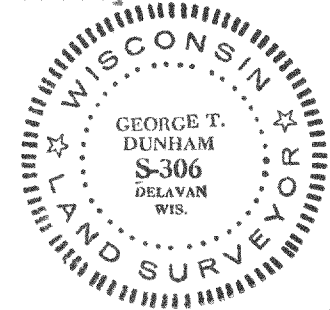

JLB-549  
 JLB-544

217-1302