

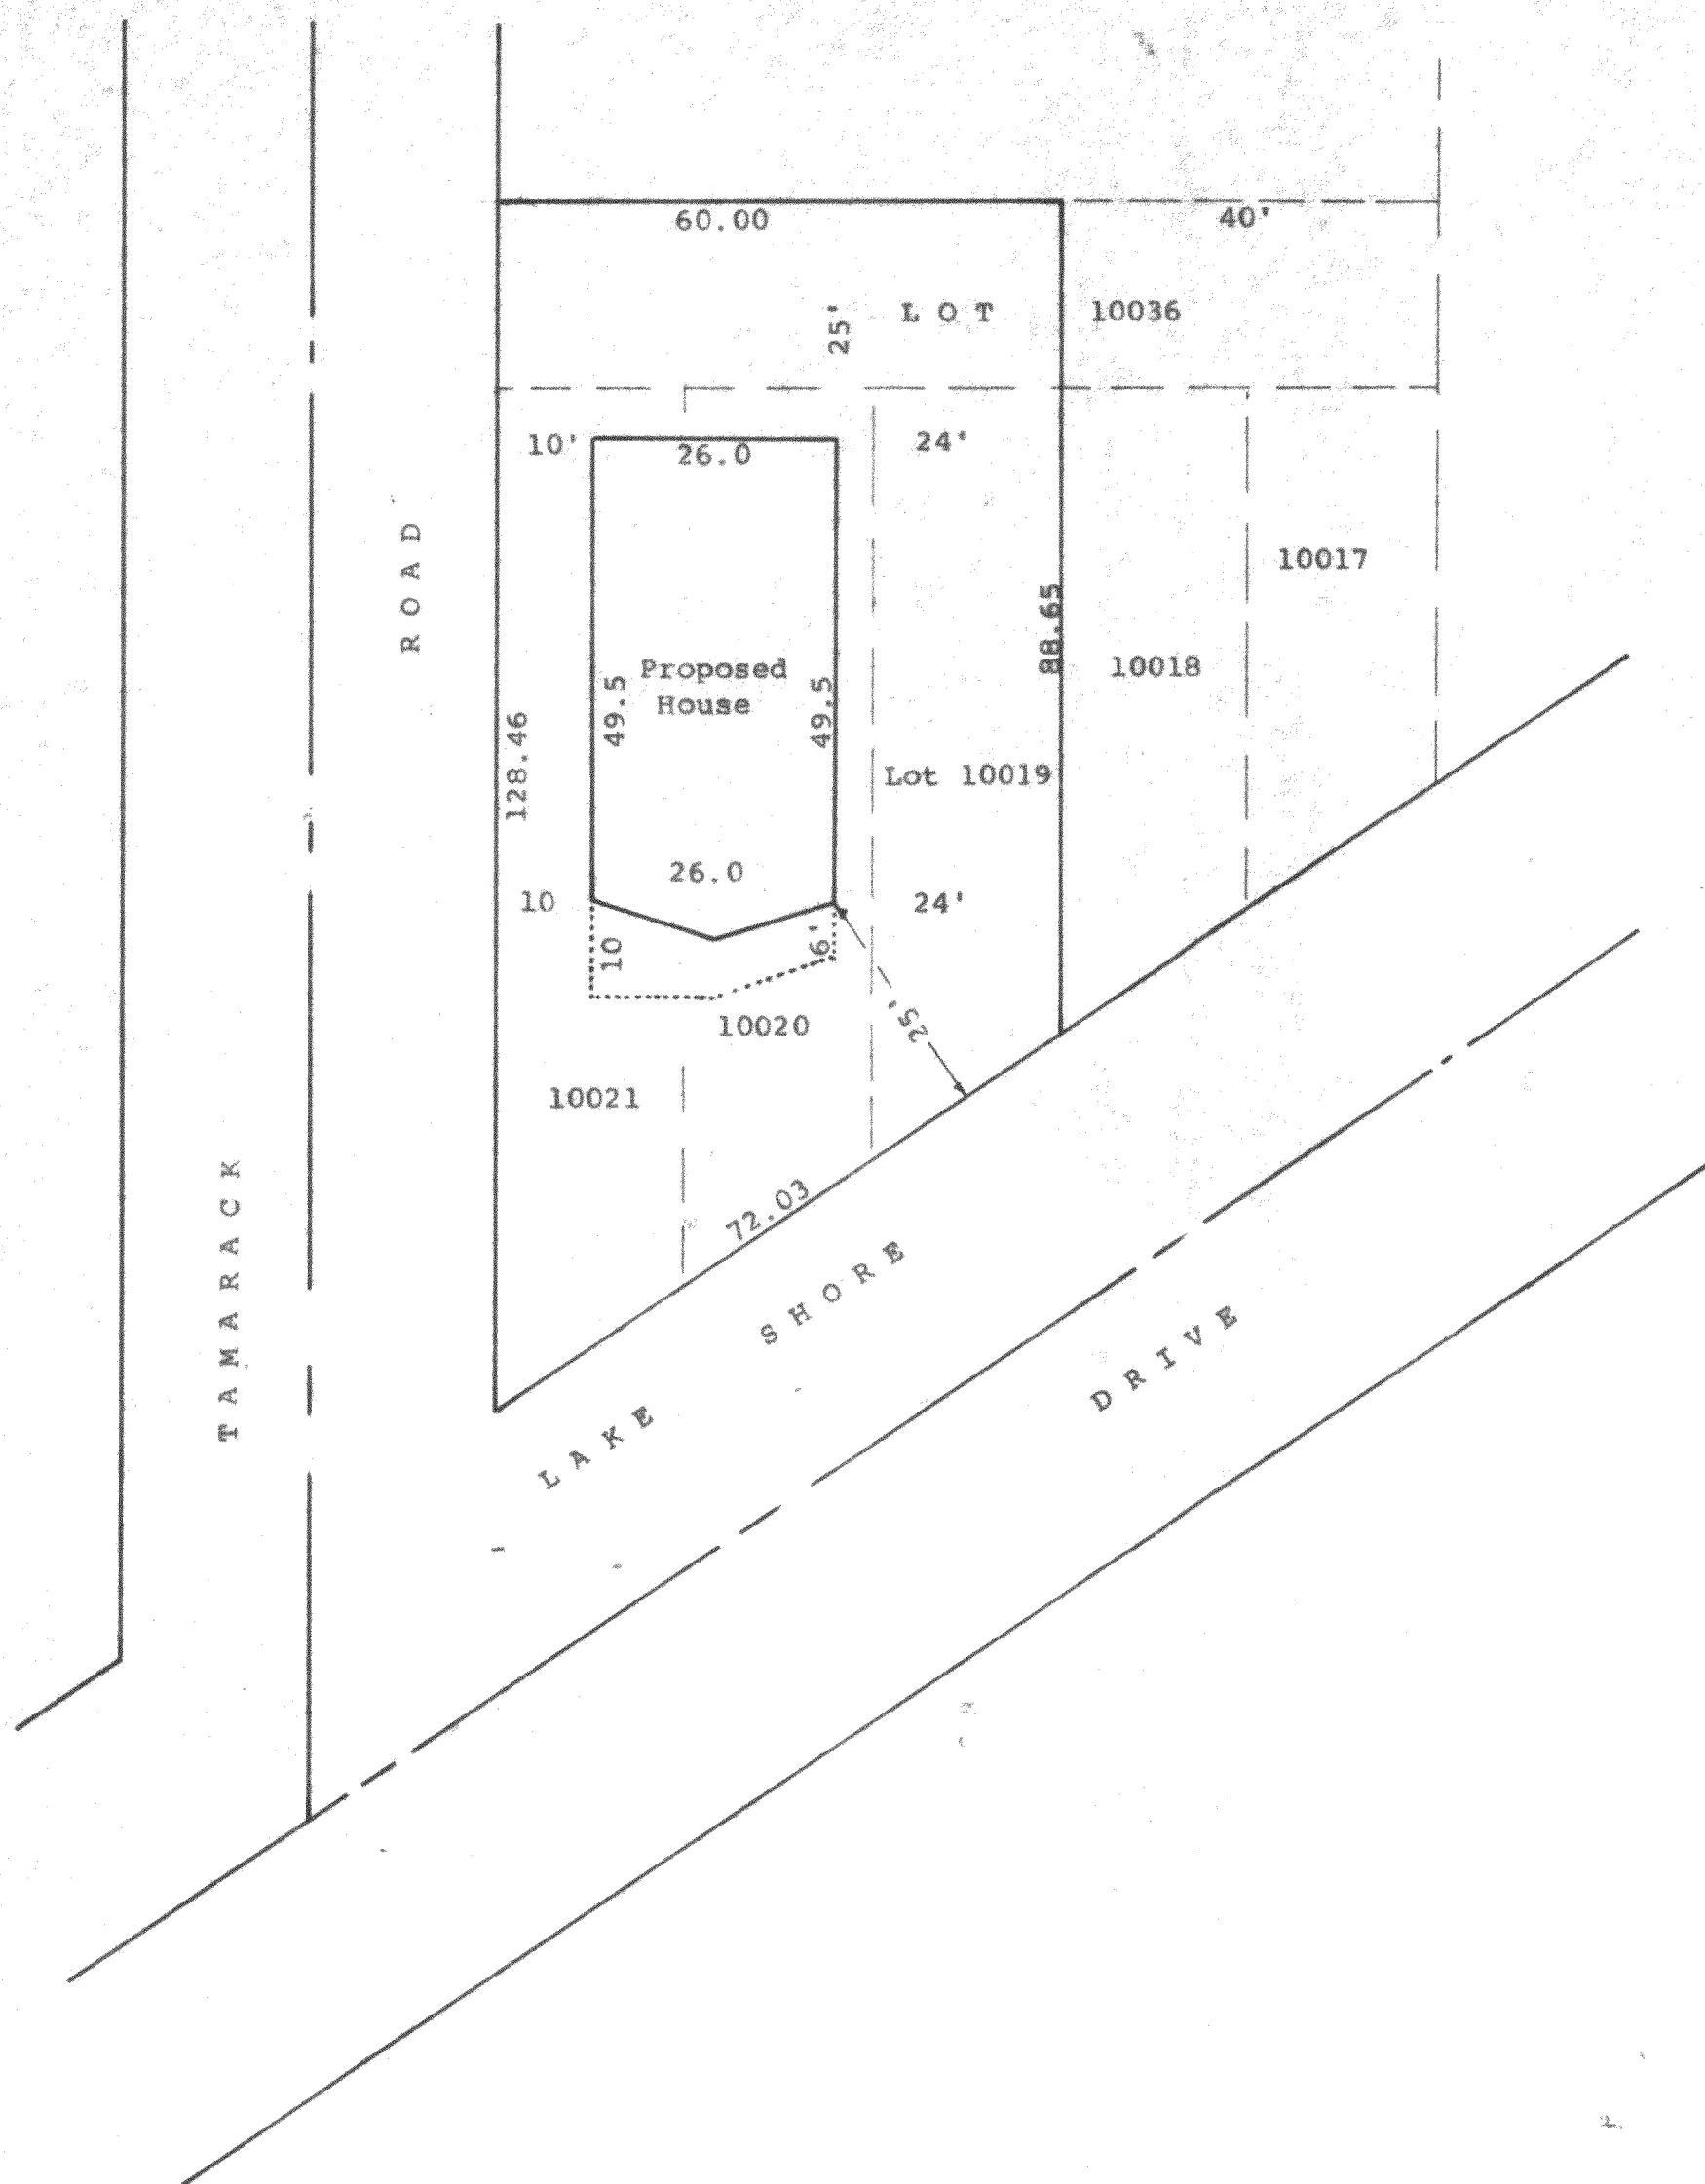


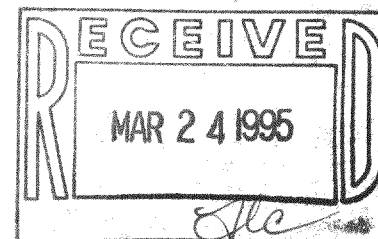


Scale - 1" = 20'

George T. Dunham
George T. Dunham, Surveyor

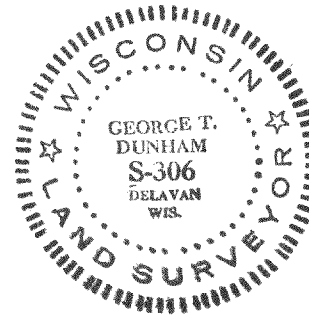

DUNHAM SURVEYING, S.C.
SURVEYING & SUBDIVIDING
DELAYAN, WISCONSIN 53115


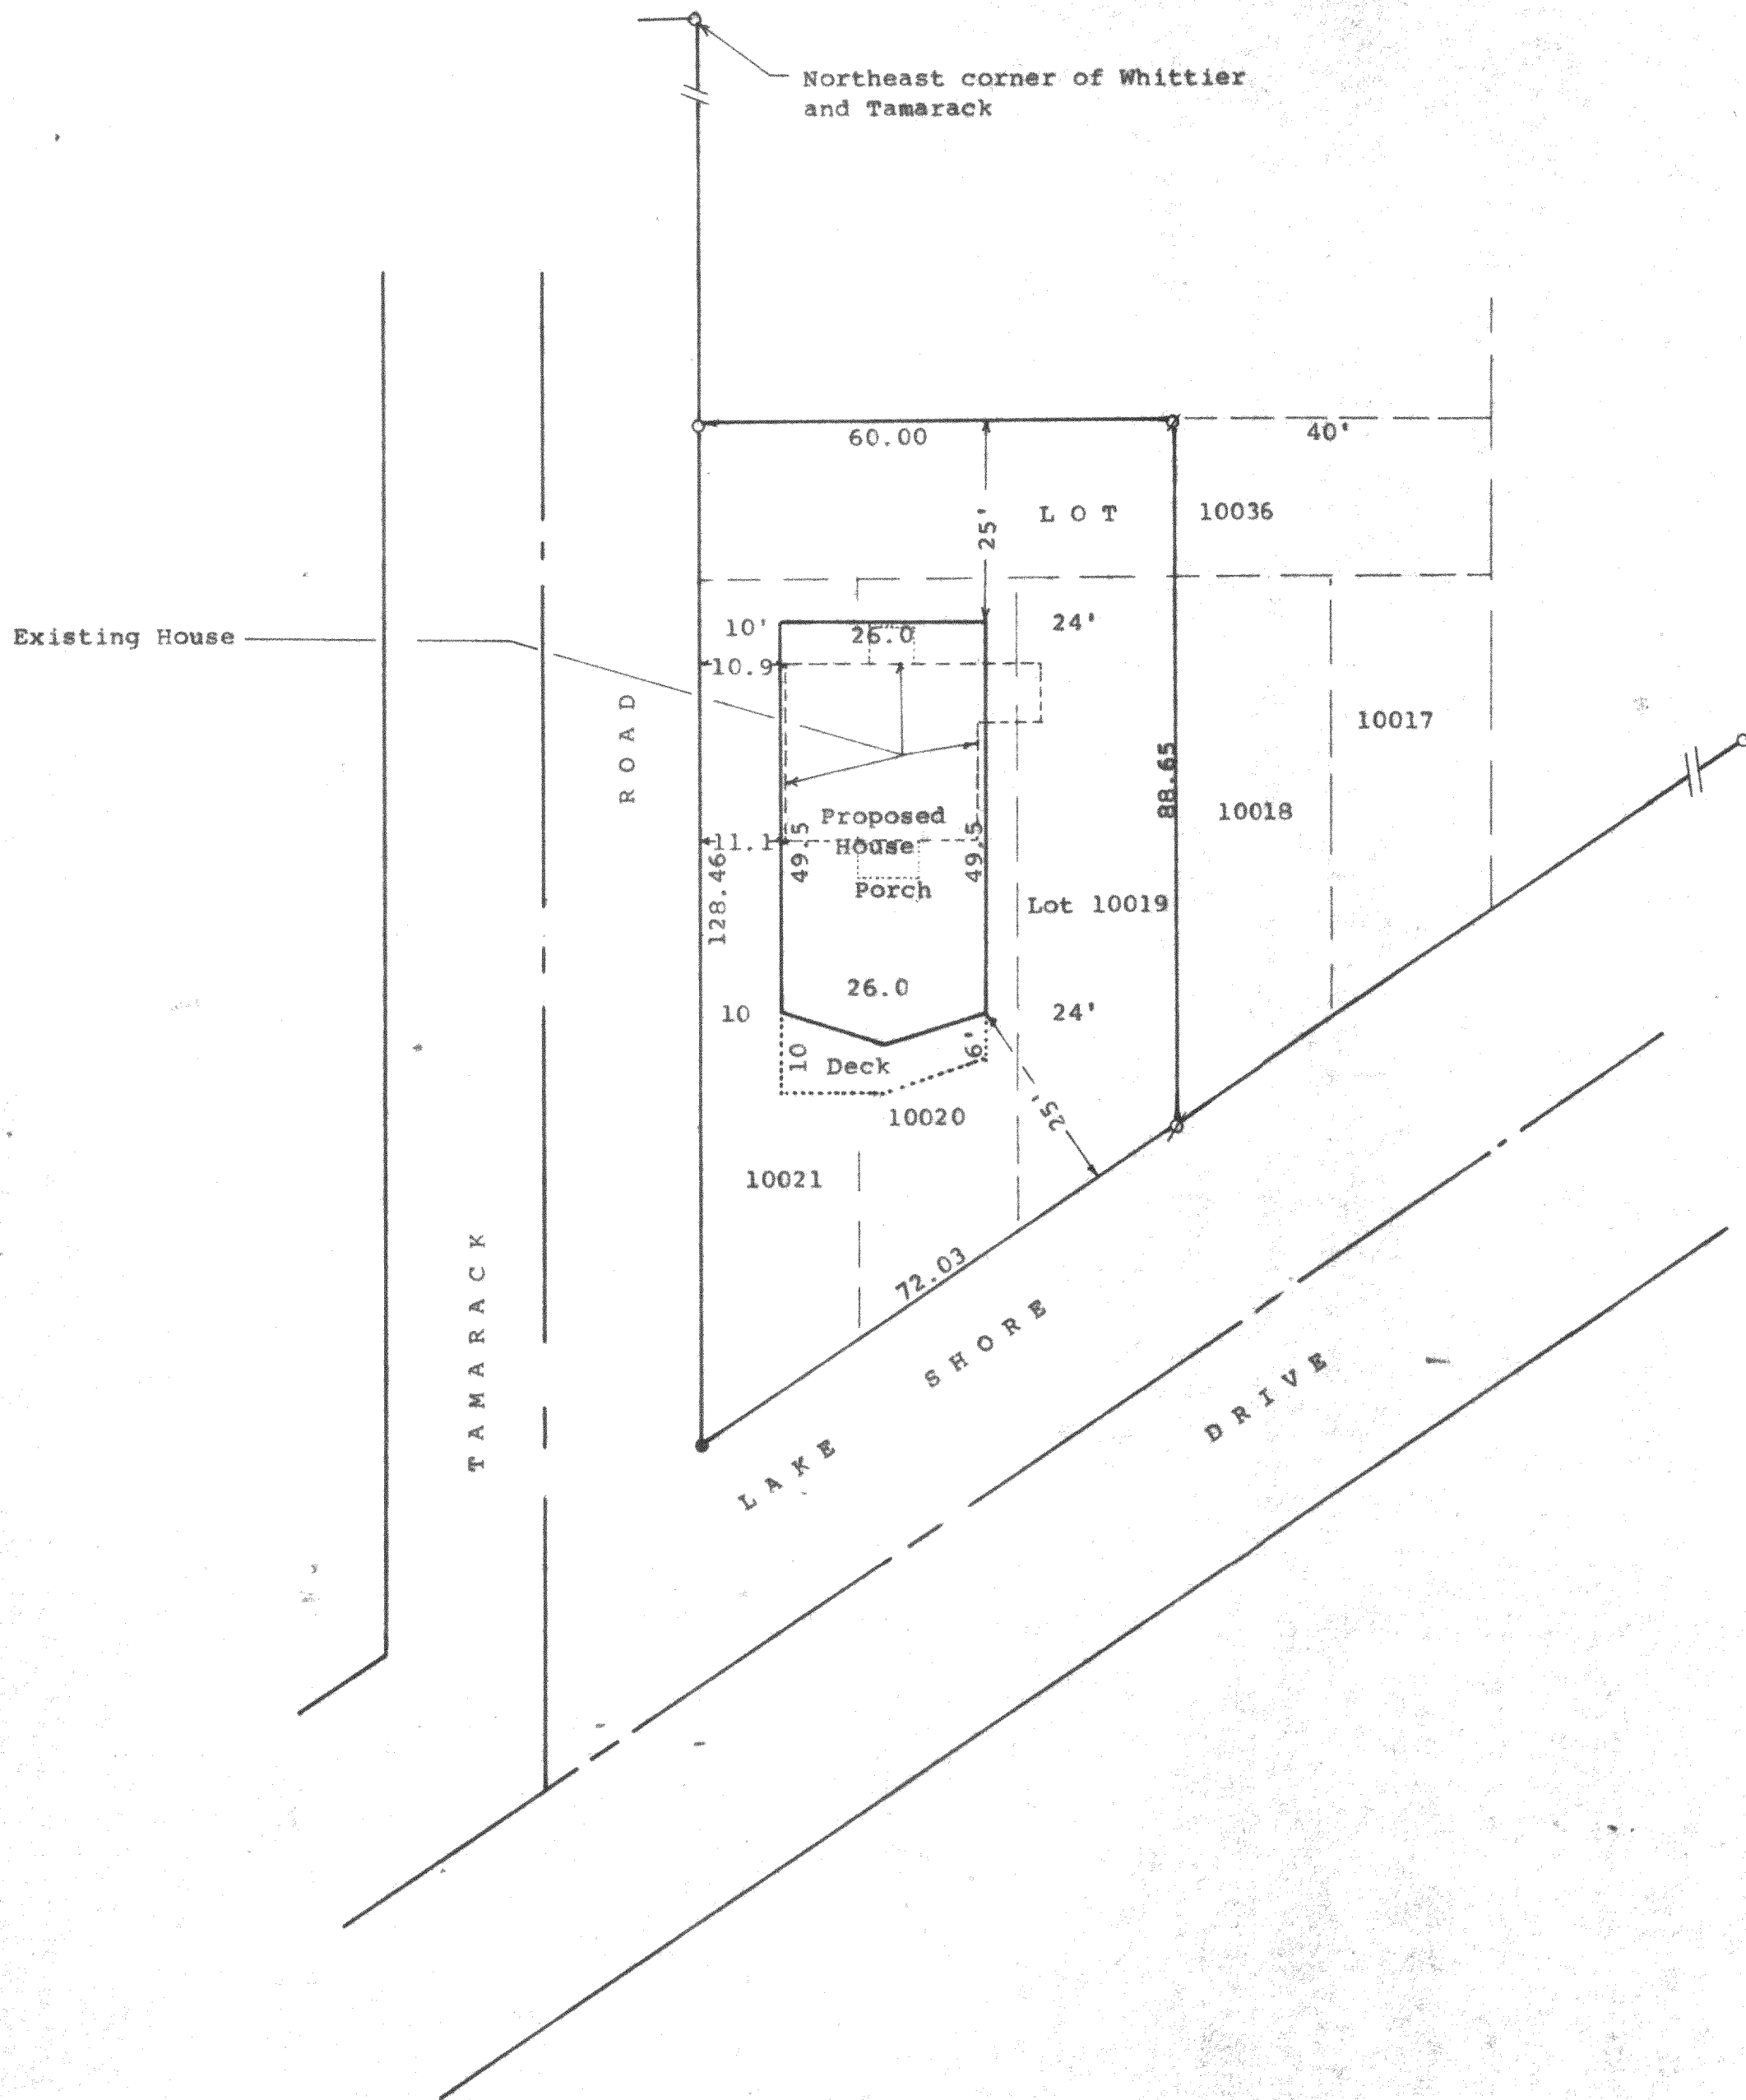


N

Scale - 1" = 20'

Plat of the proposed location of the proposed house to be built on
Lots 10019, 10020, 10021 and the West 60.00 feet of Lot 10036, all
in Block 183 of Lake Como Beach, a subdivision located in the Town
of Geneva, Walworth County, Wisconsin
March 22, 1994
Revised April 11, 1994 to show
Existing House

George T. Dunham
George T. Dunham, Surveyor

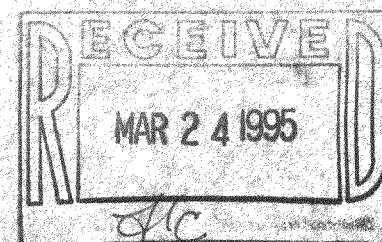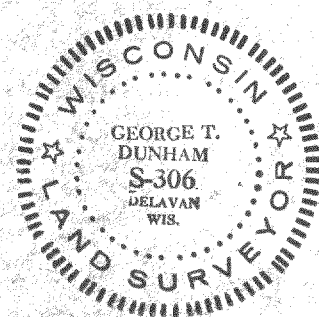

JCB-2160

217-1383