


KOLB LAND CONSULTING, INC.
LAND SURVEYING • SUBDIVIDING • LAND PLANNING

929 WILLIAMS STREET

LAKE GENEVA, WISCONSIN 53147

414-248-3697

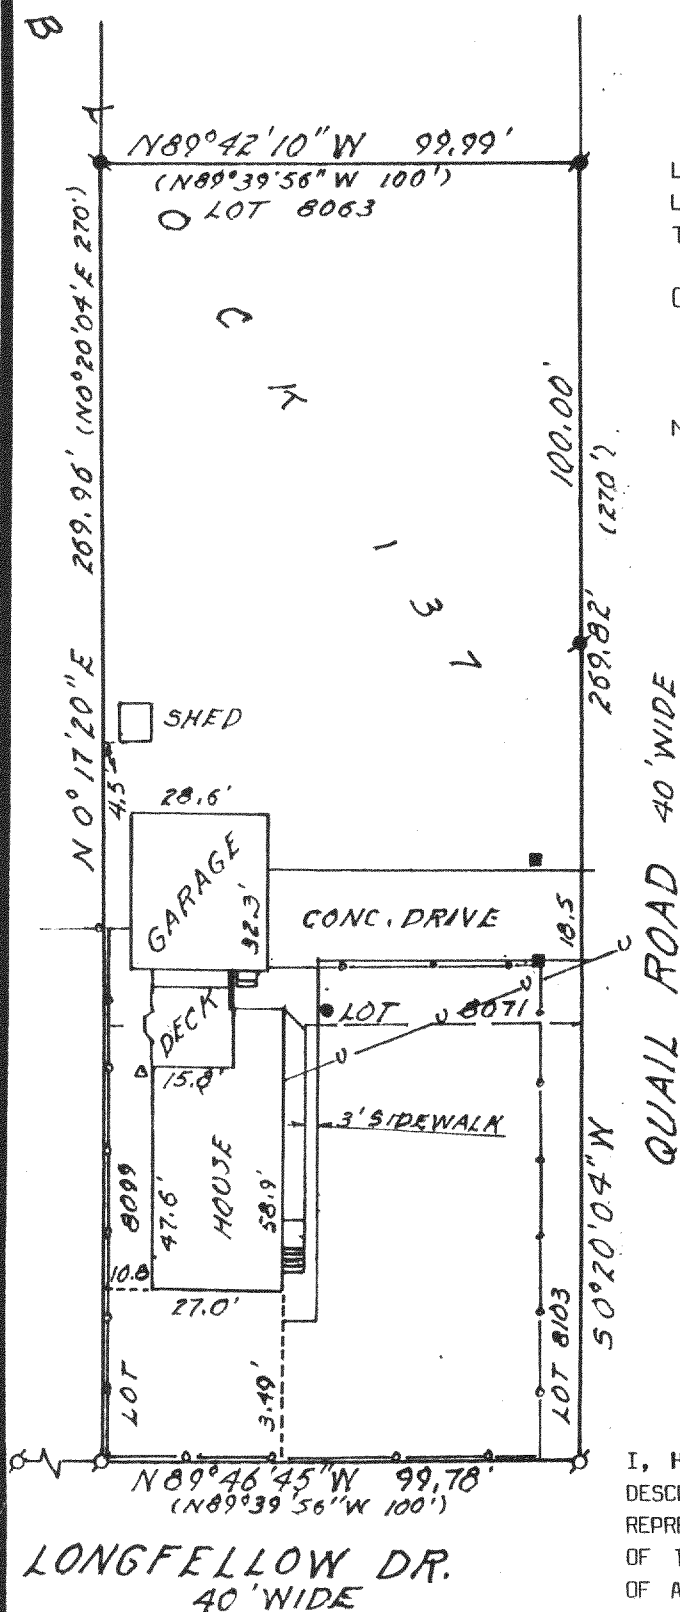

PLAT OF SURVEY OF

LOTS 8063-8071 AND LOTS 8099-8103, BLOCK 137,
LAKE COMO BEACH, A SUBDIVISION LOCATED IN THE
TOWN OF GENEVA, WALWORTH COUNTY, WISCONSIN.

ORDERED BY: TOM WATSON, OWNER
N3163 QUAIL ROAD
LAKE GENEVA WI 53147


NOTE: THE EAST LINE OF BLOCK 137 IS ASSUMED
S 0° 20' 04" W AS SHOWN ON THE RECORDED
PLAT OF LAKE COMO BEACH SUBDIVISION.



SCALE: 1" = 40'

LEGEND

- Ø IRON PIPE FOUND
- IRON ROD FOUND
- FENCE
- U— OVERHEAD UTILITY LINE
- SEPTIC VENT
- YARD LIGHT

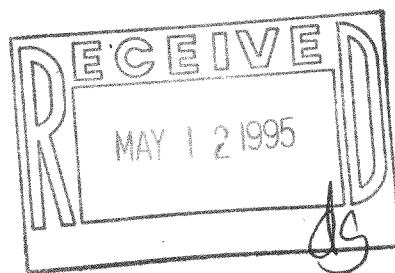

I, HAROLD H. KOLB, CERTIFY THAT I HAVE SURVEYED THE ABOVE
DESCRIBED PROPERTY AND THAT THE ABOVE PLAT IS A TRUE
REPRESENTATION THEREOF AND SHOWS THE SIZE AND LOCATION
OF THE PROPERTY, IT'S EXTERIOR BOUNDARIES, THE LOCATION
OF ALL VISIBLE STRUCTURES AND DIMENSIONS OF ALL PRINCIPAL
BUILDINGS THEREON, BOUNDARY FENCES, APPARENT EASEMENTS,
ROADWAYS AND VISIBLE ENCROACHMENT ANY TO THE BEST
OF MY KNOWLEDGE AND BELIEF.

THIS SURVEY IS MADE FOR THE USE OF THE PRESENT OWNERS OF
THE PROPERTY, AND ALSO THOSE WHO PURCHASE, MORTGAGE,
OR GUARANTEE TITLE THERETO WITHIN ONE (1) YEAR FROM THE
DATE HEREOF.

NOTE: THIS SURVEY IS NOT VALID UNLESS SURVEYOR'S SIGNATURE
IS IN RED.

HAROLD H. KOLB

WISCONSIN REGISTERED LAND SURVEYOR, S-187

DATE MARCH 17, 1995

REVISED

REVISED

JLCB-1718

217-1322 2-17/19