


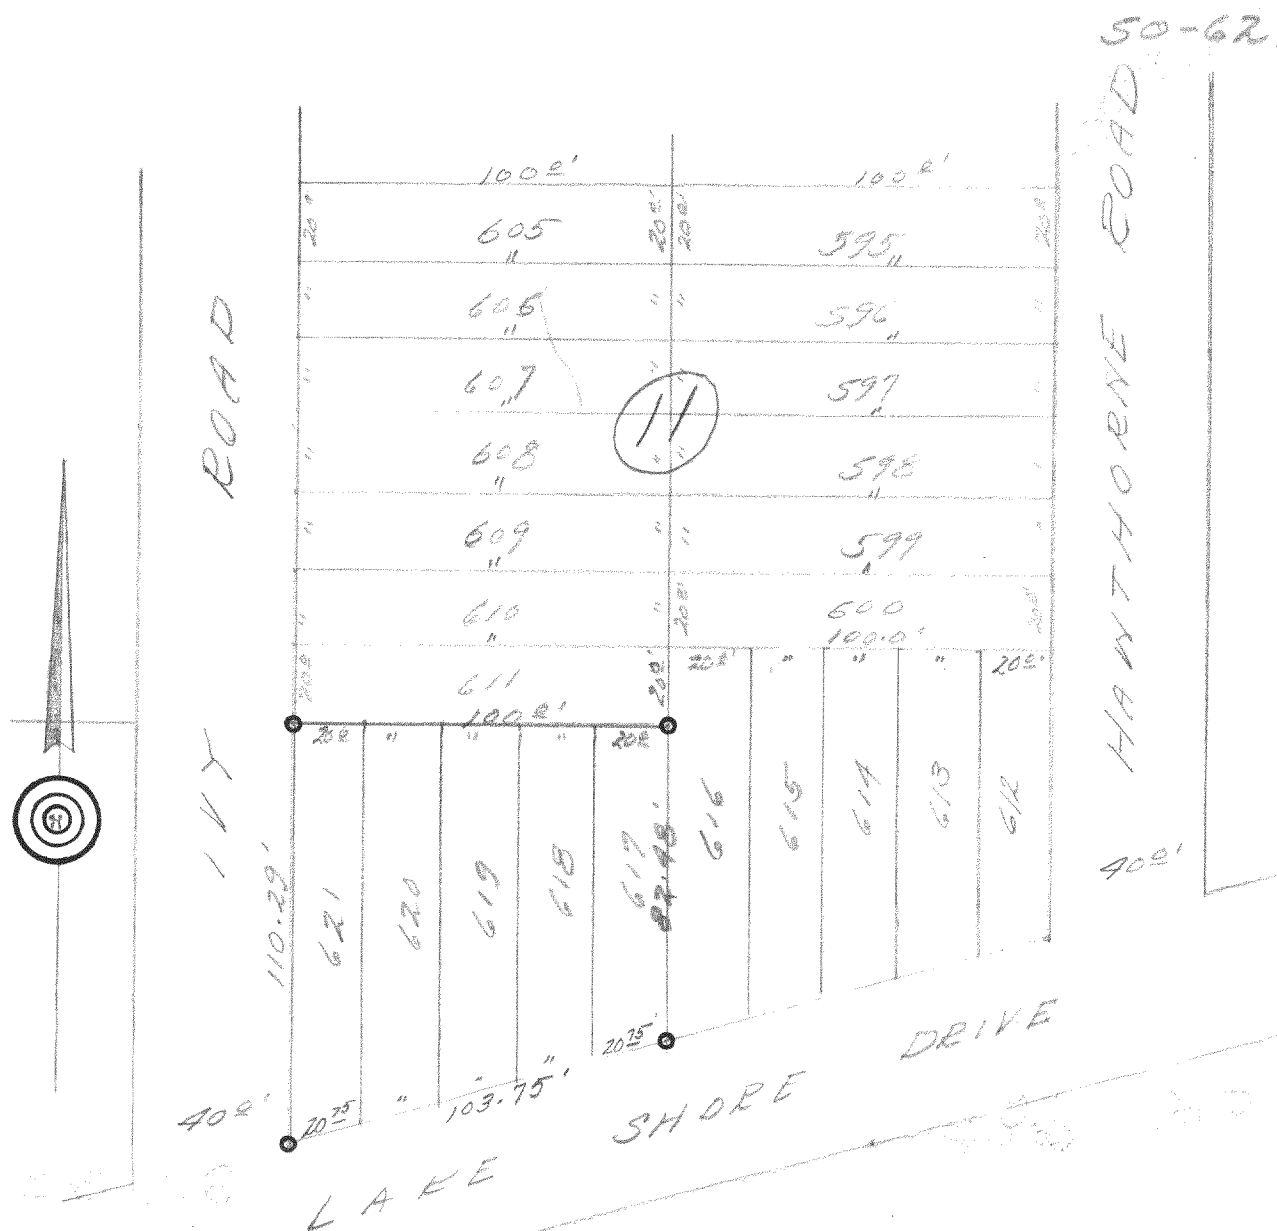

DESCRIPTION:

Lots 617 to 621 inclusive Block 11, Third Map of Lake Como Beach, a subdivision of a portion of Section 22, Town 2 north, Range 17 east of the 4th Principal Meridian.

CERTIFICATE:

I, hereby certify that I, have on this the 12th day of August 1950, surveyed the above described property according to the official records on file in the office of the Recorder of Deeds in and for Walworth County, Wisconsin, and find that the measurements and bearings of the boundary lines of said property as taken at the site on this day, substantially agree with those in said official record and that no encroachments exist.

SIGNED AND SEALED THIS 15TH DAY OF AUGUST 1950.

Joseph M. Biagi
 Joseph M. Biagi. Professional Engineer.
 Elkhorn Wisconsin.

217-134B

JUL 28 1950