


45-34

Laurel Road

King Road

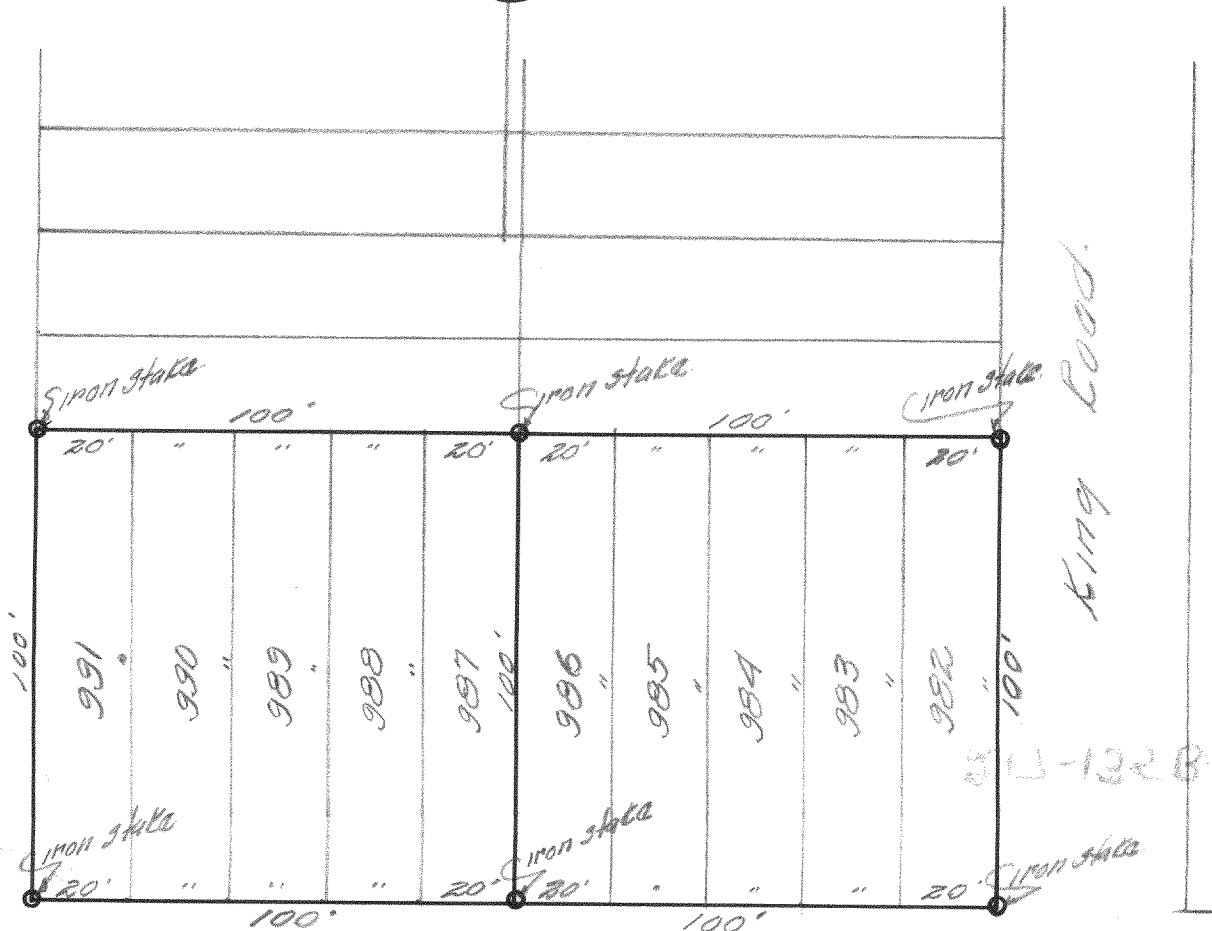

Washington Drive

DESCRIPTION: Lots, 982, 983, 984, 985, 986, 987, 988, 989, 990, and 991, Lake Como Beach Subdivision, of a portion of Sections 29 and 28, Town 2 north, Range 17 east of the 4th P. M.

CERTIFICATE: I, hereby certify that I have on this the 16th day of July surveyed the above described property according to the official records on file in the office of the Recorder of Deeds in and for Walworth County, Wisconsin, and find that no encroachments exist and that the plat hereon portrayed is an exact reproduction of the conditions found at the site on this day.

SIGNED AND SEALED THIS 17th DAY OF JULY 1945.

217-135B

Joseph M. Biagi. Professional Engineer.
Elkhorn, Wisconsin.

217-135B-117, 118