
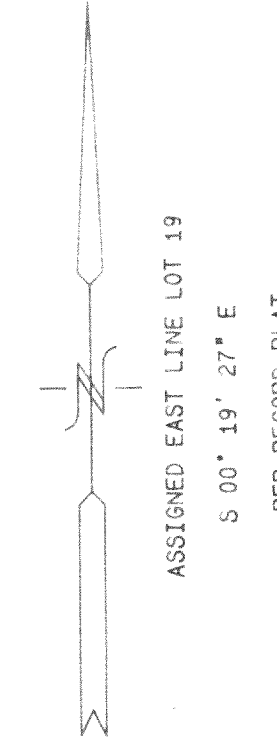


CURVE	ARC	RADIUS	CHORD LENGTH	CHORD BEARING
C1	24.78	363.00	24.77	N 32° 36' 38" W (N 32° 32' 41" W)

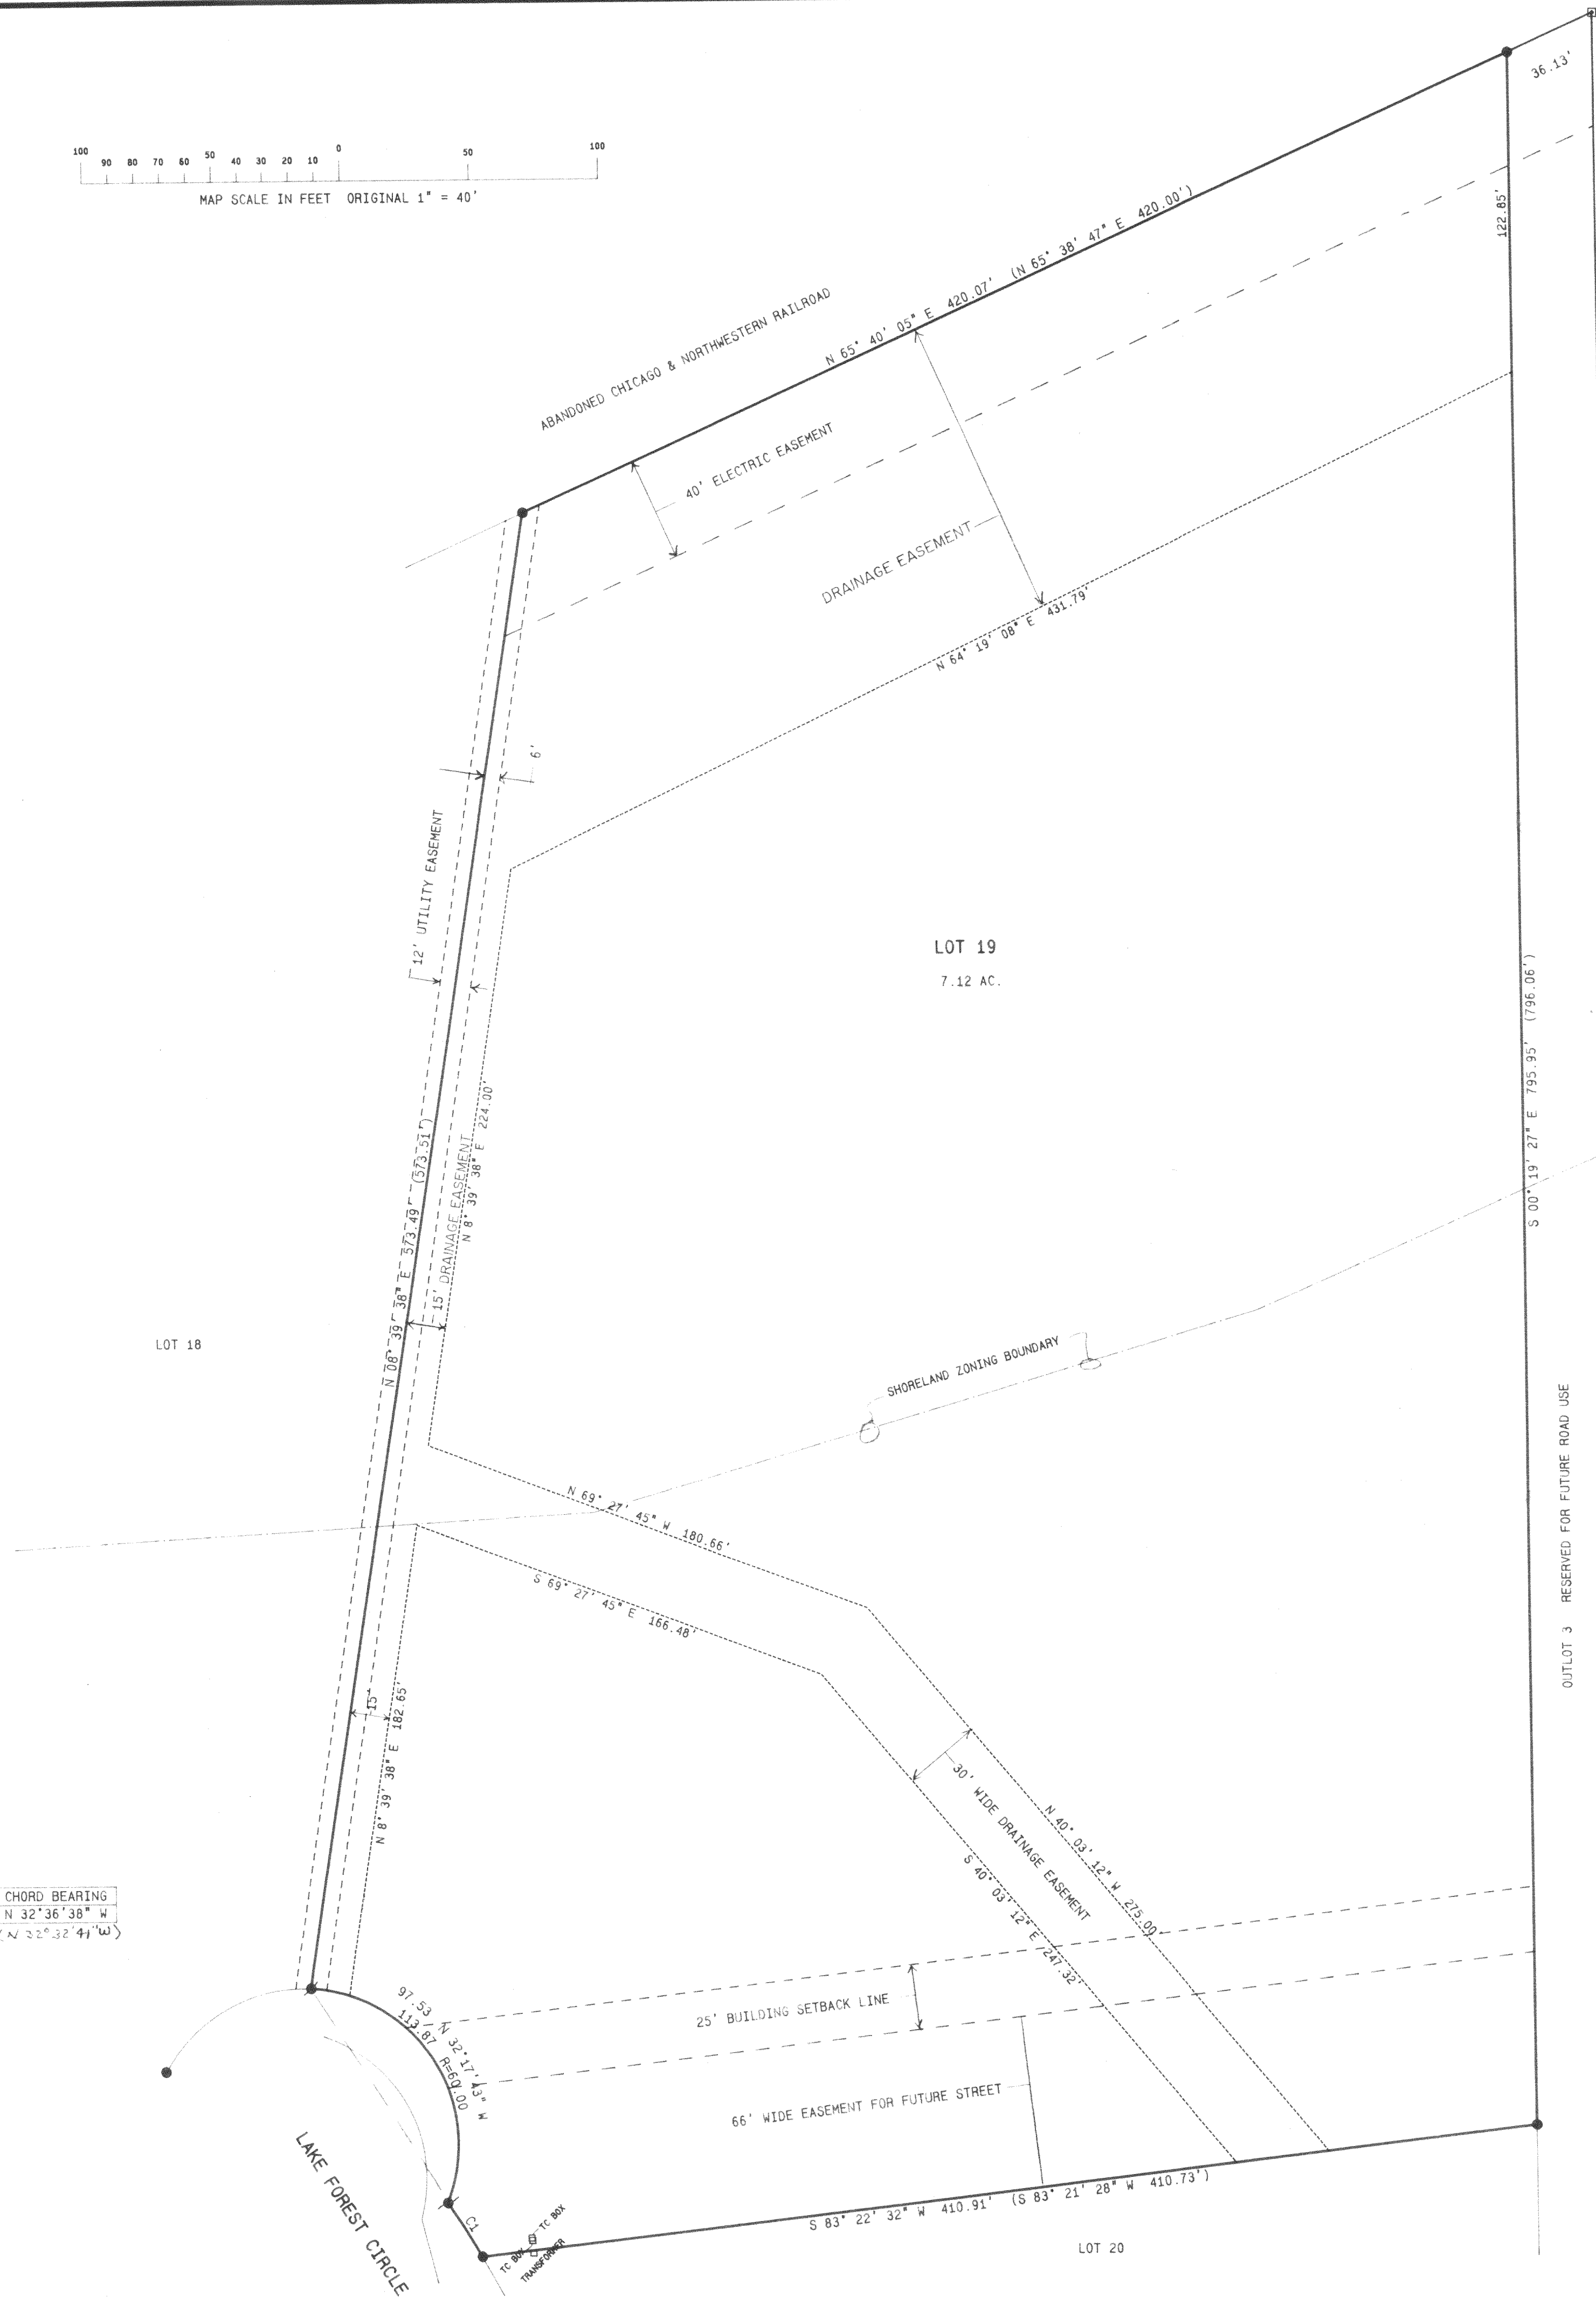


PLAT OF SURVEY

LOT 19 OF LAKE FOREST ESTATES

A SUBDIVISION RECORDED IN CABINET B ON SLIDE 155, OF WALWORTH COUNTY SUBDIVISIONS; LOCATED IN THE NW, SW, & SE 1/4'S OF THE SW 1/4 OF SECTION 26, THE SE & NE 1/4'S OF THE SE 1/4 OF SECTION 27, AND THE NE 1/4 OF THE NW 1/4 OF SECTION 35, ALL IN TOWN 2 NORTH, RANGE 17 EAST, TOWN OF GENEVA, WALWORTH COUNTY, WISCONSIN

- = FOUND IRON PIPE STAKE
- = FOUND IRON REBAR STAKE
- ⊙ = SET IRON REBAR STAKE
- = FOUND CONCRETE MONUMENT
- (R.A.) = RECORDED AS

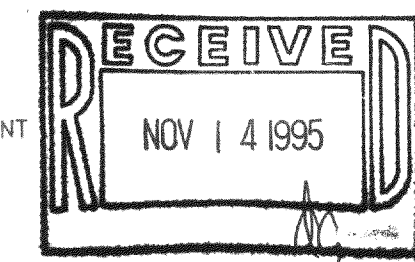


NOTE: COPIES OF THIS MAP TO WHICH THE FOLLOWING CERTIFICATE WILL APPLY ARE BLUE LINE PRINTS SHOWING SURVEYOR'S ORIGINAL SEAL AND SIGNATURE IN BLACK INK. COPIES BY ANY OTHER MEANS MAY HAVE ALTERATIONS WHICH DO NOT REPRESENT THE SURVEYOR'S WORK PRODUCT.

I HEREBY CERTIFY THAT THE ABOVE DESCRIBED PROPERTY HAS BEEN SURVEYED UNDER MY DIRECTION AND THAT THE ABOVE MAP IS A TRUE REPRESENTATION THEREOF AND SHOWS THE SIZE AND LOCATION OF THE PROPERTY AND ITS EXTERIOR BOUNDARIES. THIS SURVEY IS MADE FOR THE USE OF THE PRESENT OWNERS OF THE PROPERTY, AND ALSO THOSE WHO PURCHASE, MORTGAGE, OR GUARANTEE THE TITLE THERETO WITHIN ONE YEAR FROM THE DATE HEREOF.

DATED: 11-8-95

Peter S. Gordon
PETER S. GORDON R.L.S. 2101

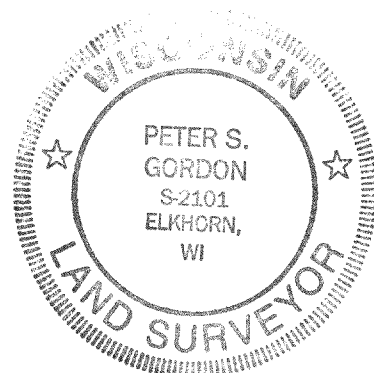

PLAT OF SURVEY

LOT 19

LAKE FOREST ESTATES

WORK ORDERED BY: LAKE VIEW REALTY

268 REID PO BOX 199
FONTANA, WI. 53125

FARRIS, HANSEN & ASSOCIATES, INC.

Engineering, Architecture, Surveying
7 Ridgway Court, P.O. Box 437
ELKHORN, WISCONSIN 53121
Office: (414) 723-2098
Fax: (414) 723-5886

REVISIONS

PROJECT NO.

4176.19

DATE

11/08/95

SHEET NO.

1 OF 1