

PLAT OF SURVEY


LOTS 9284 THRU 9292, BOTH INCLUSIVE &
LOTS 9308 THRU 9314, BOTH INCLUSIVE
BLOCK 167 OF LAKE COMO BEACH SUBDIVISION
TOWN OF GENEVA, WALWORTH COUNTY, WISCONSIN

WORK ORDERED BY: ATTORNEY
CHRISTINE TOMAS
BRADEN & OLSON
P.O. BOX 940
LAKE GENEVA, WISCONSIN 53147

FARRIS, HANSEN & ASSOCIATES, INC.
Engineering, Architecture, Surveying
7 Ridgeway Court, P.O. Box 437
ELKHORN, WISCONSIN 53121
Office: (414) 723-2088
Fax: (414) 723-2888


REVISIONS

PROJECT NO.
4425
DATE
11-14-1995
SHEET NO.
1 OF 1

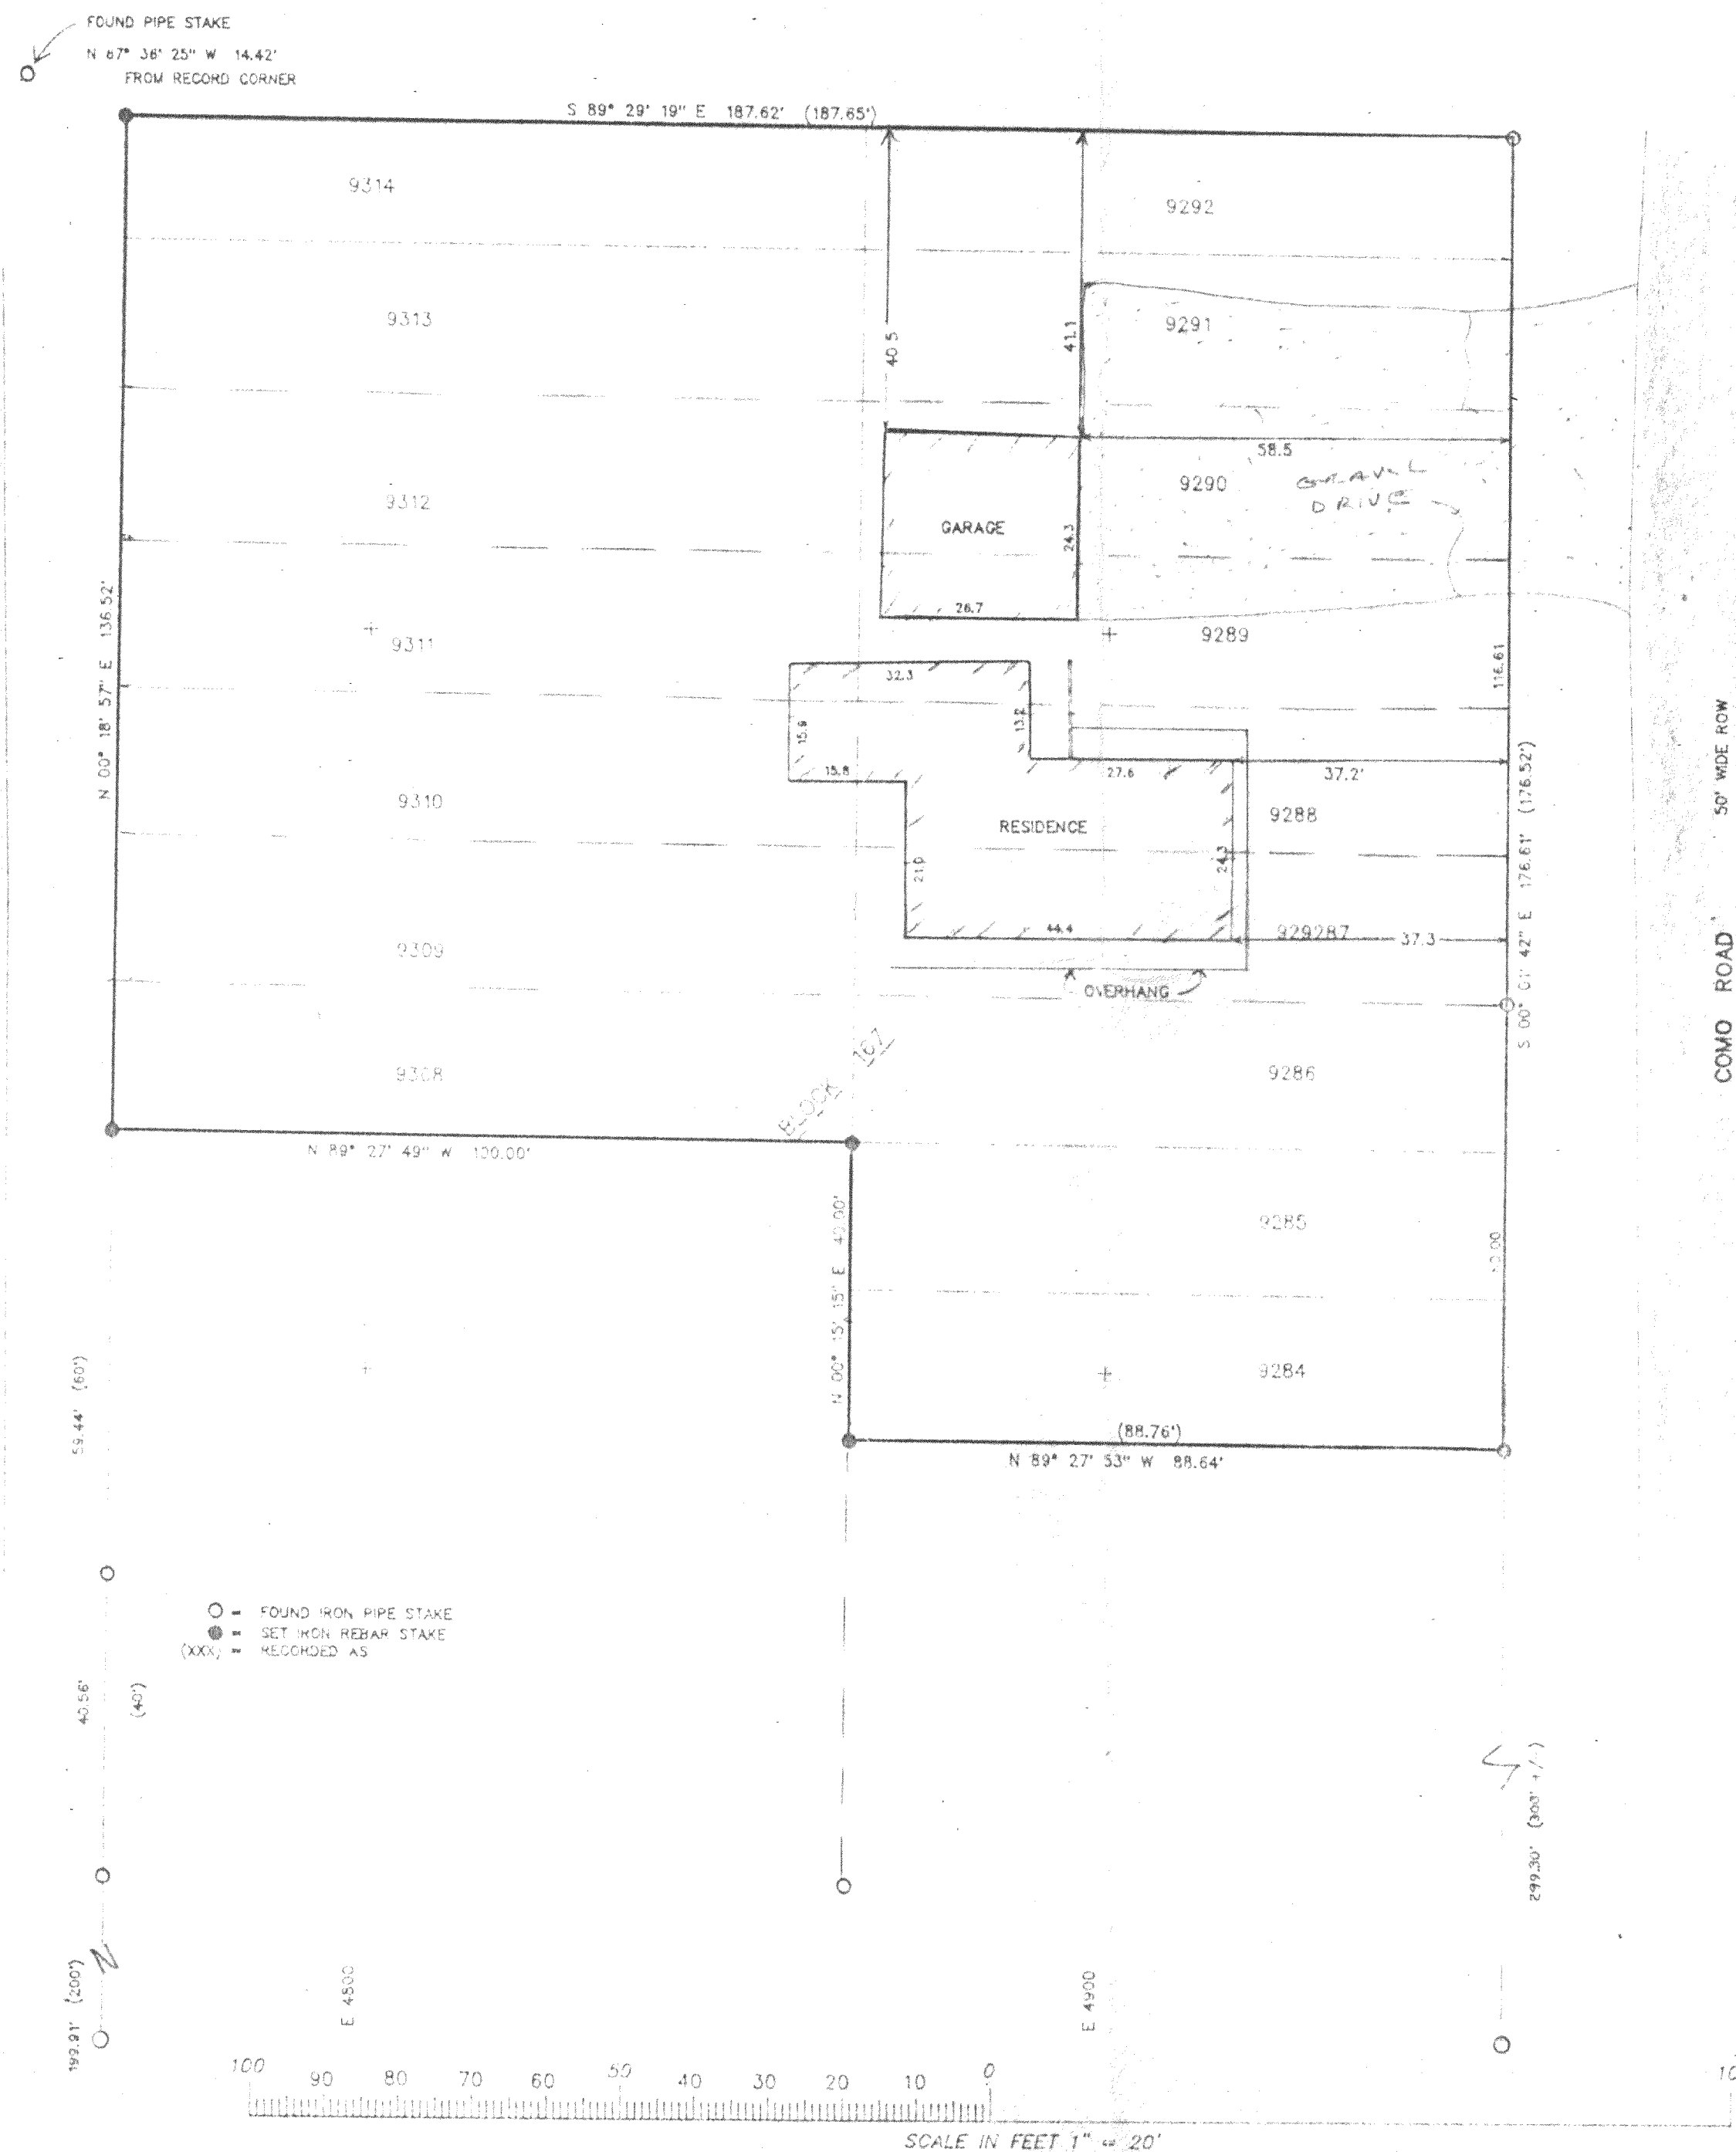


NOTE: COPIES OF THIS MAP TO WHICH THE FOLLOWING
CERTIFICATE WILL APPLY ARE BLUE LINE PRINTS SHOWING
SURVEYOR'S ORIGINAL SEAL AND SIGNATURE IN BLACK INK.
COPIES BY ANY OTHER MEANS MAY HAVE ALTERATIONS WHICH DO
NOT REPRESENT THE SURVEYOR'S WORK PRODUCT.

I HEREBY CERTIFY THAT THE ABOVE DESCRIBED PROPERTY HAS
BEEN SURVEYED UNDER MY DIRECTION AND THAT THE ABOVE MAP
IS A TRUE REPRESENTATION THEREOF AND SHOWS THE SIZE AND
LOCATION OF THE PROPERTY AND ITS EXTERIOR BOUNDARIES.
THIS SURVEY IS MADE FOR THE USE OF THE PRESENT OWNERS OF
THE PROPERTY, AND ALSO THOSE WHO PURCHASE, MORTGAGE, OR
GUARANTEE THE TITLE THERETO WITHIN ONE YEAR FROM THE
DATE HEREOF.

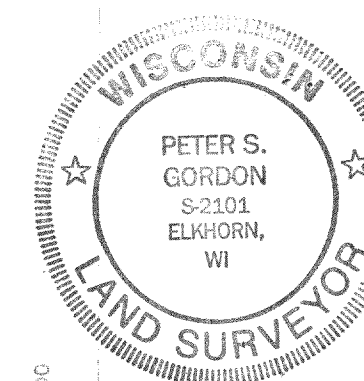

DATED: 11/17/95

PETER S. GORDON R.L.S. 2101

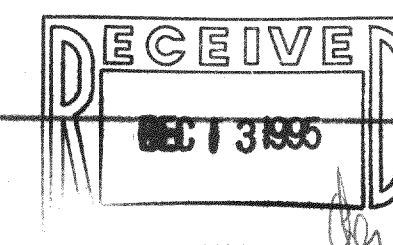

JLCB-2000
JLCB-2005 217-1367