


CLUB HOUSE DRIVE

DAISY DRIVE

UNIVERSITY ROAD

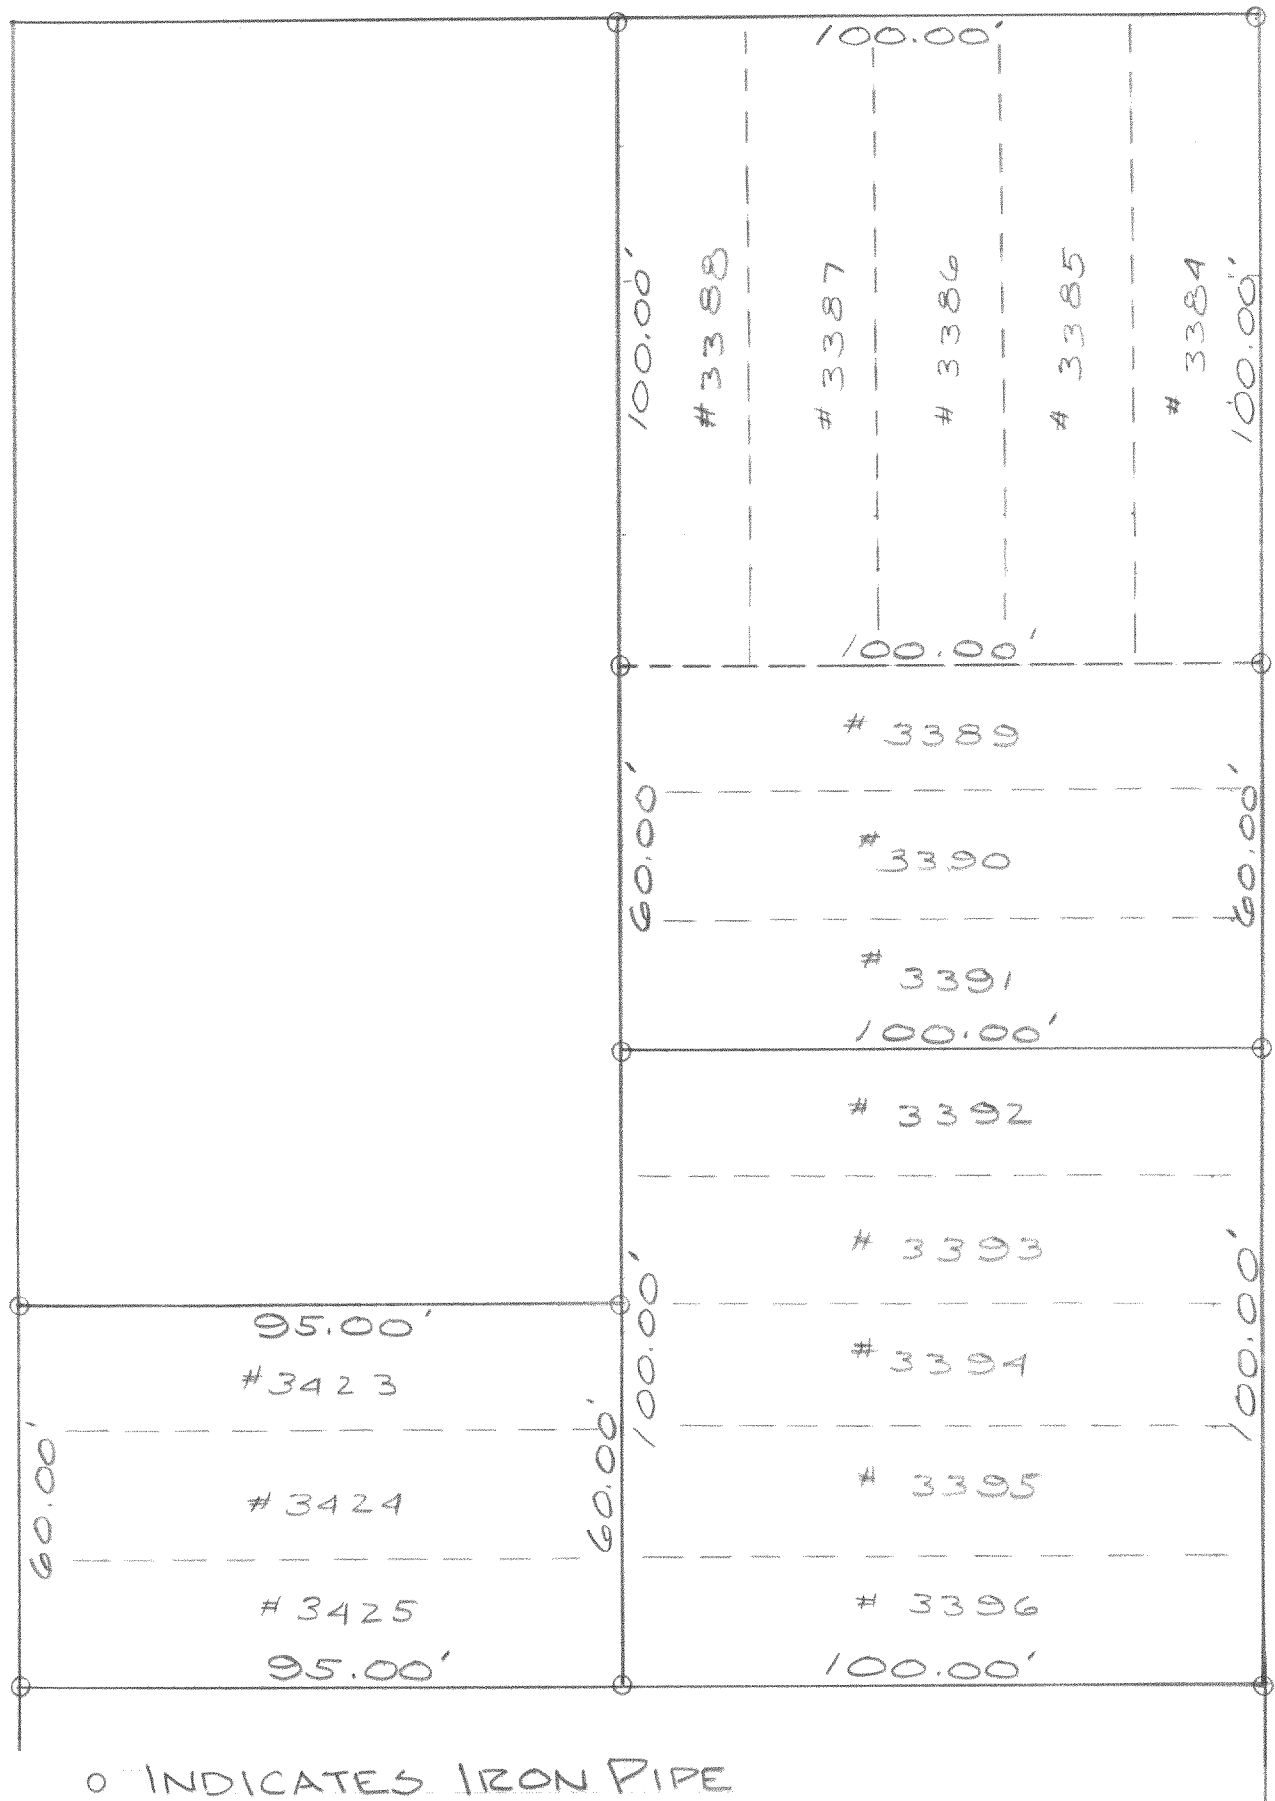

o INDICATES IRON PIPE

JLUB-626

Lake Como Beach
Lots 3384-3396 incl + 3423-3425 incl

27-138B