


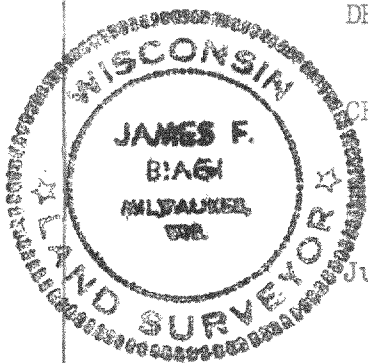


DESCRIPTION: Lots 3462 to 3473 inclusive, Lake Como Beach Subdivision, (Second Map of) in the Town of Geneva, T. 2 N., R. 17 E. Walworth County, Wisconsin.

CERTIFICATE: I, hereby certify that I have surveyed the above mentioned property and that the hereon portrayed is an accurate survey and a true representation thereof and correctly shows the exterior boundary lines and the location of the buildings and other improvements thereof.

July 20, 1966.

James F. Biagi
James F. Biagi, RLS 272

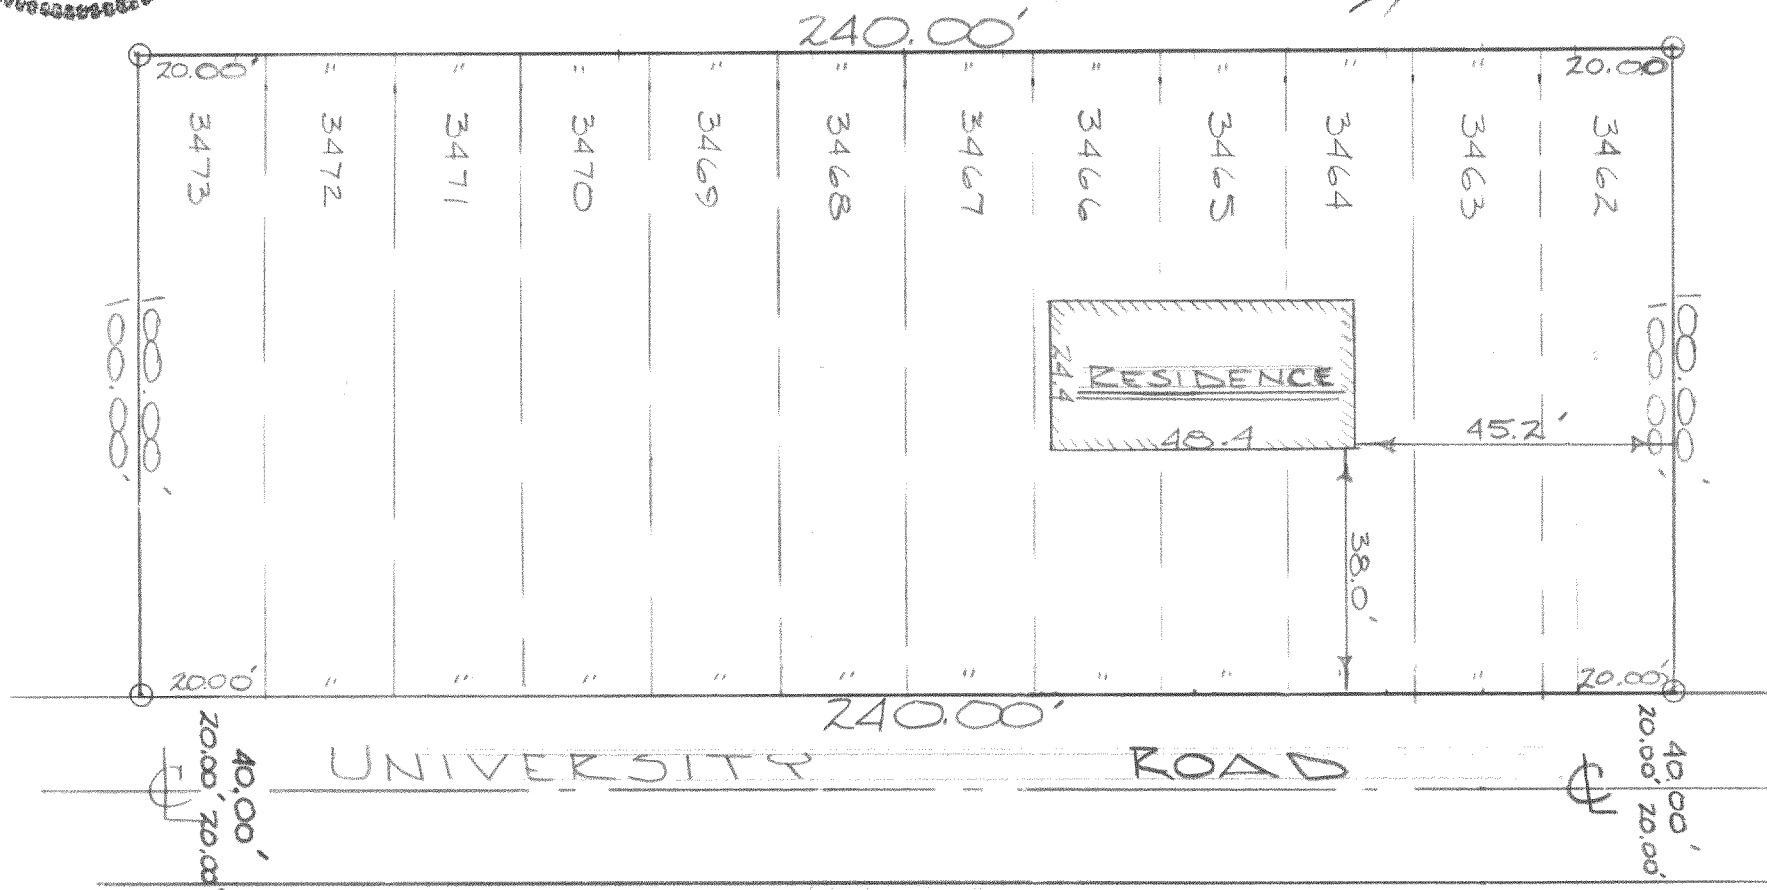

O-INDICATES IRON PIPE

100-66