


HAROLD H. KOLB
REGISTERED PROFESSIONAL LAND SURVEYOR
LAKE GENEVA, WISCONSIN

OAK ROAD

PARK DRIVE

BLOCK 25

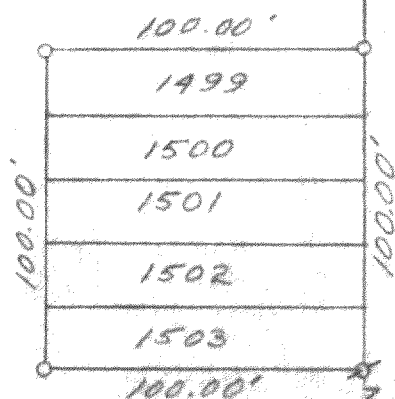

Scale:
1" = 60'

PLAT OF SURVEY OF

Lots 1499-1503, Block 25, Lake Como Beach, a subdivision in
Walworth County, Wisconsin.

Harold H. Kolb
Harold H. Kolb, Wisconsin Surveyor, S-187
DATE: May 22, 1964.

Δ Iron Pipe Found
○ Iron Pipe Placed

JLLB-226

217-143