

ABERNATHY and ASSOCIATES

Kenneth B. Abernathy Jr.



Wisconsin Registered Land Surveyor S-1594

Rt. 3, Box 273
Elkhorn, Wisconsin 53121
Phone: (414) 723-4260 (office)
(414) 723-7209 (FAX)

PLAT OF SURVEY


LOTS 5260 THRU 5269 AND LOTS 5285 THRU 5287 OF
BLOCK 94 OF LAKE COMO BEACH SUBDIVISION, LOCATED
IN SECTIONS 21 AND 28, TOWN 2 NORTH, RANGE 17
EAST, WALWORTH COUNTY, WISCONSIN.

OWNERS: WALTER AND BEVERLY SCHENK
518 HOLLY CT.
STREAMWOOD, IL. 60107

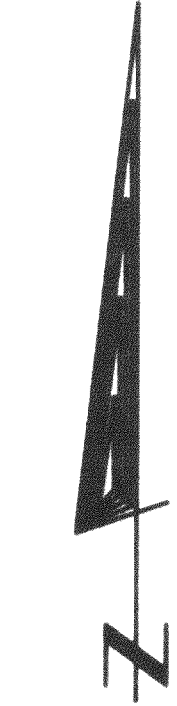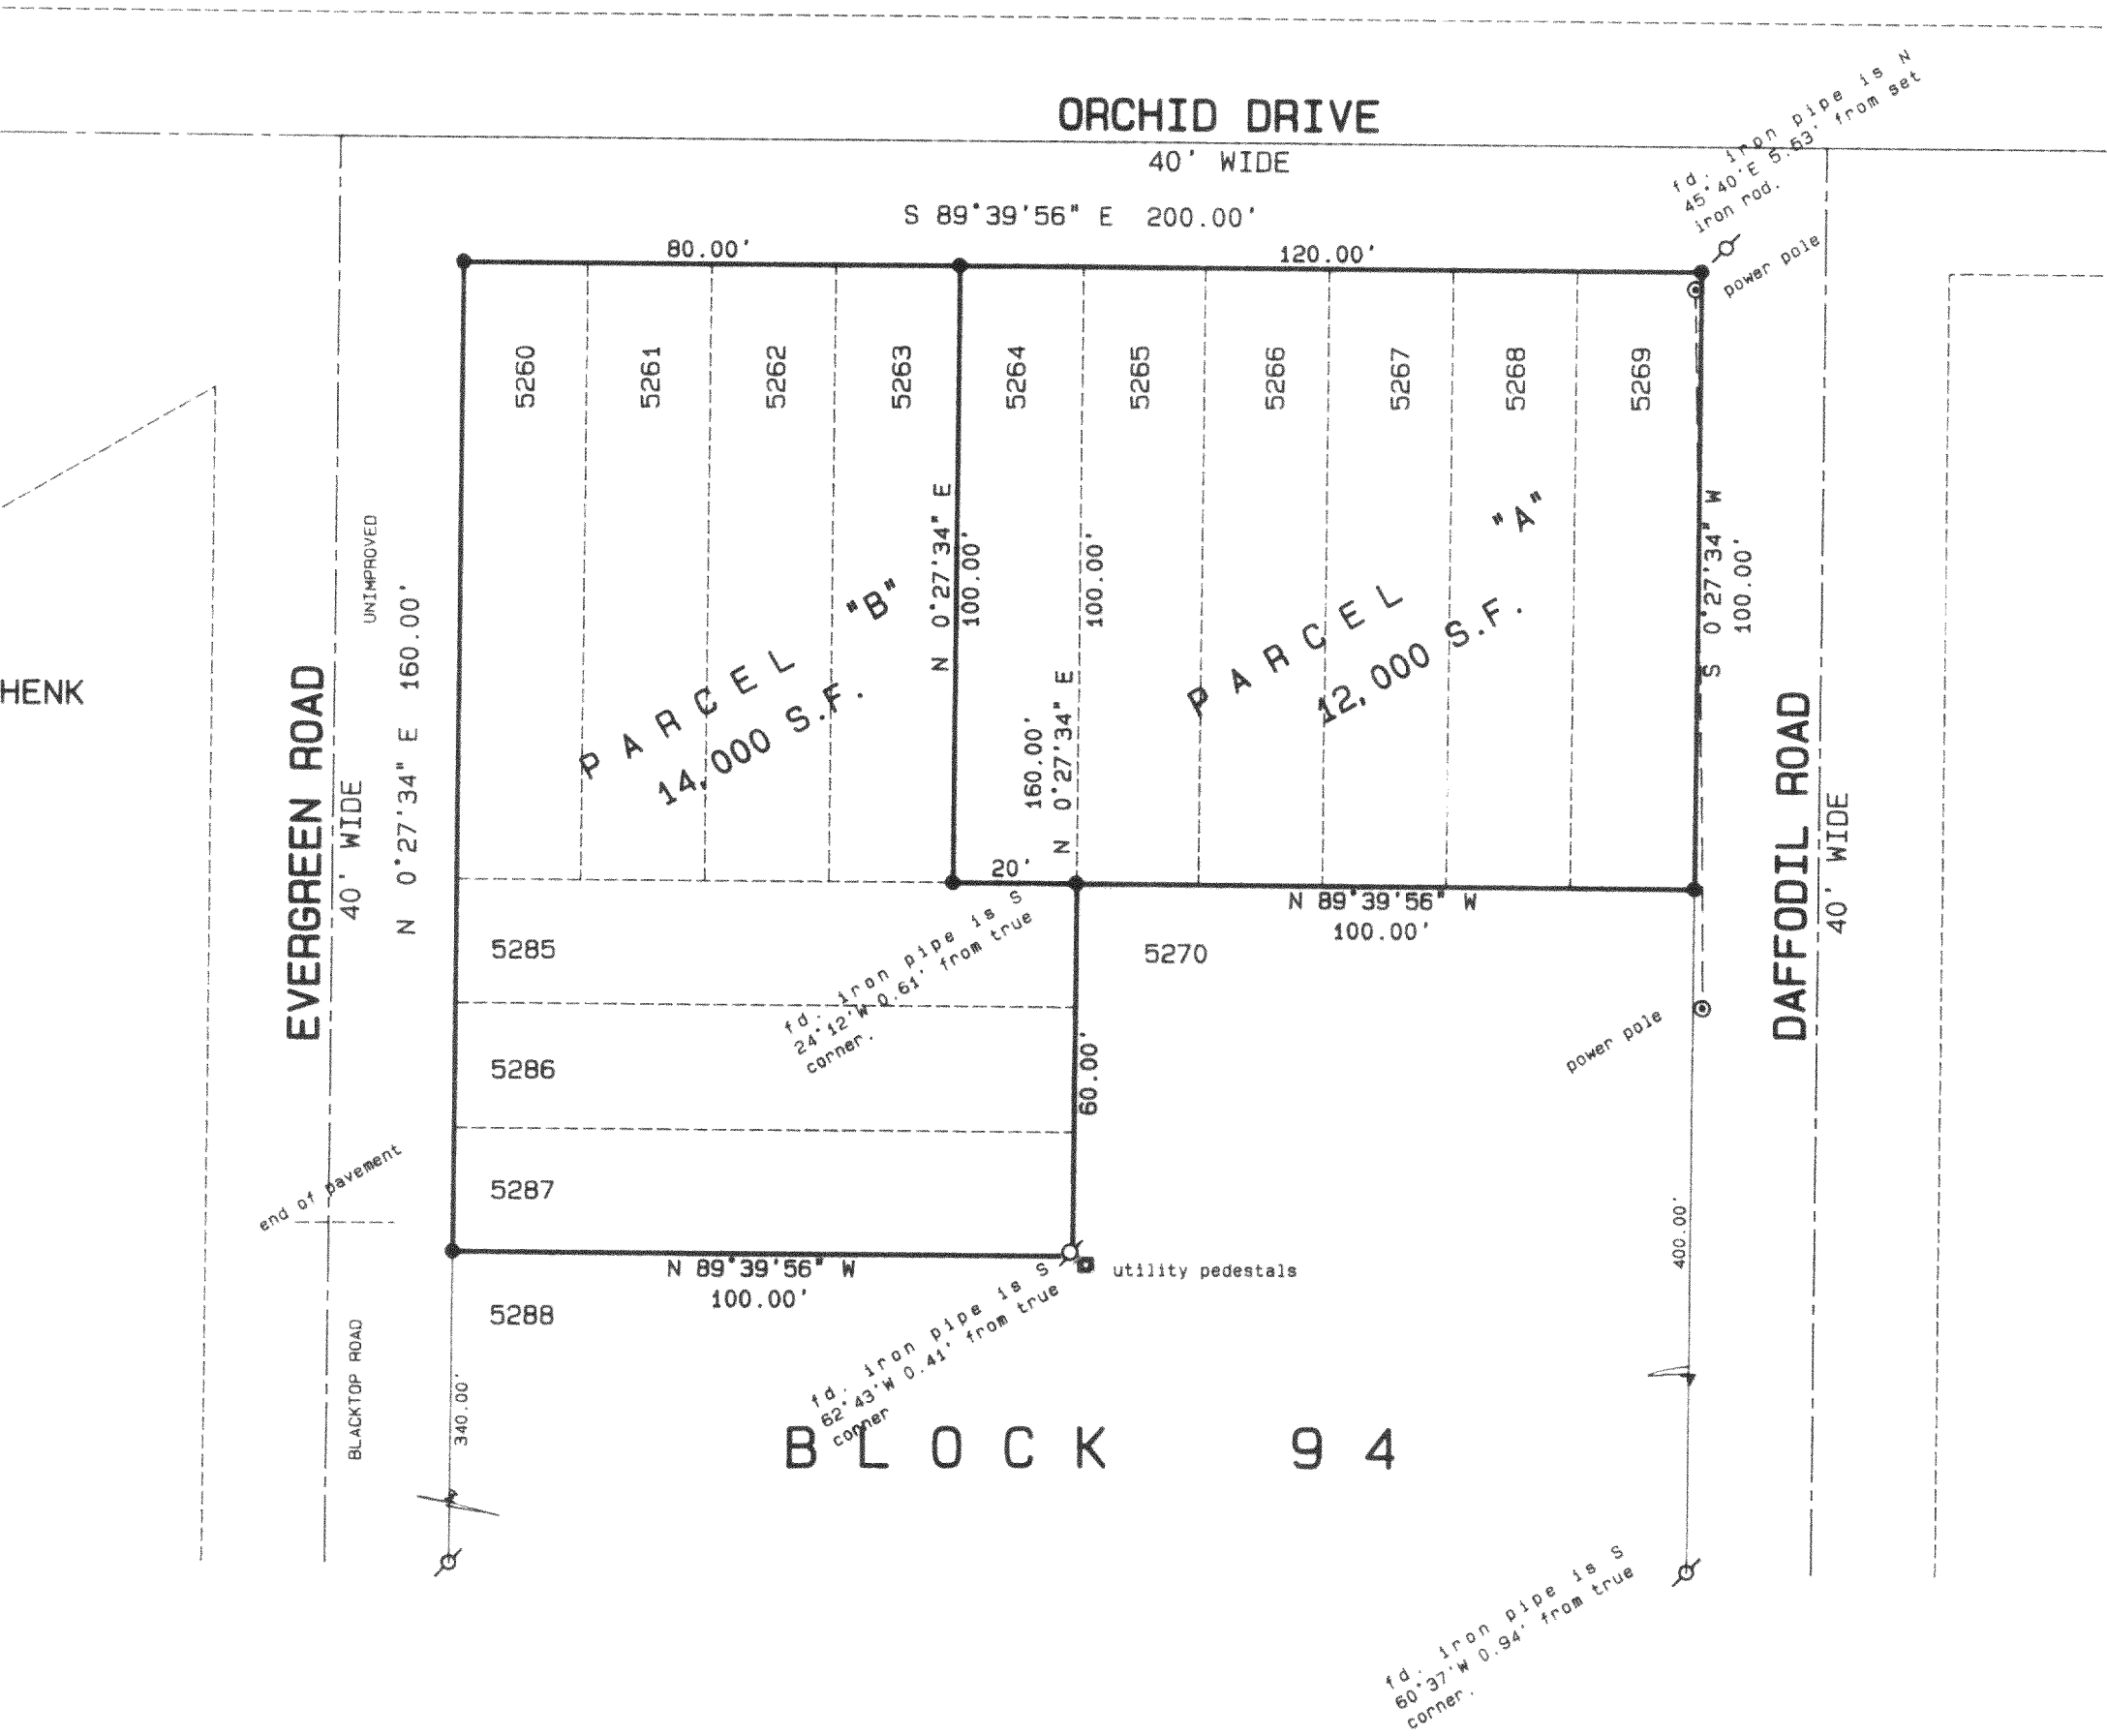


SCALE 1" = 30 FEET

THE SOUTH LINE OF BLOCK 94 WAS
ASSUMED TO BEAR N 89°39'56"E AS
PLATTED.

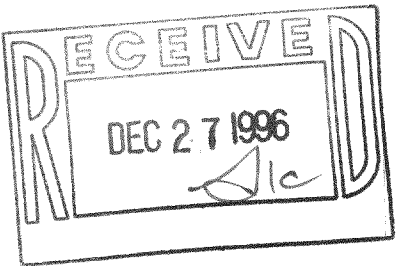

Legend

- FOUND IRON PIPE
- FOUND IRON ROD
- FOUND BRASS CAPPED MONUMENT
- FOUND CONCRETE MONUMENT
- CHISEL CUT IN CONCRETE
- SET IRON ROD, 24" LONG, WEIGHING 1.5 LBS., LINEAL FT., 3/4" DIA.
- SET IRON ROD, 30" LONG, WEIGHING 4.5 LBS., LINEAL FT., 1-11/16" DIA.
- RECORDED AS DIMENSION
- EXISTING FENCE

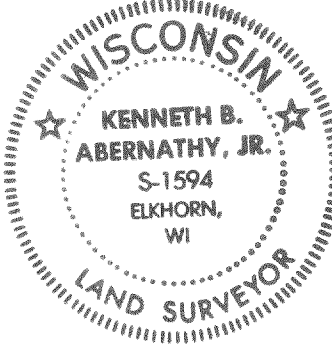

SCALE: 1" = 30 FEET

"I hereby certify that the above described property has been surveyed by me or under my direction and that the above map is a true representation thereof and shows the size and location of the property, its exterior boundaries, the location of all visible structures and dimensions of all principal buildings thereon, boundary fences, apparent easements, roadways and visible encroachments, if any."

"This survey is made for the use of the present owners of the property, and also those who purchase, mortgage, or guarantee the title thereto within one year from date hereof."

REVISED 9/16/96

Kenneth B. Abernathy, Jr.

KENNETH B. ABERNATHY, JR.
WISCONSIN REGISTERED LAND SURVEYOR,
S-1594
ELKHORN, WI

Date: 3-12-96 Job No. 96.216

JLCB-1060
217-1438