


45-39

Lincoln Drive

30-1-18-12

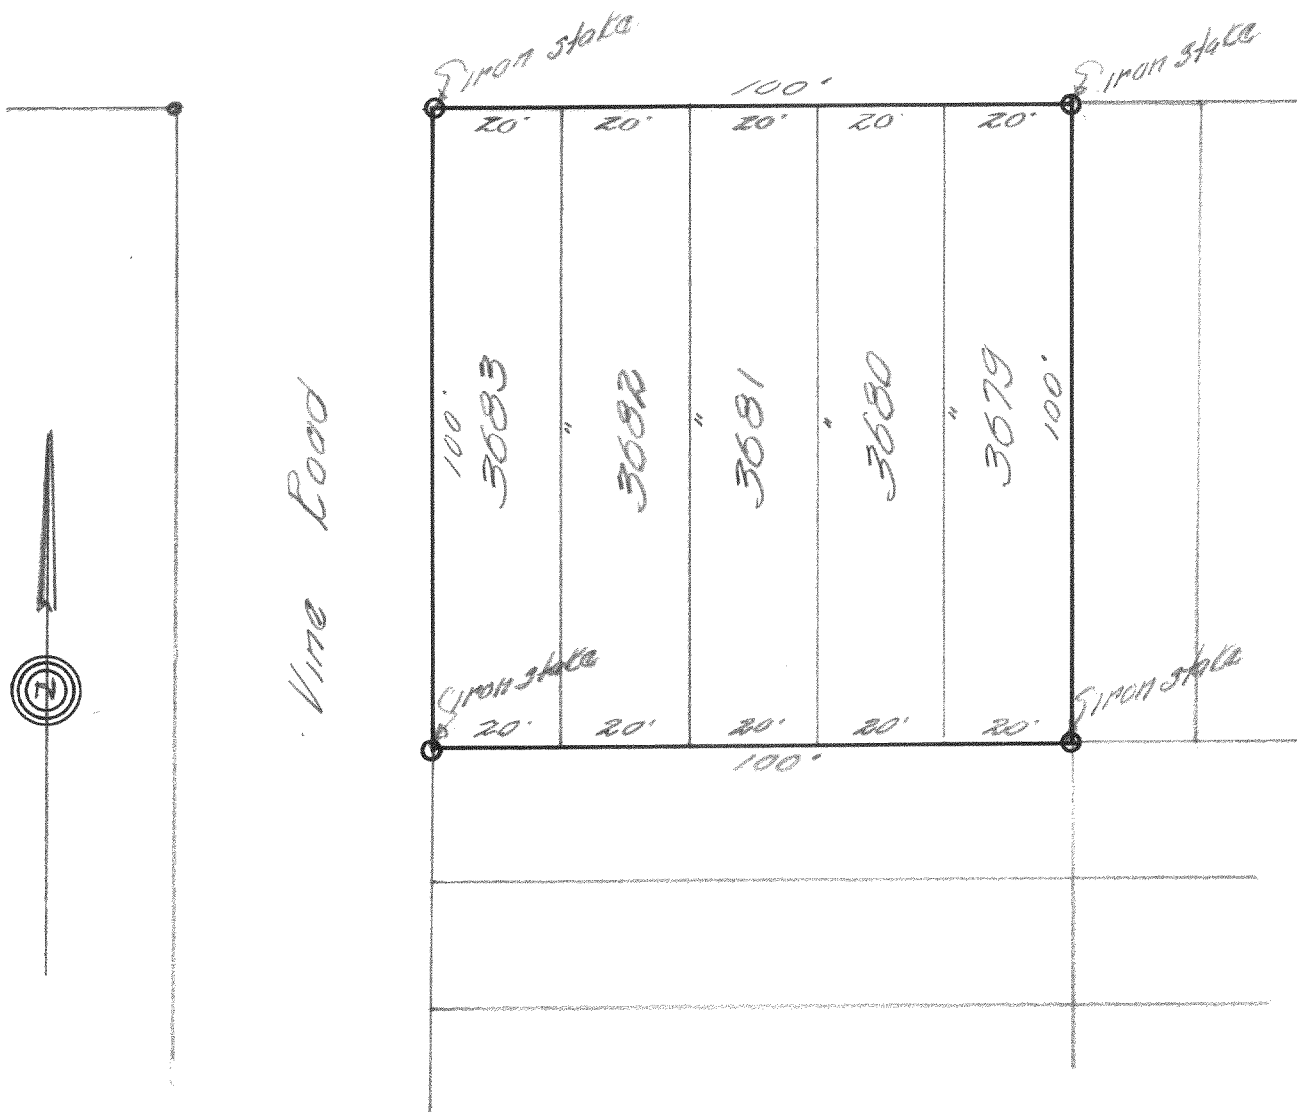

DESCRIPTION: Lots 3679, 3680, 3681, 3682, and 3683, Lake Comom Subdivision of a portion of Sections 28 and 29, Town 2 north, Range 17 east of the 4th P. M.

CERTIFICATE: I, here by ce rtify that I have on this the 17th day of July surveyed the above described property according to the official records on file in the office of the Recorder of Deeds in and for Walworth County, Wisconsin, and find that no encroachments exist, and that the the plat he reon portrayed is an exact reproduction of the conditionsfp found at the site on this day.

SIGNED AND SEALED THIS 18th DAY OF JULY, 1945.

Joseph M. Biagi Professional Engineer.
Elkhorn Wisconsin.

217-143B

WJ LCB-694