


117-69

0-1 INDICATES
IRON PIPE

WALNUT RD.

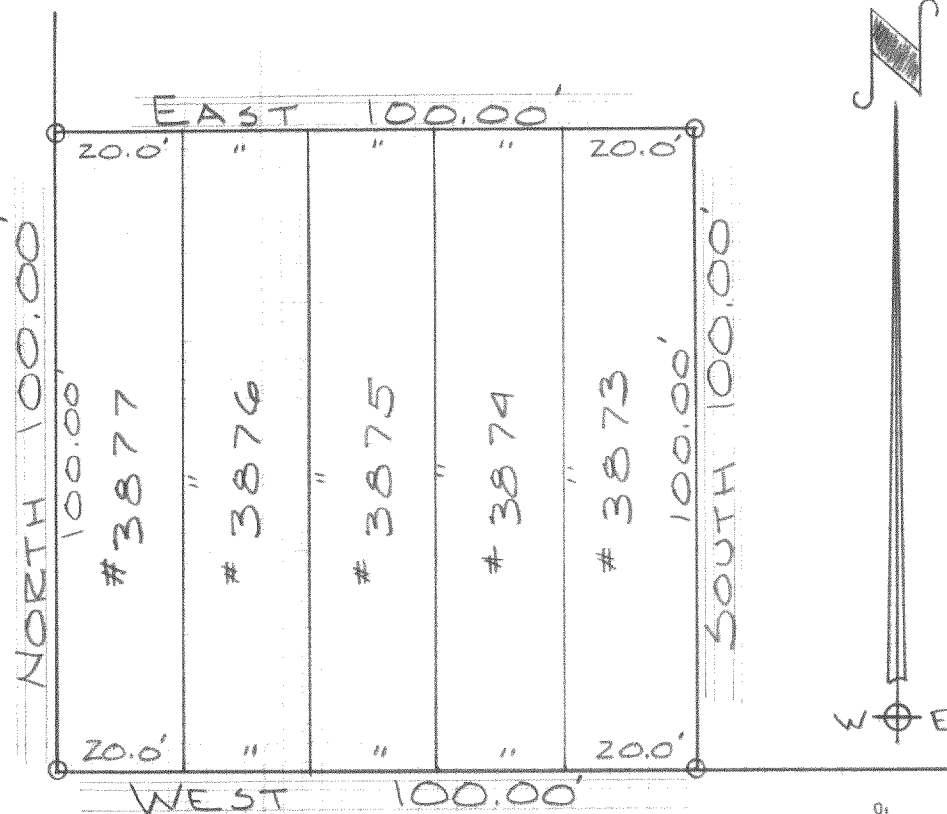

LINCOLN DRIVE

25°

25°

Description:


Lots 3873 through 3877, Lake Como Beach Subdivision 2nd Map, of a portion of Sections 27 and 28, Town 2 north, Range 17 east, Geneva Township, Walworth County, Wisconsin.

Certificate:

I, James F. Biagi, surveyor do hereby certify that I, have surveyed the above described property.

James F. Biagi. RLS 272 Wis.
Elkhorn, Wisconsin.

Dated: August 19th 1969.

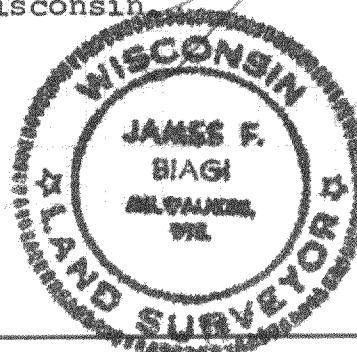

JL2B-740

217-144B