

52-45

300-100

LINCOLN


DRIVE.

ROAD.

ROAD.

WALNUT

VINE

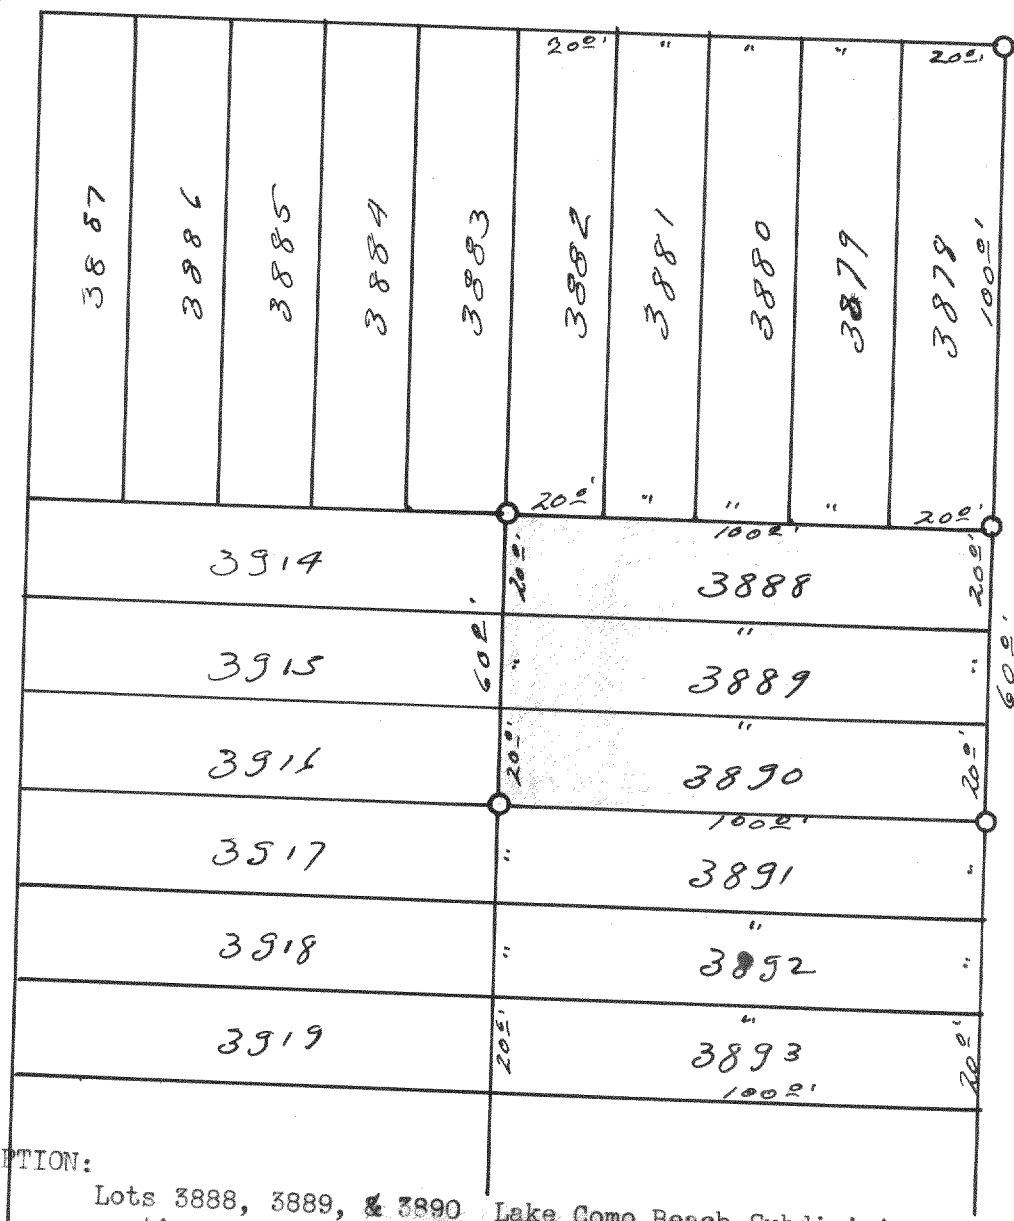

DESCRIPTION:

Lots 3888, 3889, & 3890 Lake Como Beach Subdivision of portions of Sections 21, 22, 27, & 28, Town 2 north, Range 17 east, of the 4th Principal Meridian.

CERTIFICATE:

I, hereby certify that I have on this the 31st day of October 1952. surveyed the above described property.
SIGNED AND SEALED ON THIS THE 31ST DAY OF OCTOBER 1952.

Joseph M. Biagi
Joseph M. Biagi. Professional Engineer.
Elkhorn Wisconsin.

JLLB-743

217-145B