


HAROLD H. KOLB
REGISTERED PROFESSIONAL LAND SURVEYOR
LAKE GENEVA, WISCONSIN

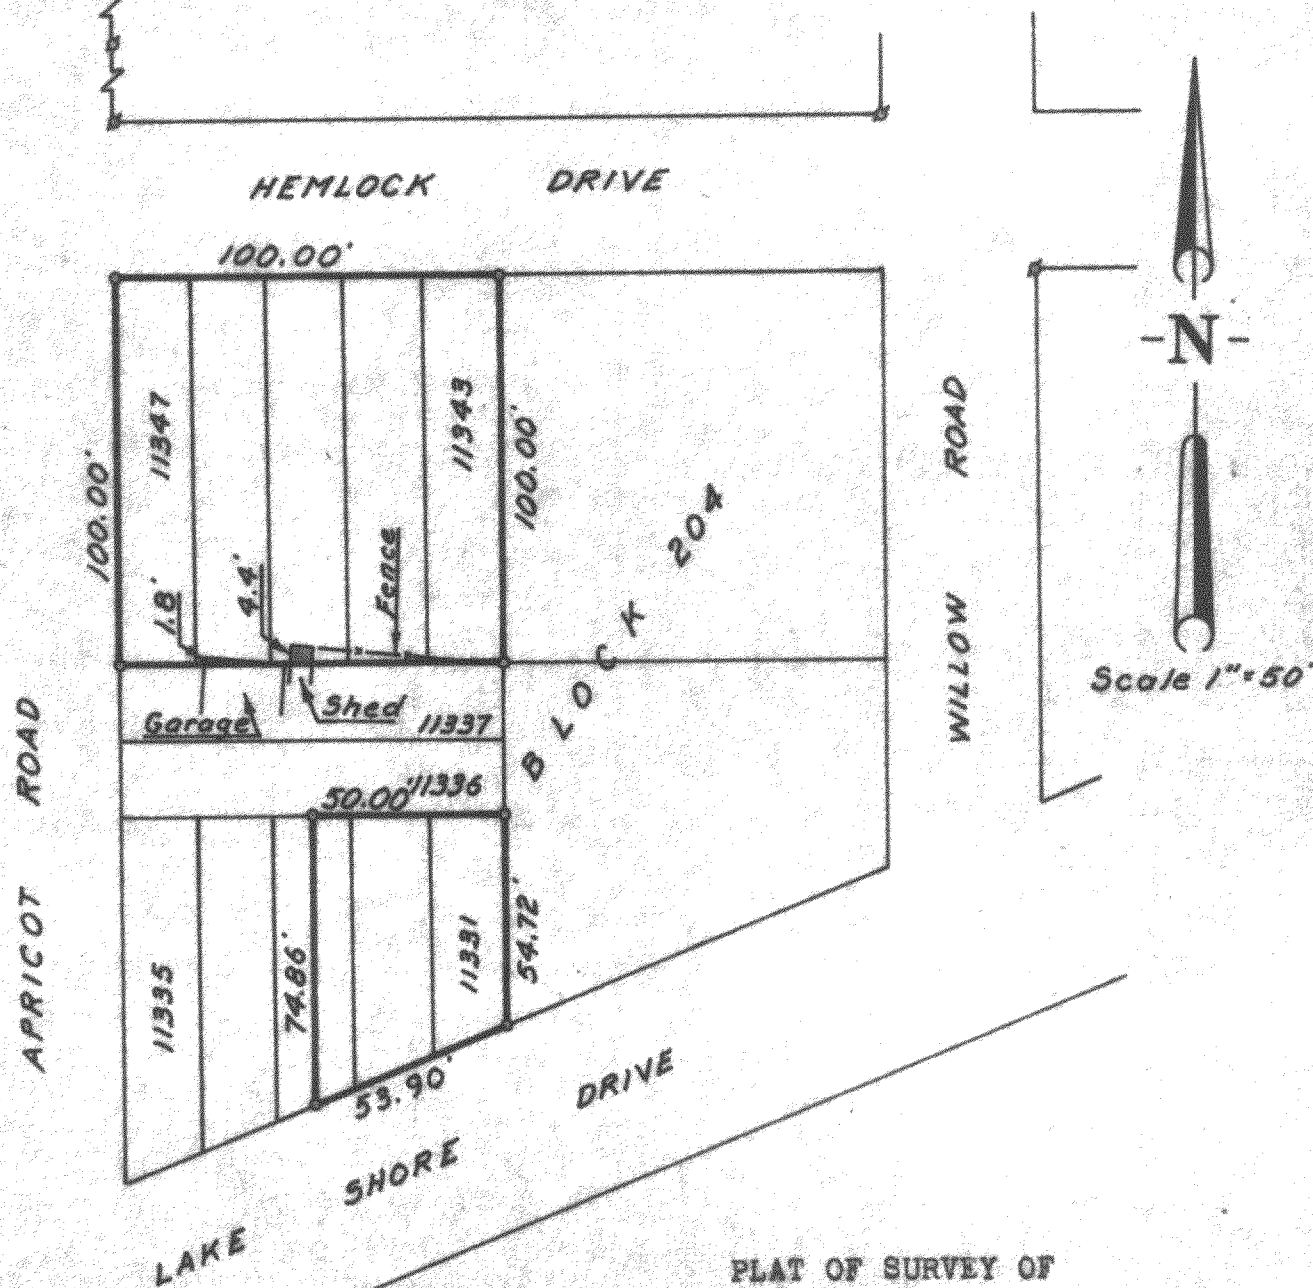

PLAT OF SURVEY OF

The East 1/2 of Lot 11333, and all of
Lots 11331, 11332, 11343, 11344, 11345
11346 and 11347, Block 204, Lake Como
Beach, Walworth County, Wisconsin.

Harold H. Kolb

Harold H. Kolb, Wisconsin Surveyor, S-187
DATE: April 25, 1964

SLCB-2463.2466

• Iron Pipe Found
• Iron Pipe Placed

217-146