


GOOSEBERRY

FERN ROAD.

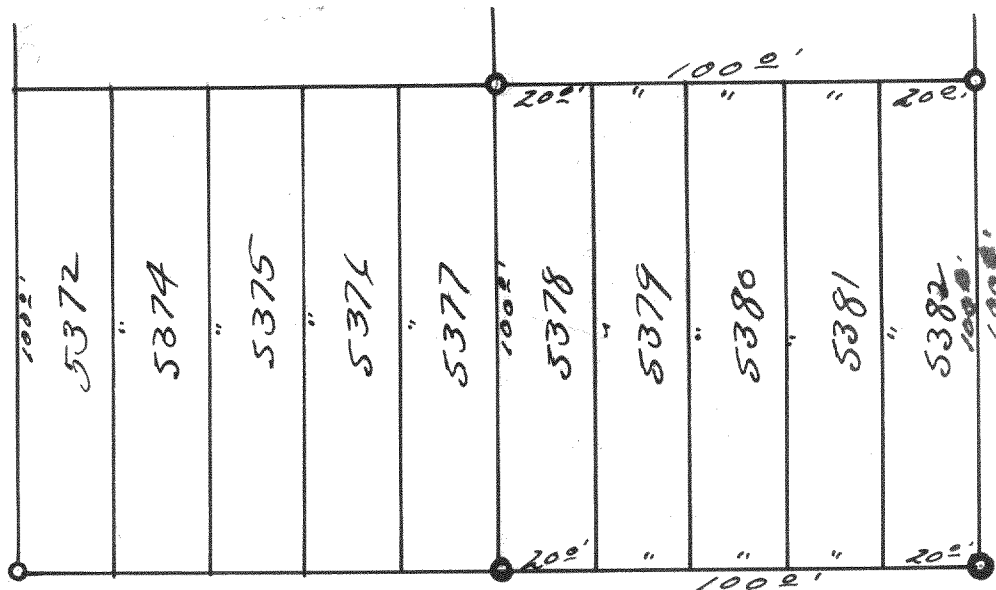

LINCOLN

DRIVE

ROAD.

DESCRIPTION:

Lots 5378, 5379, 5380, 5381 & 5382, Lake Como Beach Subdivision of portions of Sections 21, 22, 27, & 28, Town 2 north, Range 17 east, of the 4th Principal Meridian.

CERTIFICATE:

I, hereby certify that I have on this the 30th day of October 1952 surveyed the above described property.

SIGNED AND SEALED THIS 31ST DAY OF OCTOBER 1952.

Joseph M. Biagi, Professional Engineer.
Elkhorn Wisconsin.



52-48

50.0'

217-149B

52-48

52-48