


HAROLD H. KOLB
REGISTERED PROFESSIONAL LAND SURVEYOR
LAKE GENEVA, WISCONSIN

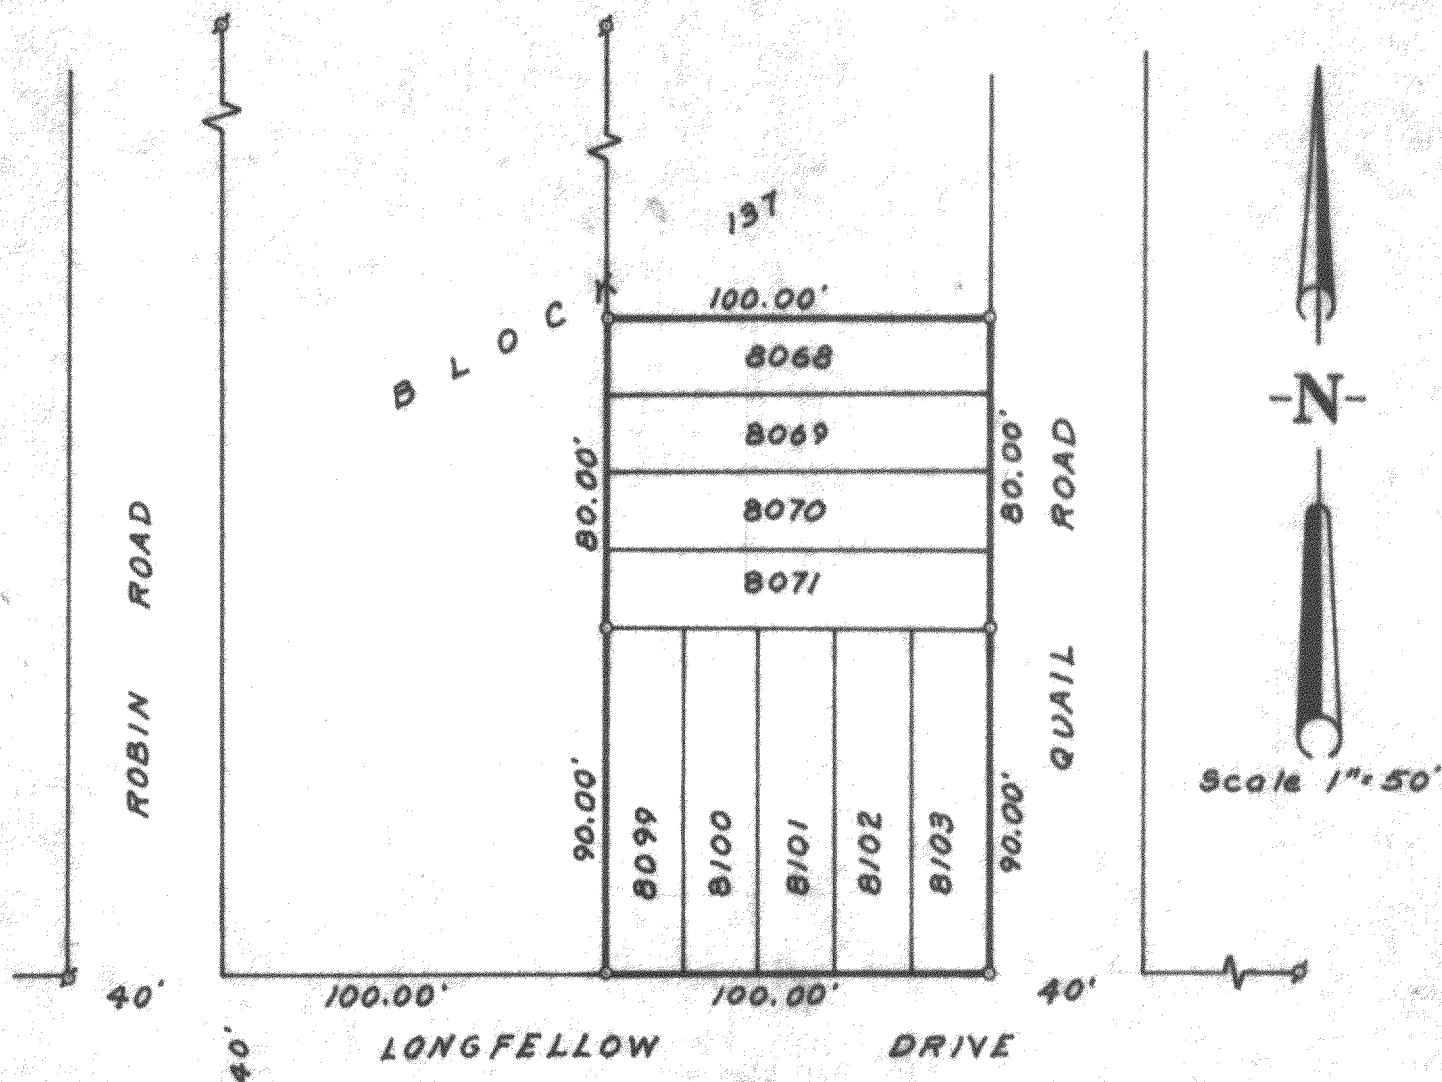

PLAT OF SURVEY OF
Lots 8068-8071 and 8099-8103, Block 137,
Lake Como Beach, T 2 N, R 17 E, Walworth
County, Wisconsin.

Harold H. Kolb

Harold H. Kolb, Wisconsin Surveyor, S-187

o - Iron Pipe Found
o - Iron Pipe Placed

JLCB-1718

217-155
5-3-63