


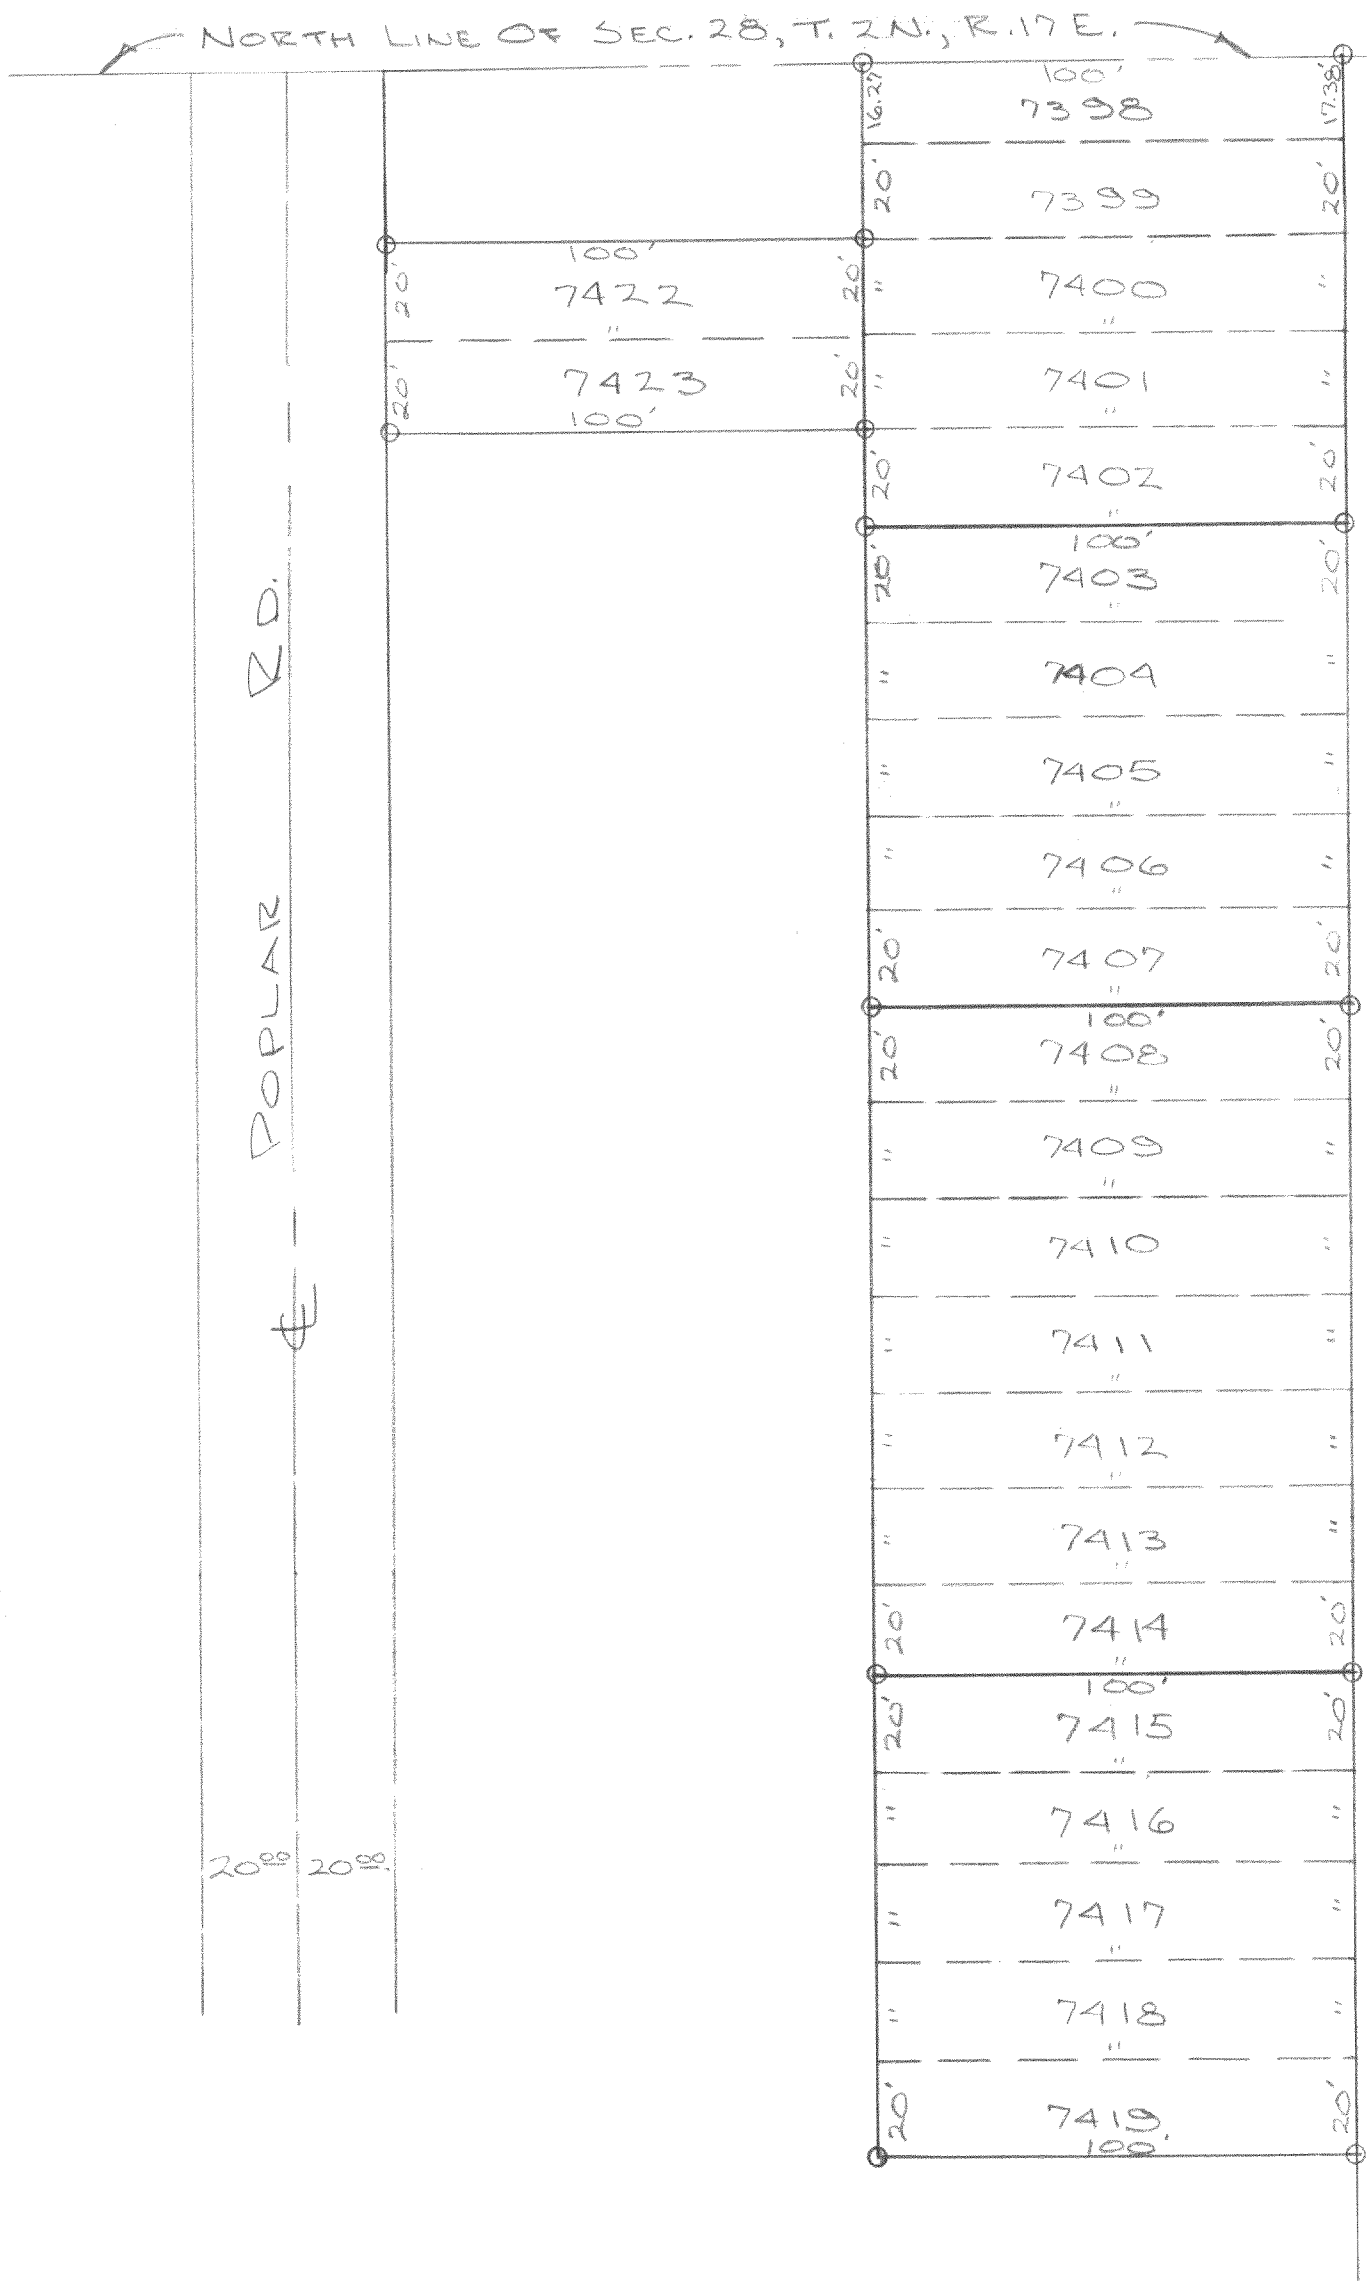


O INDICATES IRON PIPE

DESCRIPTION: Lots 7422 and 7423; Lots 7398 thru 7402 inclusive; Lots 7403 thru 7407 inclusive; Lots 7408 thru 7414 inclusive; and Lots 7415 thru 7419 inclusive of Block 127 of the First Map of Lake Como Beach Subdivision of a portion of Section 28, Town 2 north, Range 17 east, Geneva Township, Walworth County, Wisconsin.

CERTIFICATE: I, James F. Biagi, Surveyor hereby certify that I have surveyed the property hereon described.

James F. Biagi
James F. Biagi RL9 272
Elkhorn, Wisconsin.

Date: August 10th 1970.

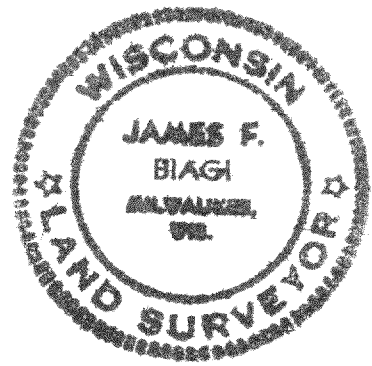

REVISIONS			FOUR LOT PLAT FOR		
NO.	DATE	BY	JOE PALINSKY		
1					
2					
3			DRAWN BY	SCALE	MATERIAL
4			CHK'D	DATE	DRAWING NO.
5			TRACED	APP'D	

JLB-1574, 1571, 1572, 1573, 1574