
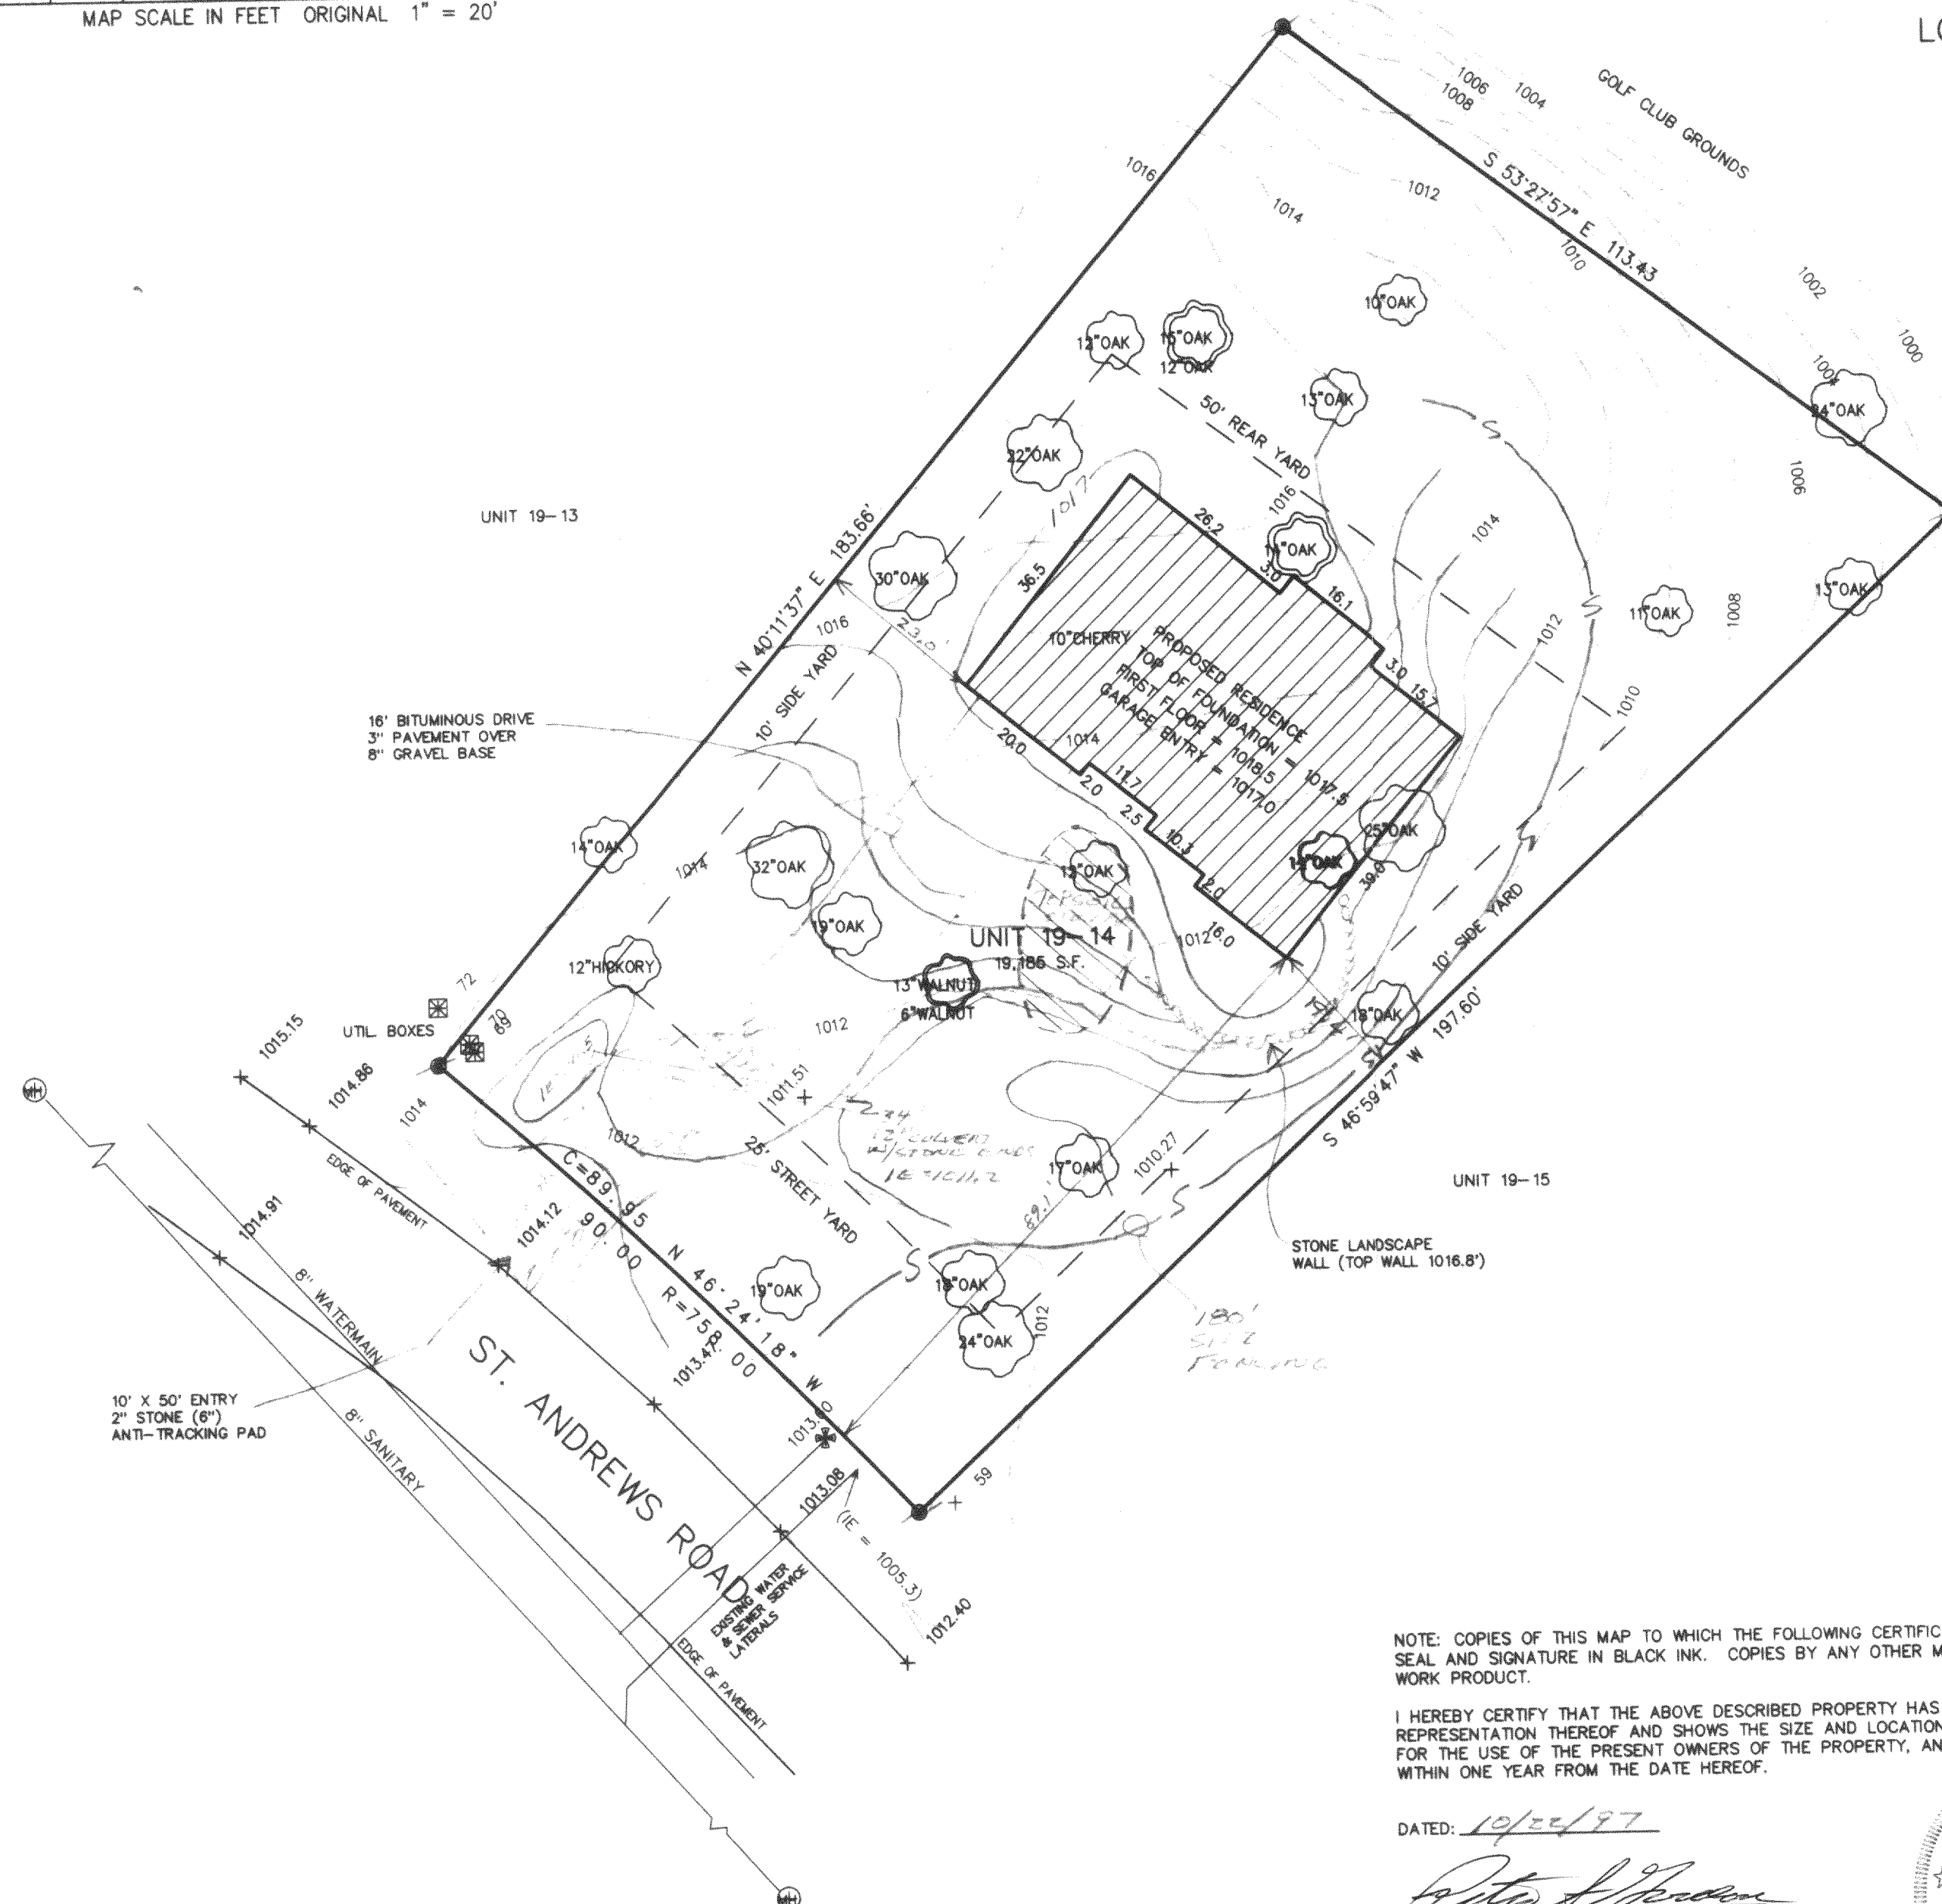


The diagram illustrates the Wisconsin Coordinate System. It features a horizontal line with a central point. To the left of this point is a vertical line segment labeled "GRID". To the right of the central point is a vertical line segment labeled "NORTH". Below the horizontal line, there is a label "WISCONSIN COORDINATE SYSTEM" and "SOUTH ZONE".

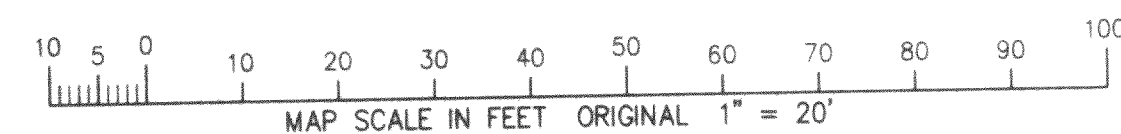

 = FOUND IRON REBAR STAKE
 = SET IRON REBAR STAKE
 (XXX) = RECORDED AS

WORK ORDERED BY
GENEVA HOMES
PO BOX 217
LAKE GENEVA, WI.

FARRIS, HANSEN & ASSOCIATES, INC.
Engineering, Architecture, Surveying
7 Ridgway Court P.O. Box 437
ELKHORN, WISCONSIN 53121
Office: (414) 723-2098
Fax: (414) 723-5886

REVISIONS


PROJECT NO.	3269.19-14
DATE:	10-09-97
SHEET NO.	1 OF 1

NOTE: COPIES OF THIS MAP TO WHICH THE FOLLOWING CERTIFICATE WILL APPLY ARE BLUE LINE PRINTS SHOWING SURVEYOR'S ORIGINAL SEAL AND SIGNATURE IN BLACK INK. COPIES BY ANY OTHER MEANS MAY HAVE ALTERATIONS WHICH DO NOT REPRESENT THE SURVEYOR'S WORK PRODUCT.

I HEREBY CERTIFY THAT THE ABOVE DESCRIBED PROPERTY HAS BEEN SURVEYED UNDER MY DIRECTION AND THAT THE ABOVE MAP IS A TRUE REPRESENTATION THEREOF AND SHOWS THE SIZE AND LOCATION OF THE PROPERTY AND ITS EXTERIOR BOUNDARIES. THIS SURVEY IS MADE FOR THE USE OF THE PRESENT OWNERS OF THE PROPERTY, AND ALSO THOSE WHO PURCHASE, MORTGAGE, OR GUARANTEE THE TITLE THERETO WITHIN ONE YEAR FROM THE DATE HEREOF.

DATED: 10/22/97


PETER S. GORDON R.L.S. 2101

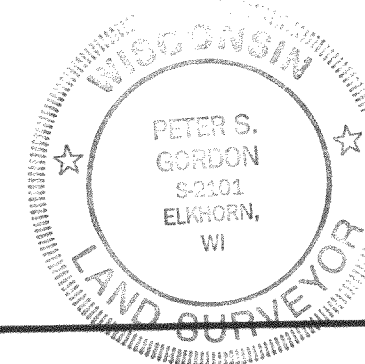

RECEIVED
NOV 7 1997

JCN-19-14
217-1593