


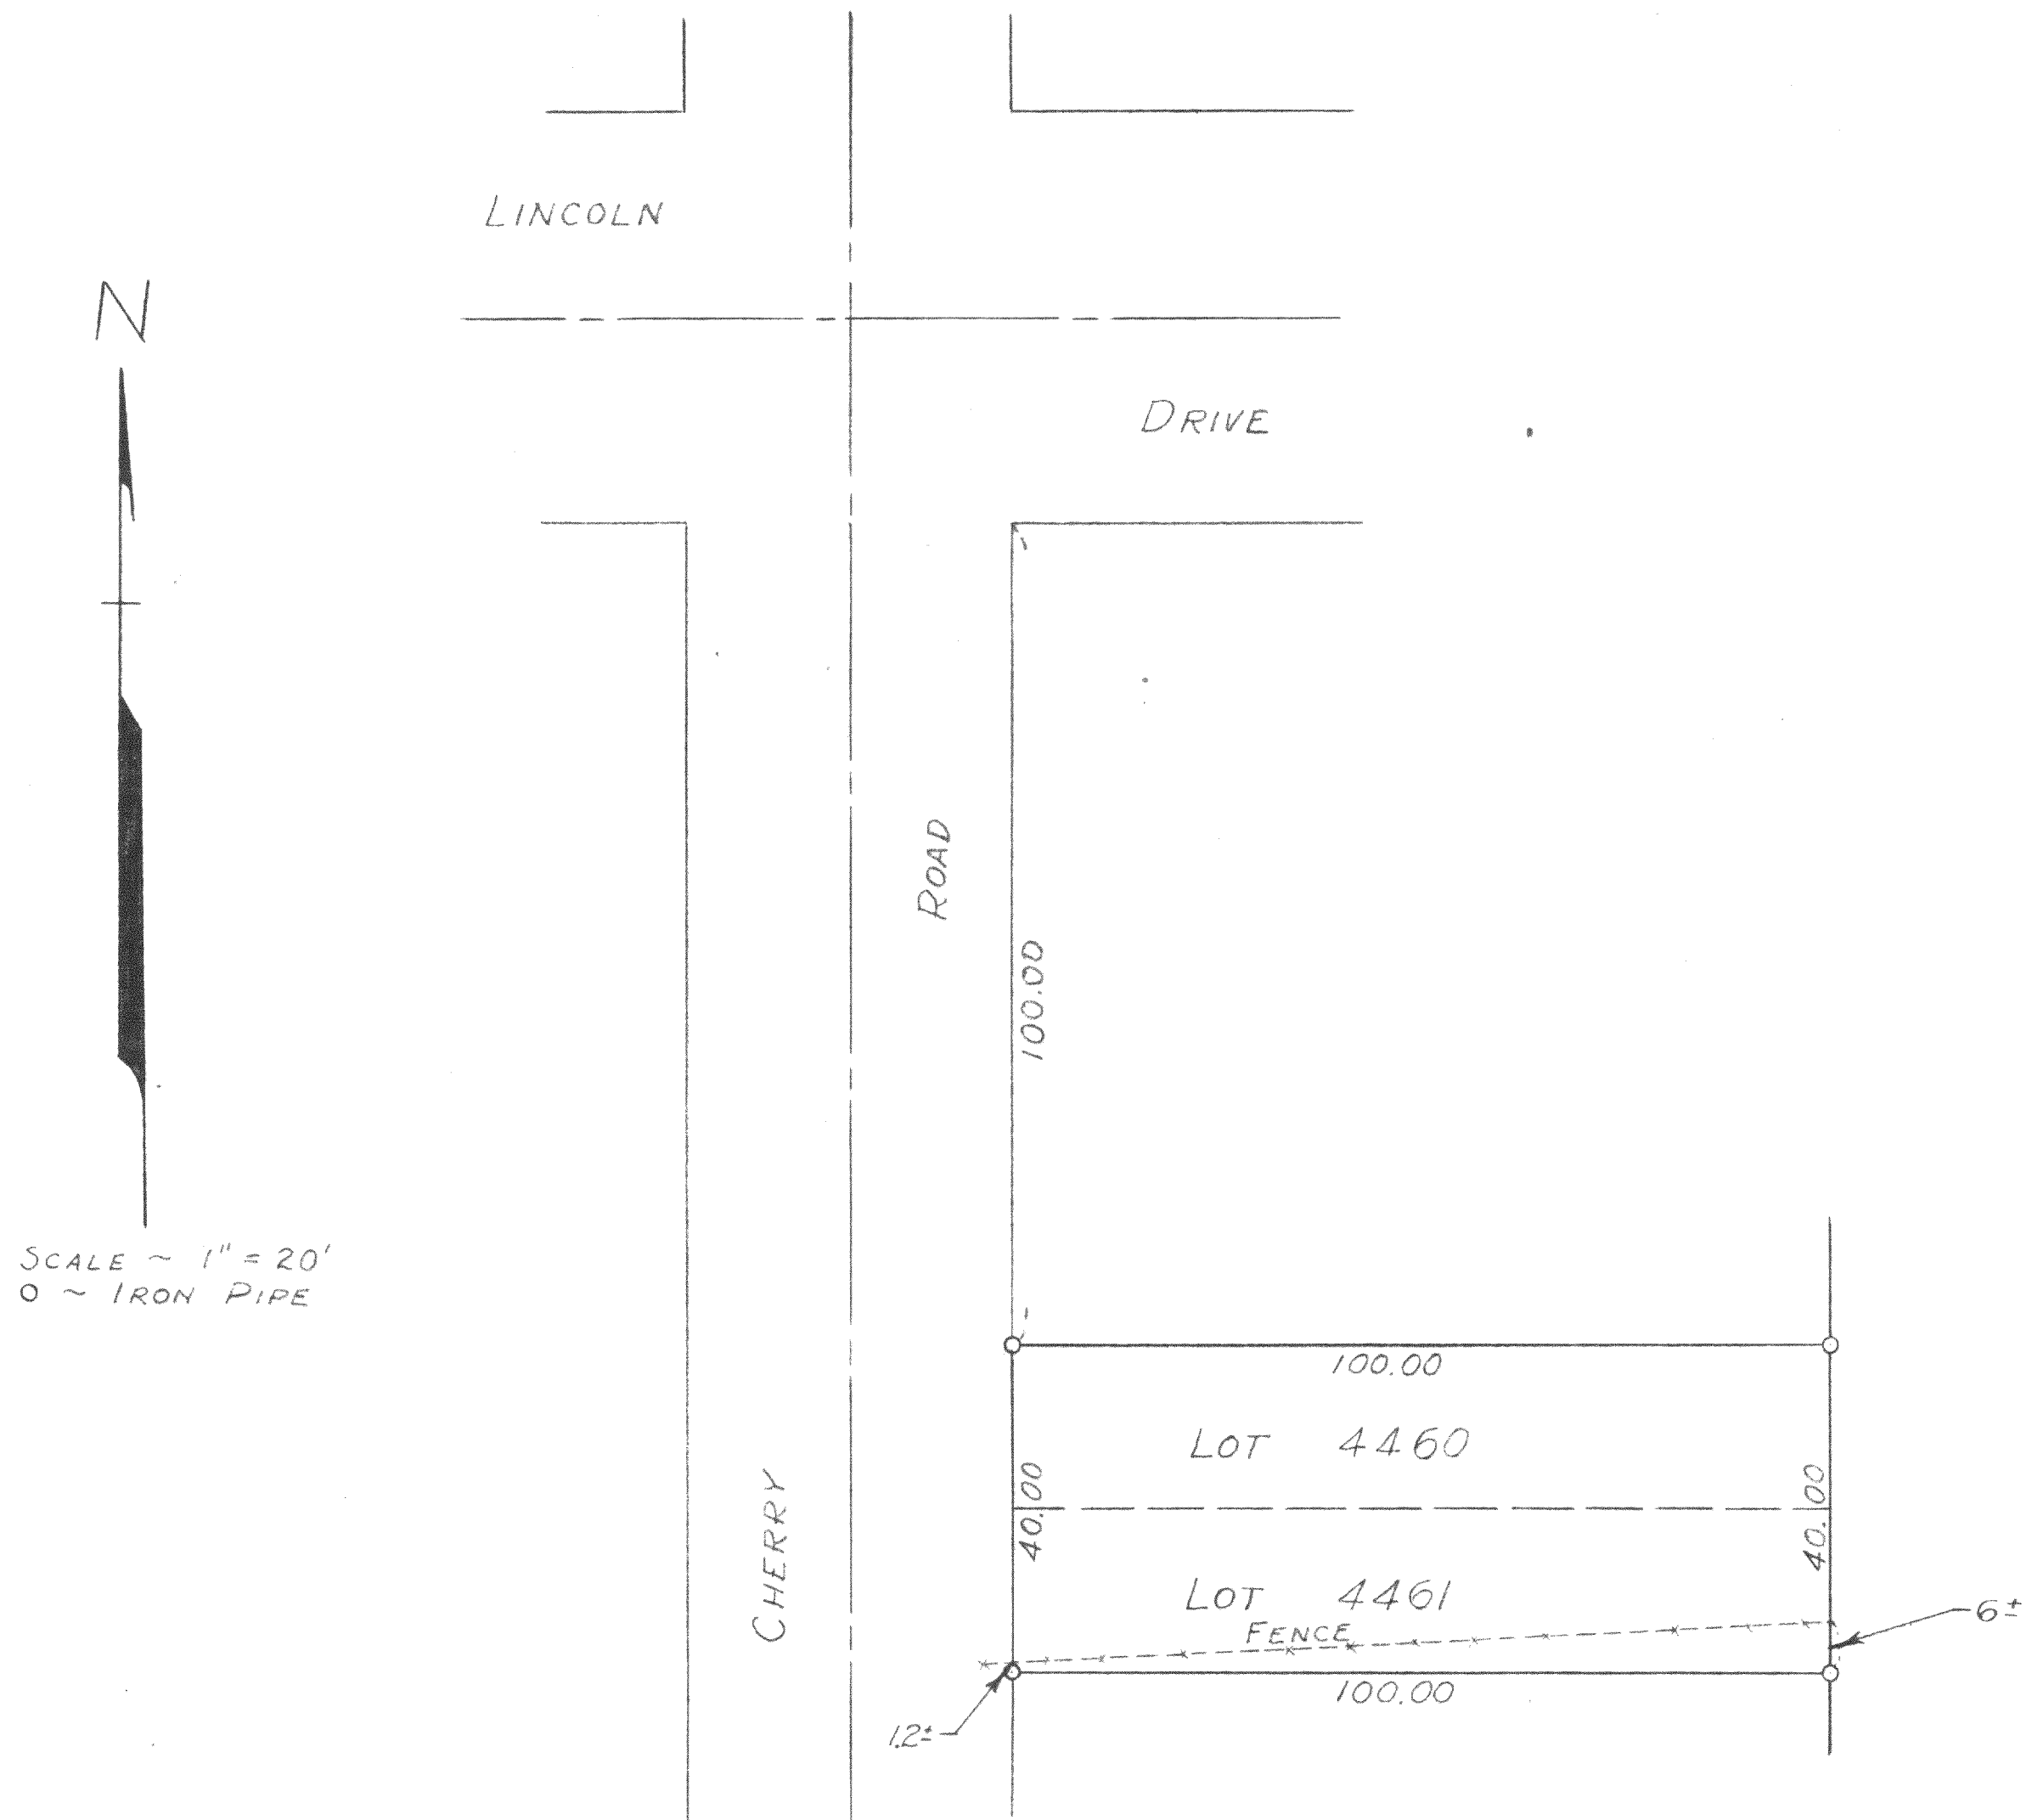

PLAT OF SURVEY OF LOTS 4460 AND 4461, LAKE COMO BEACH SUBDIVISIONS LOCATED  
IN THE TOWN OF GENEVA, WALWORTH COUNTY, WISCONSIN  
APRIL 25, 1958

George T. Dunham  
GEORGE T. DUNHAM, SURVEYOR  
DELAVER, WISCONSIN