



PLAT OF SURVEY OF

THE RESIDENCE ON CONDOMINIUM UNIT 19-15 GENEVA NATIONAL
LOCATED IN THE TOWN OF GENEVA, WALWORTH COUNTY, WISCONSIN.

NOTE: LAND SURVEY INFORMATION TAKEN FROM
SURVEY BY FARRIS, HANSEN AND ASSOCIATES

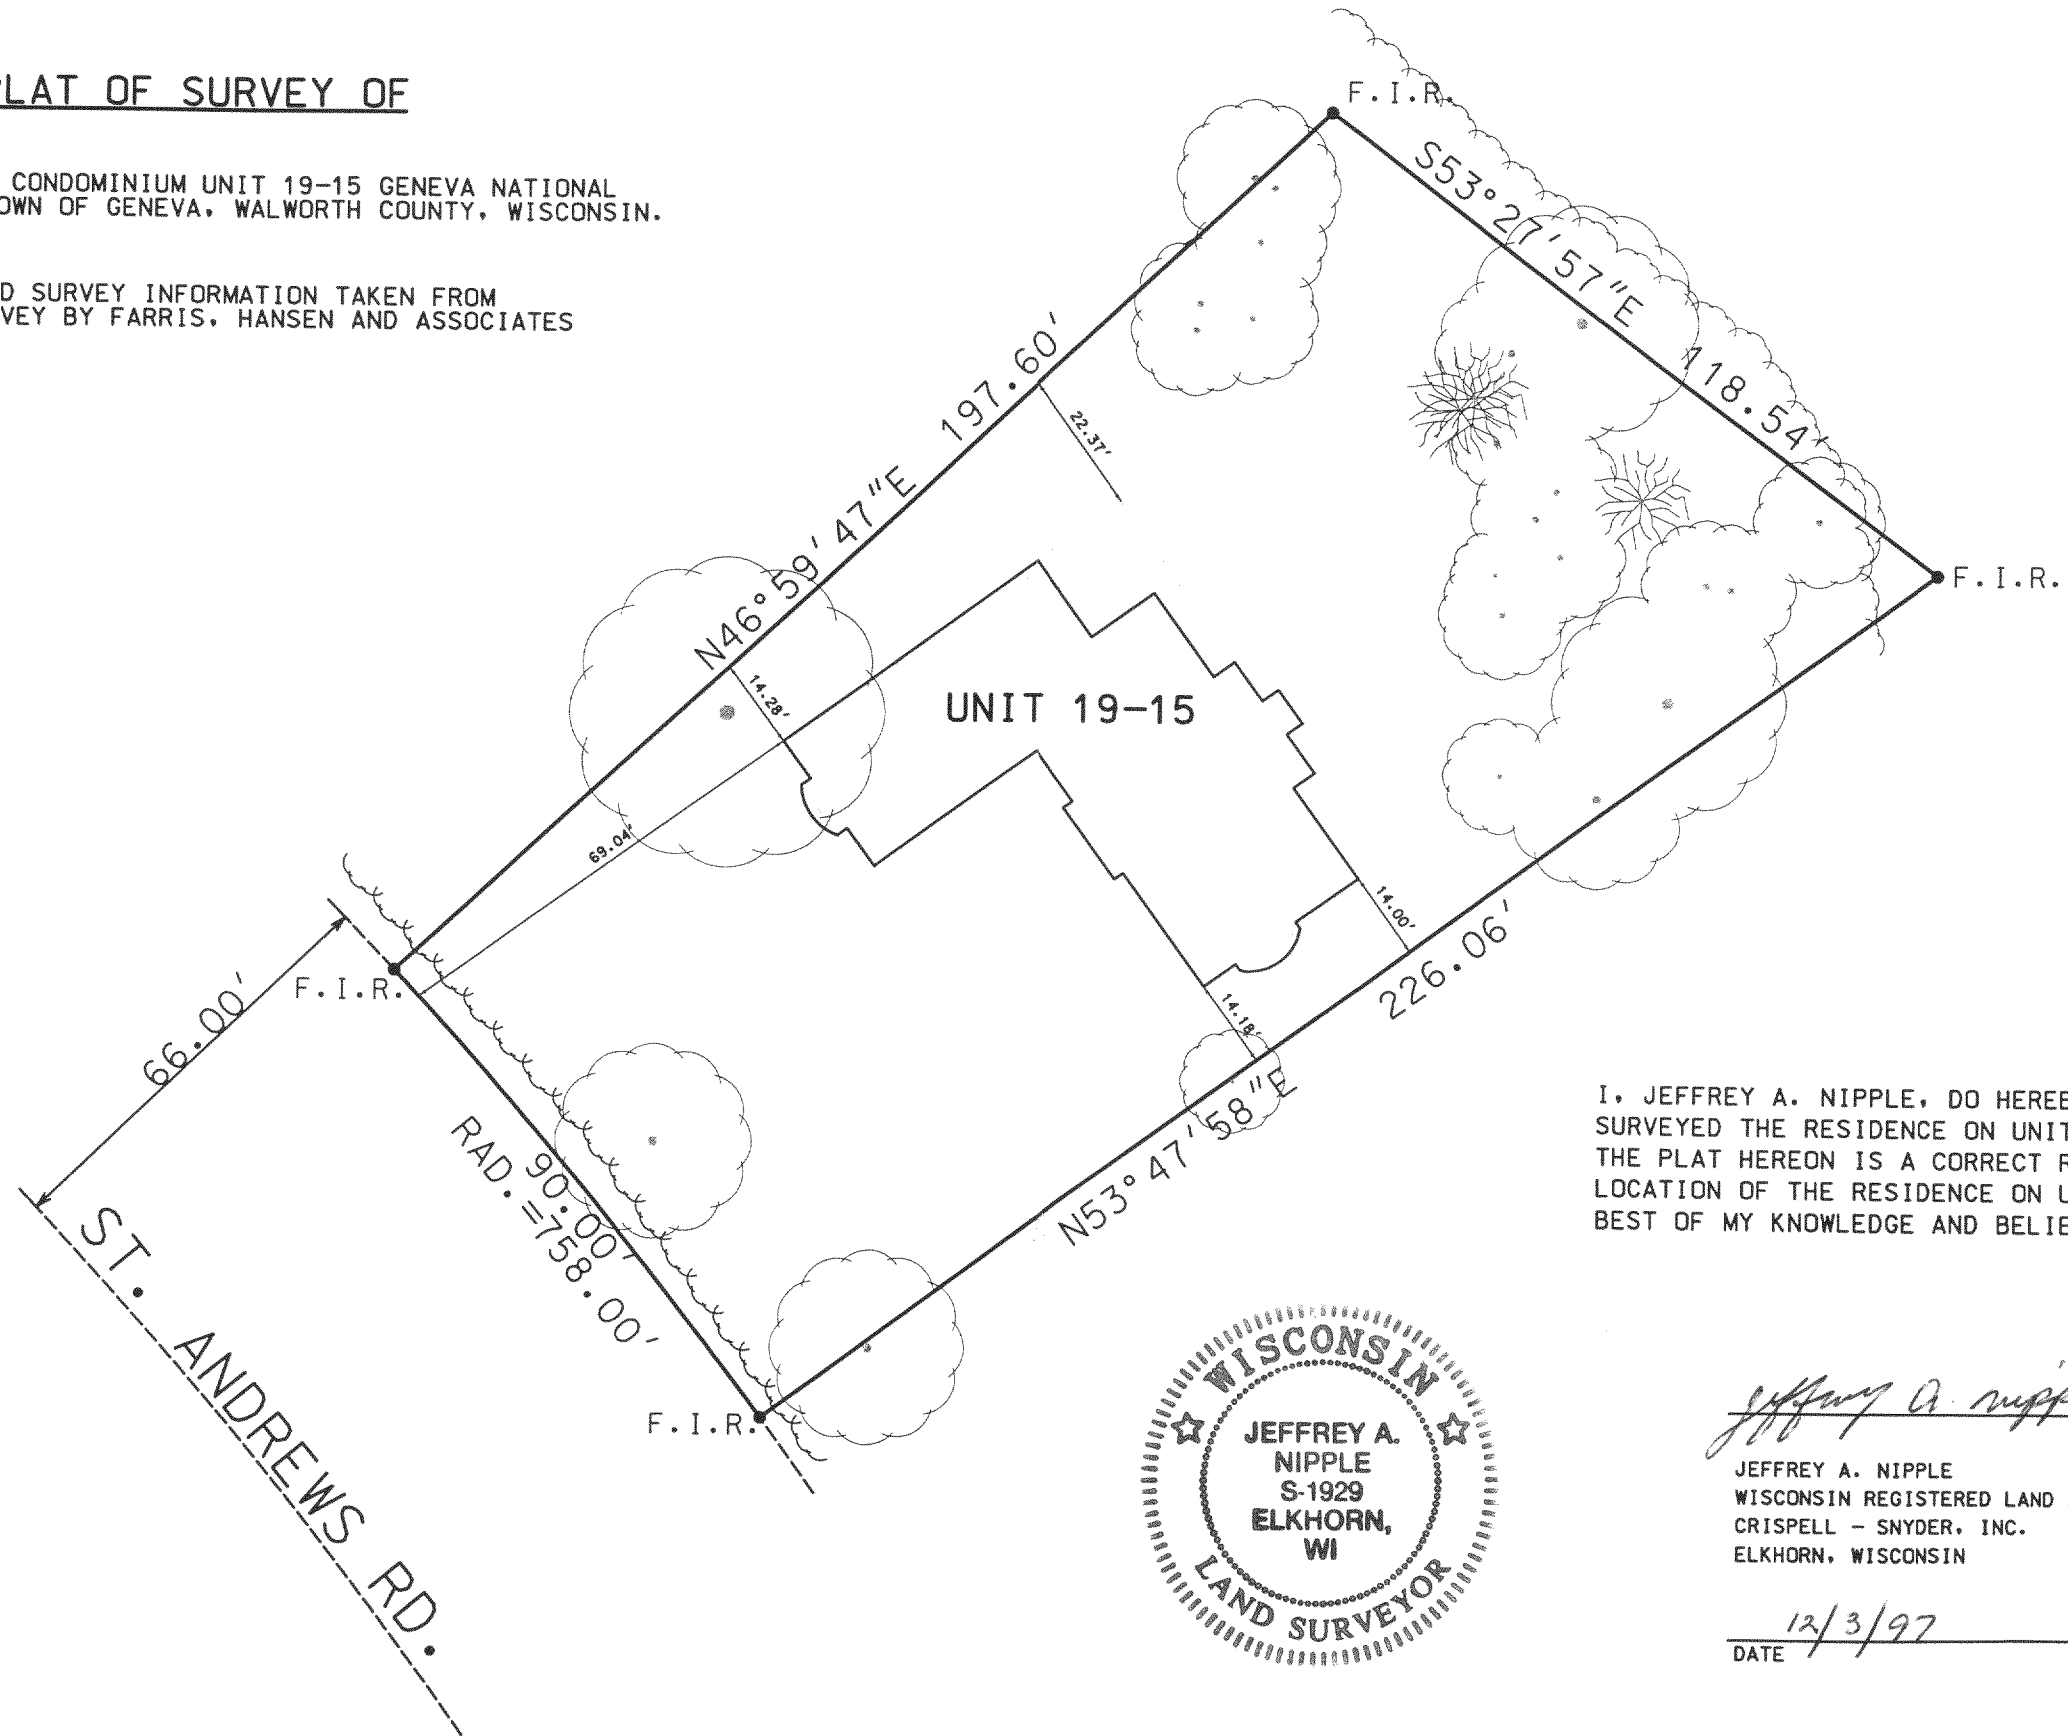


I, JEFFREY A. NIPPLE, DO HEREBY CERTIFY THAT I HAVE
SURVEYED THE RESIDENCE ON UNIT 19-15, AND THAT
THE PLAT HEREON IS A CORRECT REPRESENTATION OF THE
LOCATION OF THE RESIDENCE ON UNIT 19-15 TO THE
BEST OF MY KNOWLEDGE AND BELIEF.

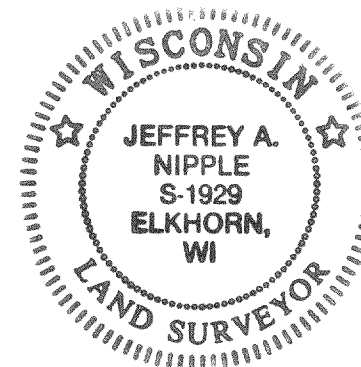

Jeffrey A. Nipple
JEFFREY A. NIPPLE
WISCONSIN REGISTERED LAND SURVEYOR, S-1929
CRISPELL - SNYDER, INC.
ELKHORN, WISCONSIN

12/3/97
DATE

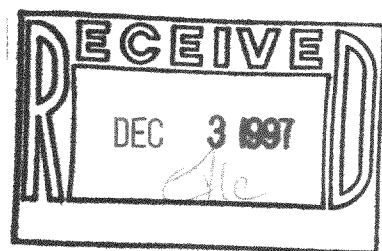

JGN 19-15

217-1600