


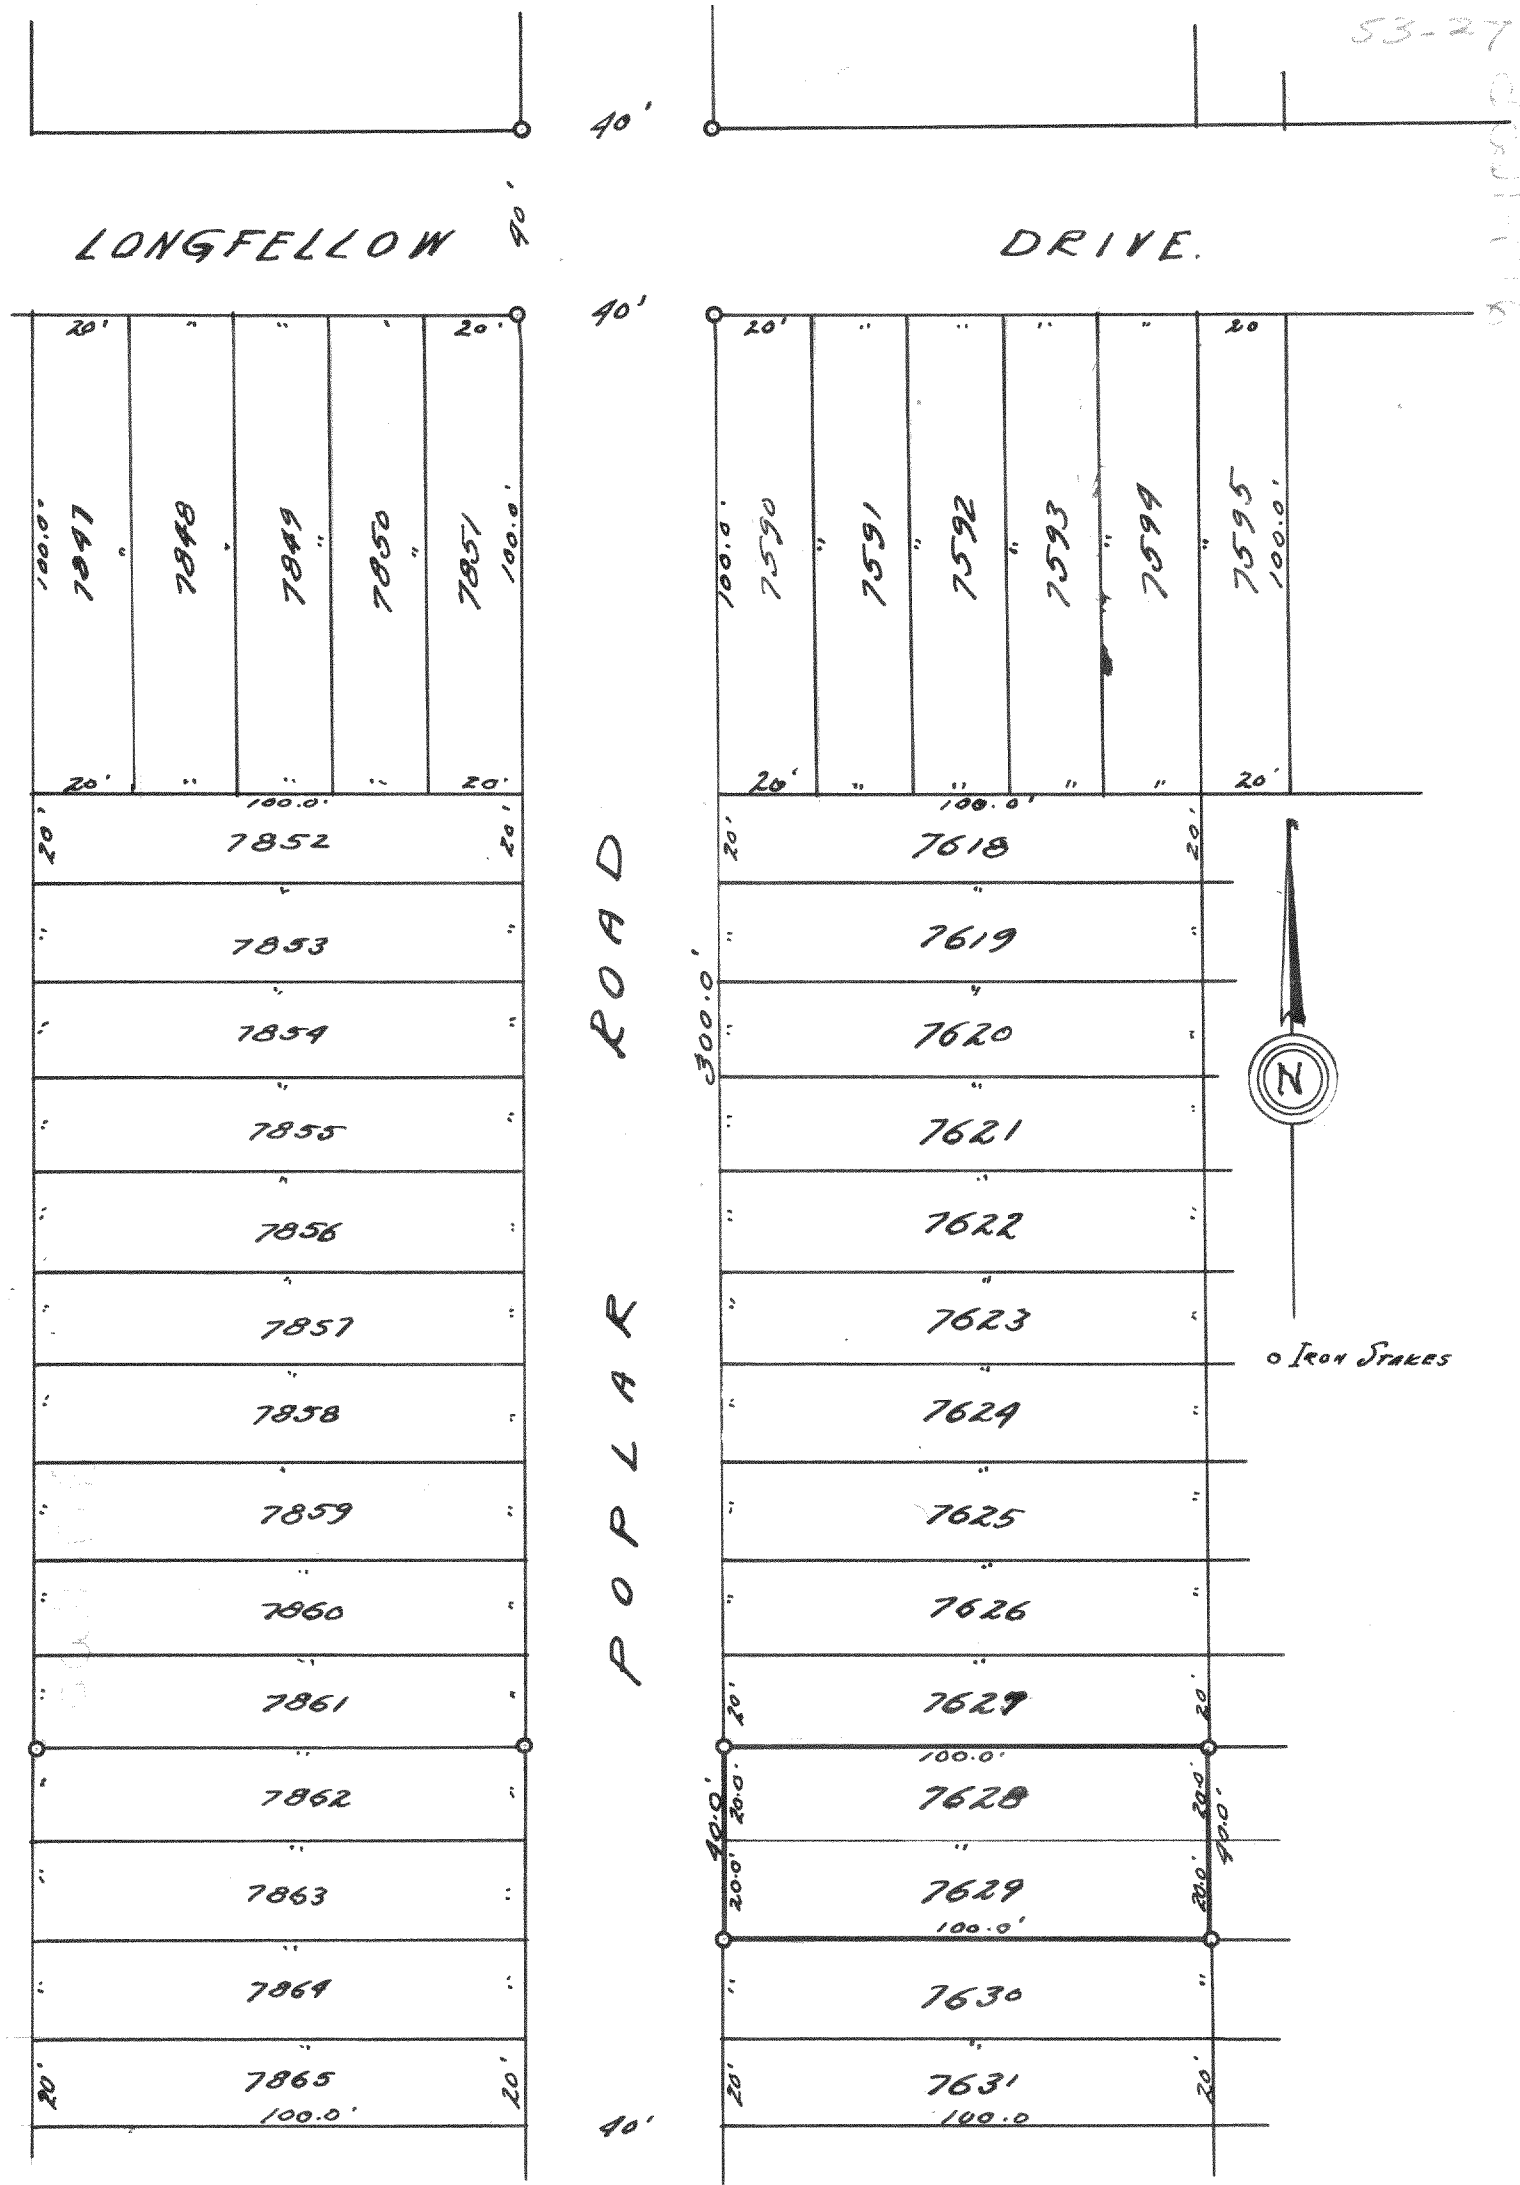

DESCRIPTION:

Lots 7628 & 7629, First Map of Lake Como Beach Subdivision of a portion of Geneva Township, Walworth County Wisconsin.

CERTIFICATE:

I, hereby certify that I, have surveyed the above described property, and that no encroachments exist.
SIGNED AND SEALED THIS 4TH DAY OF AUGUST 1953.

Joseph M. Biagi
Joseph M. Biagi, Professional Engr.
Elkhorn Wisconsin.