


Wisconsin Registered Land Surveyor S-1594

Rt. 3, Box 273
Elkhorn, Wisconsin 53121
Phone: (414) 723-4260 (office)
(414) 723-7209 (FAX)

LOTS 9490-9493, INCLUSIVE AND LOTS 9503-9509, INCLUSIVE, ALL OF BLOCK 171, LAKE COMO BEACH SUBDIVISION, LOCATED IN SECTION 21, TOWN 2 NORTH, RANGE 17 EAST, WALWORTH COUNTY, WISCONSIN.

ORDERED BY: ATTORNEY KENNETH CONELL
415 BROAD ST.
LAKE GENEVA, WI. 53147


PLAT OF SURVEY

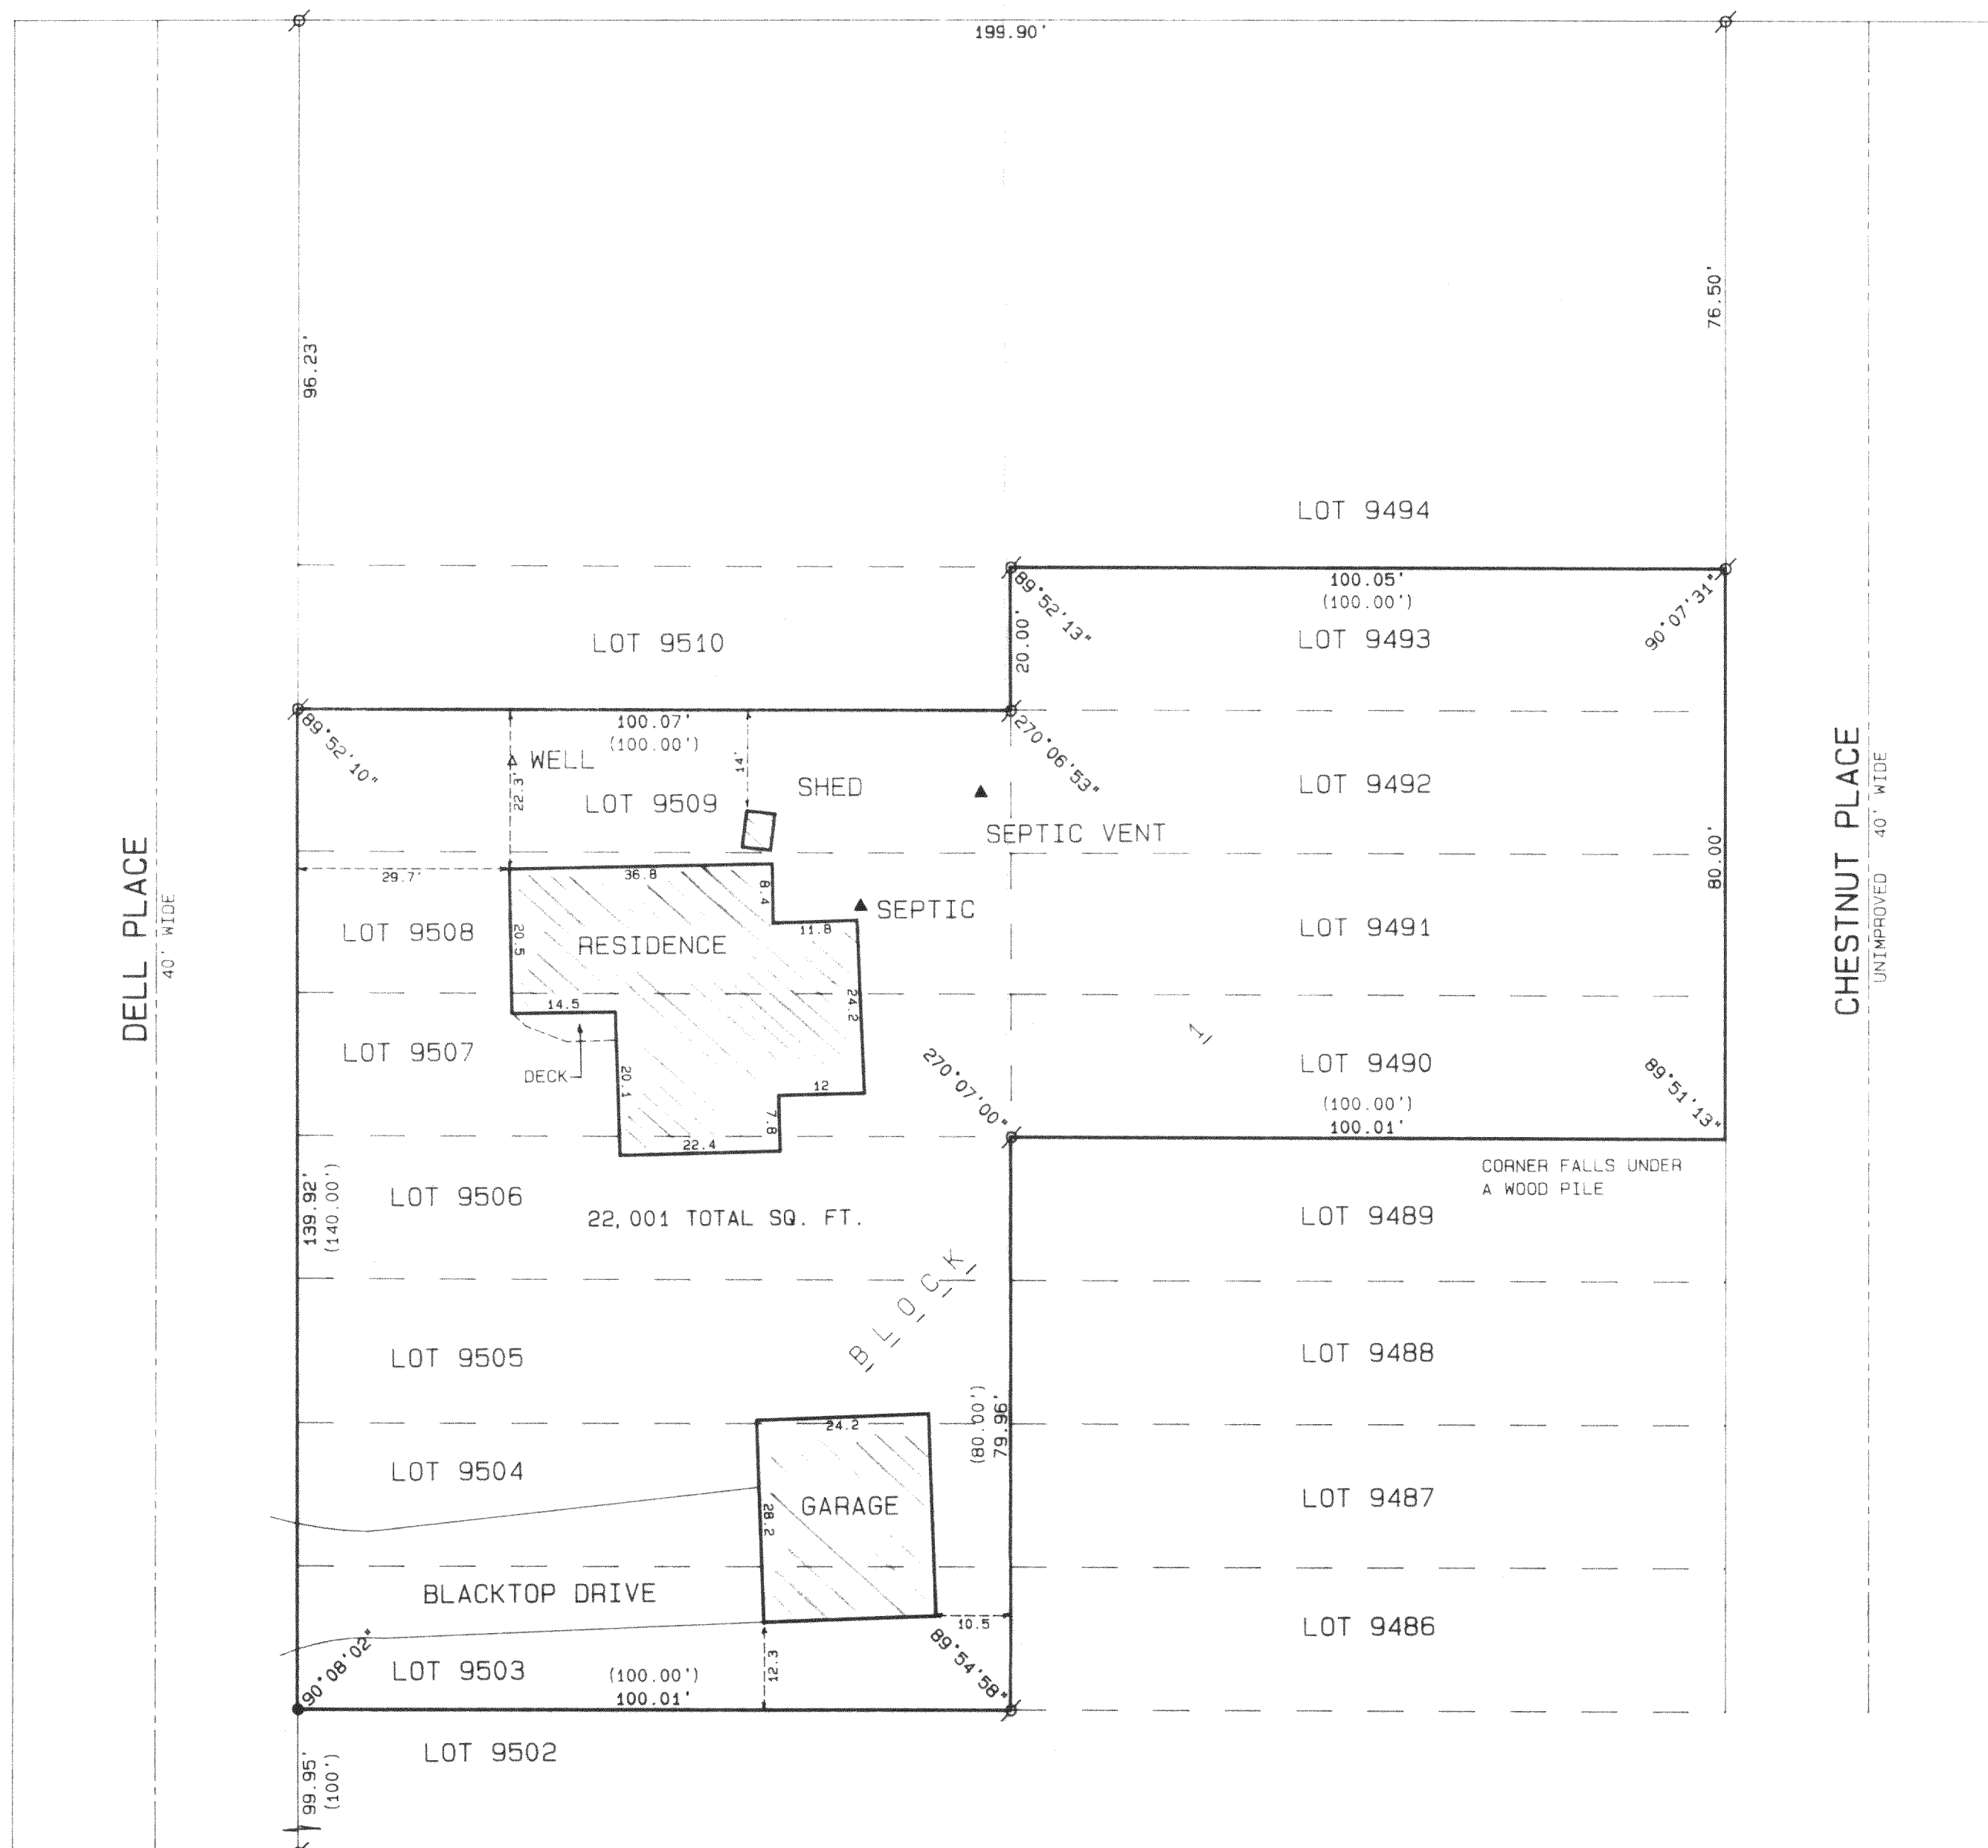

SCALE: 1" = 20 FEET

Legend

- FOUND IRON PIPE
 - FOUND IRON ROD
 - FOUND BRASS CAPPED MONUMENT
 - FOUND CONCRETE MONUMENT
 - + CHISEL CUT IN CONCRETE
 - SET IRON ROD, 24" LONG, WEIGHING 1.5 LBS./LINEAL FT., 3/4" DIA.
 - SET IRON ROD, 30" LONG, WEIGHING 4.5 LBS./LINEAL FT., 1-11/16" DIA.
- (xx) RECORDED AS DIMENSION
- X --
EXISTING FENCE

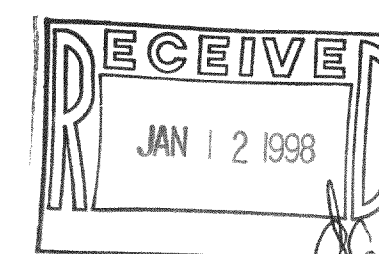

SCALE: 1"=20 FEET


"I hereby certify that the above described property has been surveyed by me or under my direction and that the above map is a true representation thereof. It shows the size and location of the property, its exterior boundaries, the location of all visible structures and dimensions of all principal buildings thereon, boundary fences, apparent easements, roadways and visible encroachments, if any."

"This survey is made for the use of the present owners of the property and also those who purchase, mortgage, or guarantee the title thereto within the year from date hereof."

A.

KENNETH B. ABERNATHY, JR.
 WISCONSIN REGISTERED LAND SURVEYOR
 S-1594

Date: 12-10-97 Job No. 97.1204

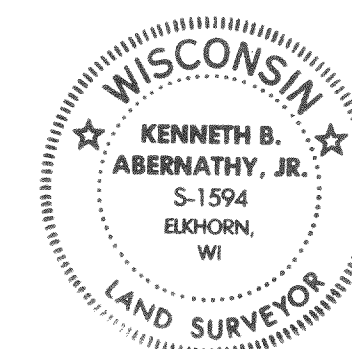

217-1616
JLCB-2049