



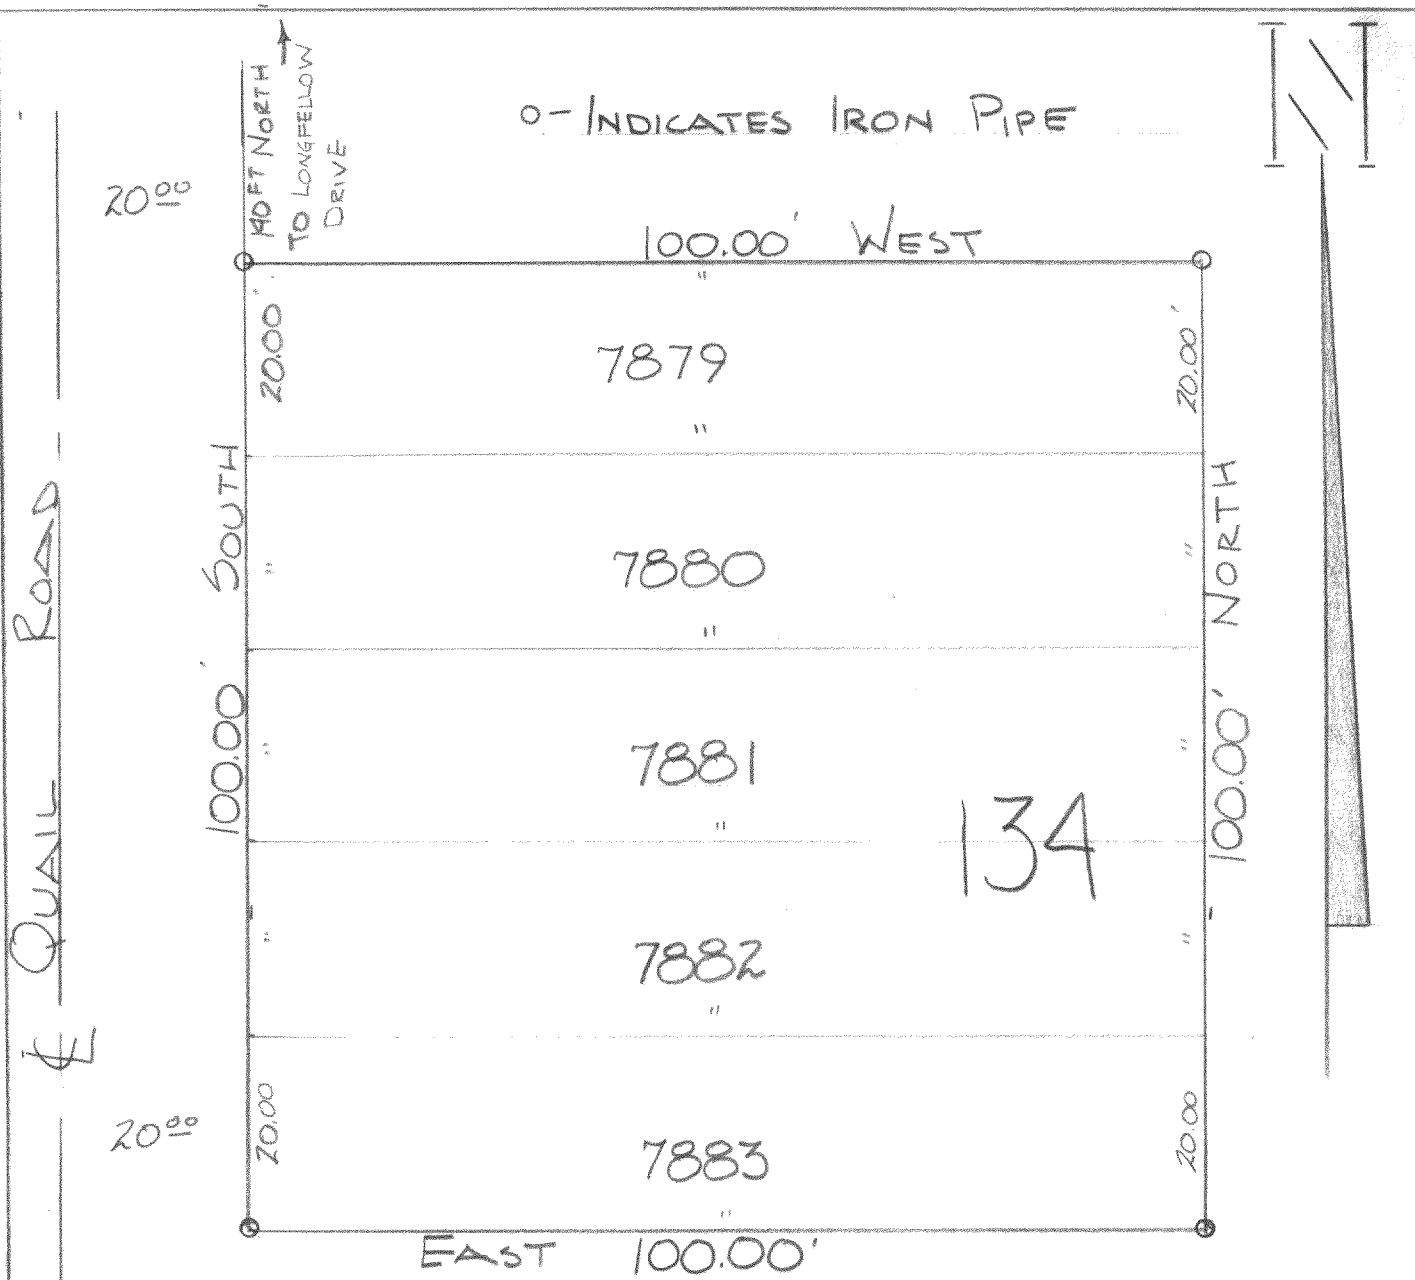

DESCRIPTION:

Lots 7879, 7880, 7881, 7882, and 7883 in Block 134 of the first map of Lake Como Beach Subdivision, in the Town of Geneva, Walworth County, Wisconsin.

CERTIFICATE: I, James F. Biagi, surveyor do hereby certify that I have surveyed the property hereon described on this 24th day of April 1961.

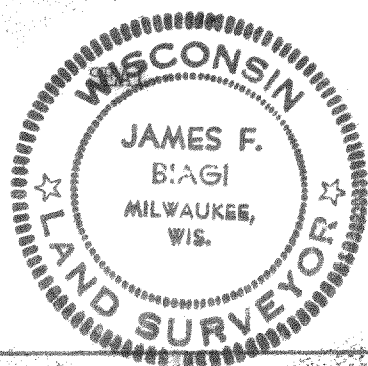

*James F. Biagi*

James F. Biagi (RLS272)