

PLAT OF SURVEY


PATHFINDER SURVEYING
FORMERLY KOLB LAND CONSULTING
929 WILLIAMS ST. LAKE GENEVA, WI.
(414) 248-3697

ORDERED BY : TIM SWATEK

DATE: 4 / 2 / 1998

ALLEN HARRISON WILLIAMS
MCDONELL & SWATEK
527 CENTER STREET.
LAKE GENEVA, WI. 53147

LEGEND

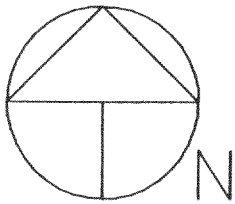

SCALE 1" = 20'



FOUND 1 IN. DIA. IRON PIPE




SEPTIC MANHOLE

(XXXX)

RECORDED AS

— x — FENCE

C.L. LARCH ROAD (40' WIDE)

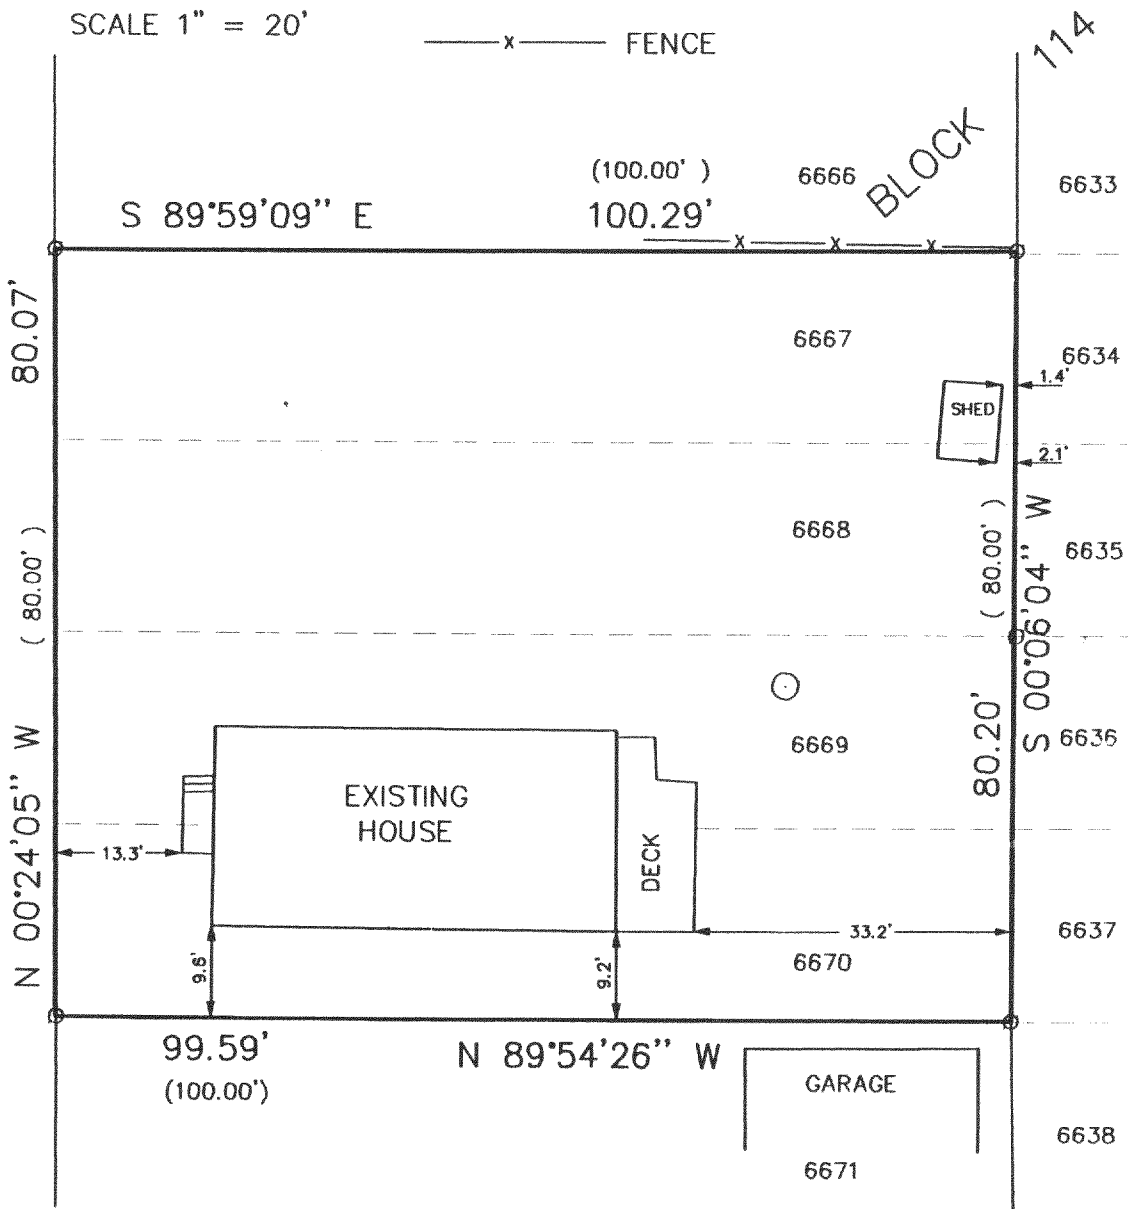



DESCRIPTION:

LOTS 6667, 6668, 6669, AND 6670 OF LAKE COMO BEACH SUBDIVISION,
LOCATED IN SECTION 28, TOWN 2 NORTH, RANGE 17 EAST, WALWORTH
COUNTY, WISCONSIN.

THE ABOVE MAP IS A TRUE REPRESENTATION THEREOF AND
SHOWS THE SIZE AND LOCATION OF ALL THE PROPERTY,
EXTERIOR BOUNDARIES, THE LOCATION OF ALL VISIBLE
BOUNDARY FENCES, APPARENT EASEMENTS, ROADWAYS
AND VISIBLE ENCROACHMENTS, IF ANY.

THIS SURVEY IS MADE FOR THE USE OF THE PRESENT
OWNERS OF THE PROPERTY, AND ALSO THOSE WHO
PURCHASE, MORTGAGE OR GUARANTEE TITLE THERETO
WITHIN ONE (1) YEAR FROM DATE HERETO.

John P. Krott
JOHN P. KROTT, R.L.S. 2258

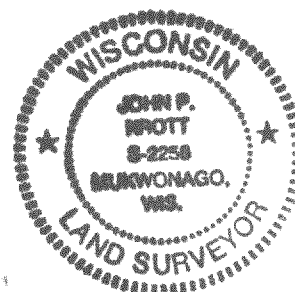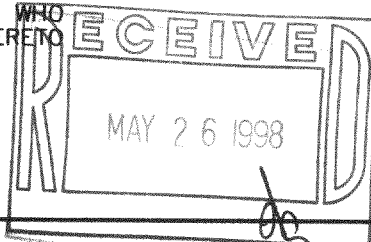

NOTE: THIS IS NOT A CERTIFIED COPY
UNLESS SEAL IS IN RED.
JOB NUMBER 98052 2-17-JLCB01396

JLCB-1396 217-1636