

PLAT OF SURVEY


PATHFINDER SURVEYING
FORMERLY KOLB LAND CONSULTING
929 WILLIAMS STREET LAKE GENEVA, WI. 53147
(414) 248-3697

ORDERED BY:

COLDWELL BANKER GENEVA LAKES
838 W. MAIN STREET
LAKE GENEVA, WI. 53147

DATE: 4-8-1998

DESCRIPTION: UNIT 19 - 04 IN GENEVA NATIONAL CONDOMINIUM NO 19 LOCATED IN THE NW 1/4 SEC. 29 T.2.N , R.17.E.
WALWORTH COUNTY, WISCONSIN.

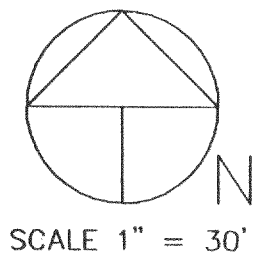

UNIT 19 - 03



LEGEND



- FOUND 1/2" DIA. IRON ROD
- SET 1" DIA. IRON PIPE
- TELEPHONE PEDESTAL
- ELECTRIC PEDESTAL
- (XXX) RECORDED AS

BEARINGS ARE REFERENCED TO THE RECORDED PLAT OF
UNIT 19 GENEVA NATIONAL CONDOMINIUM.

THE ABOVE MAP IS A TRUE REPRESENTATION THEREOF AND
SHOWS THE SIZE AND LOCATION OF ALL THE PROPERTY,
EXTERIOR BOUNDARIES, THE LOCATION OF ALL VISIBLE
BOUNDARY FENCES, APPARENT EASEMENTS, ROADWAYS
AND VISIBLE ENCROACHMENTS, IF ANY

THIS SURVEY IS MADE FOR THE USE OF THE PRESENT
OWNERS OF THE PROPERTY, AND ALSO THOSE WHO
PURCHASE, MORTGAGE OR GUARANTEE TITLE THERETO
WITHIN ONE (1) YEAR FROM DATE HERETO.

JOHN P. KROTT, R.L.S. 2258

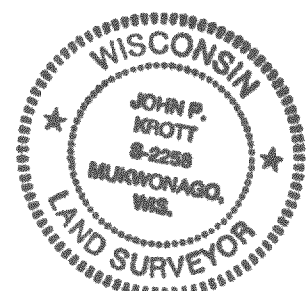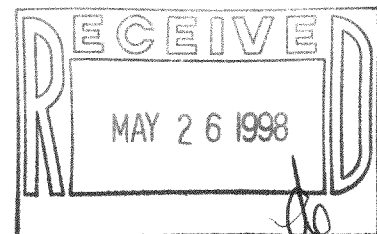

NOTE: THIS IS NOT A CERTIFIED COPY
UNLESS SEAL IS IN RED.
JOB NUMBER: 98043 2-17-JGN 1900014

JGN-19-4
217-1637