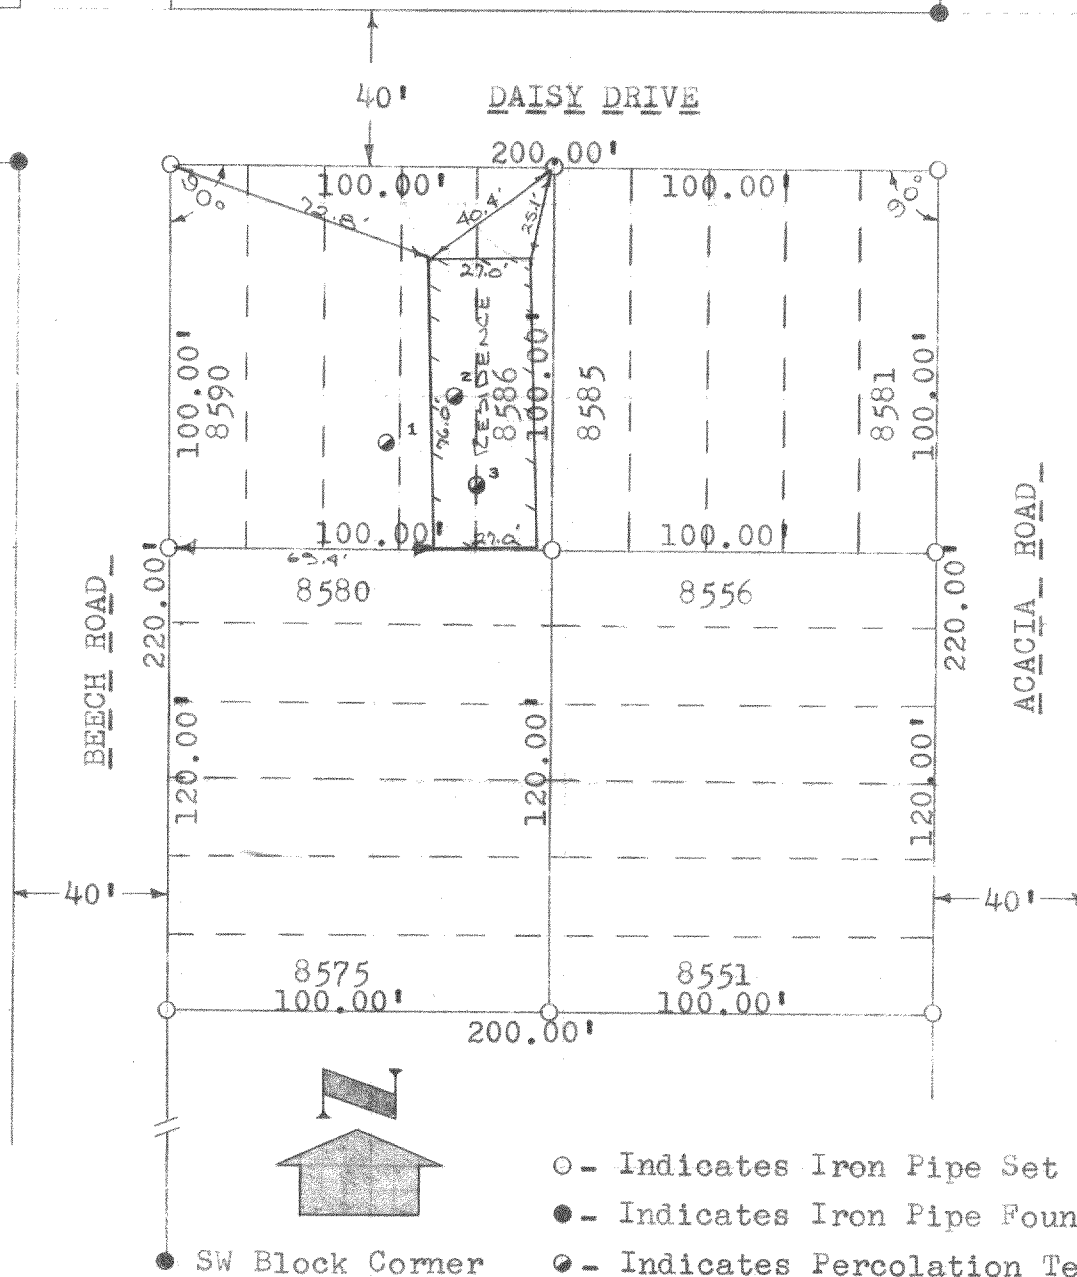


DESCRIPTION:

Lots 8551 thru 8556, Lots 8575 thru 8580, Lots 8581 thru 8585, and Lots 8586 thru 8590 of Lake Como Beach Plats, Section 21, T2N, R17E, Walworth County, Wisconsin.


CERTIFICATE:

I, James F. Biagi, surveyor, do hereby certify that I have surveyed the lands hereon described.

DATE:

May 6, 1971

James F. Biagi
James F. Biagi R.L.S. 272

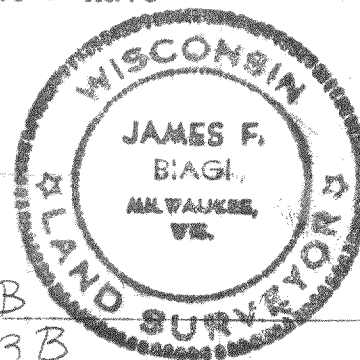

JLCB-1836, 1831A, 1837

216-163B

217-163B