

PLAT OF SURVEY

PATHFINDER SURVEYING
FORMERLY KOLB LAND CONSULTING
929 WILLIAMS STREET LAKE GENEVA, WI. 53147
(414) 870-1894

ORDERED BY: JOSEPH HOGAN

DATE: 7-01-1998


DESCRIPTION:
LOTS 4467-4475, BLOCK 77, LAKE COMO BEACH SUBDIVISION
LOCATED IN SEC. 27 & 28, T2N, R17E, WALWORTH COUNTY,
WISCONSIN.



SCALE 1"=30'

LEGEND



- IRON PIPE FOUND
- 1" IRON PIPE SET
WEIGHING 1.13#/LIN.FT.
- MAN HOLE
- () RECORDED AS

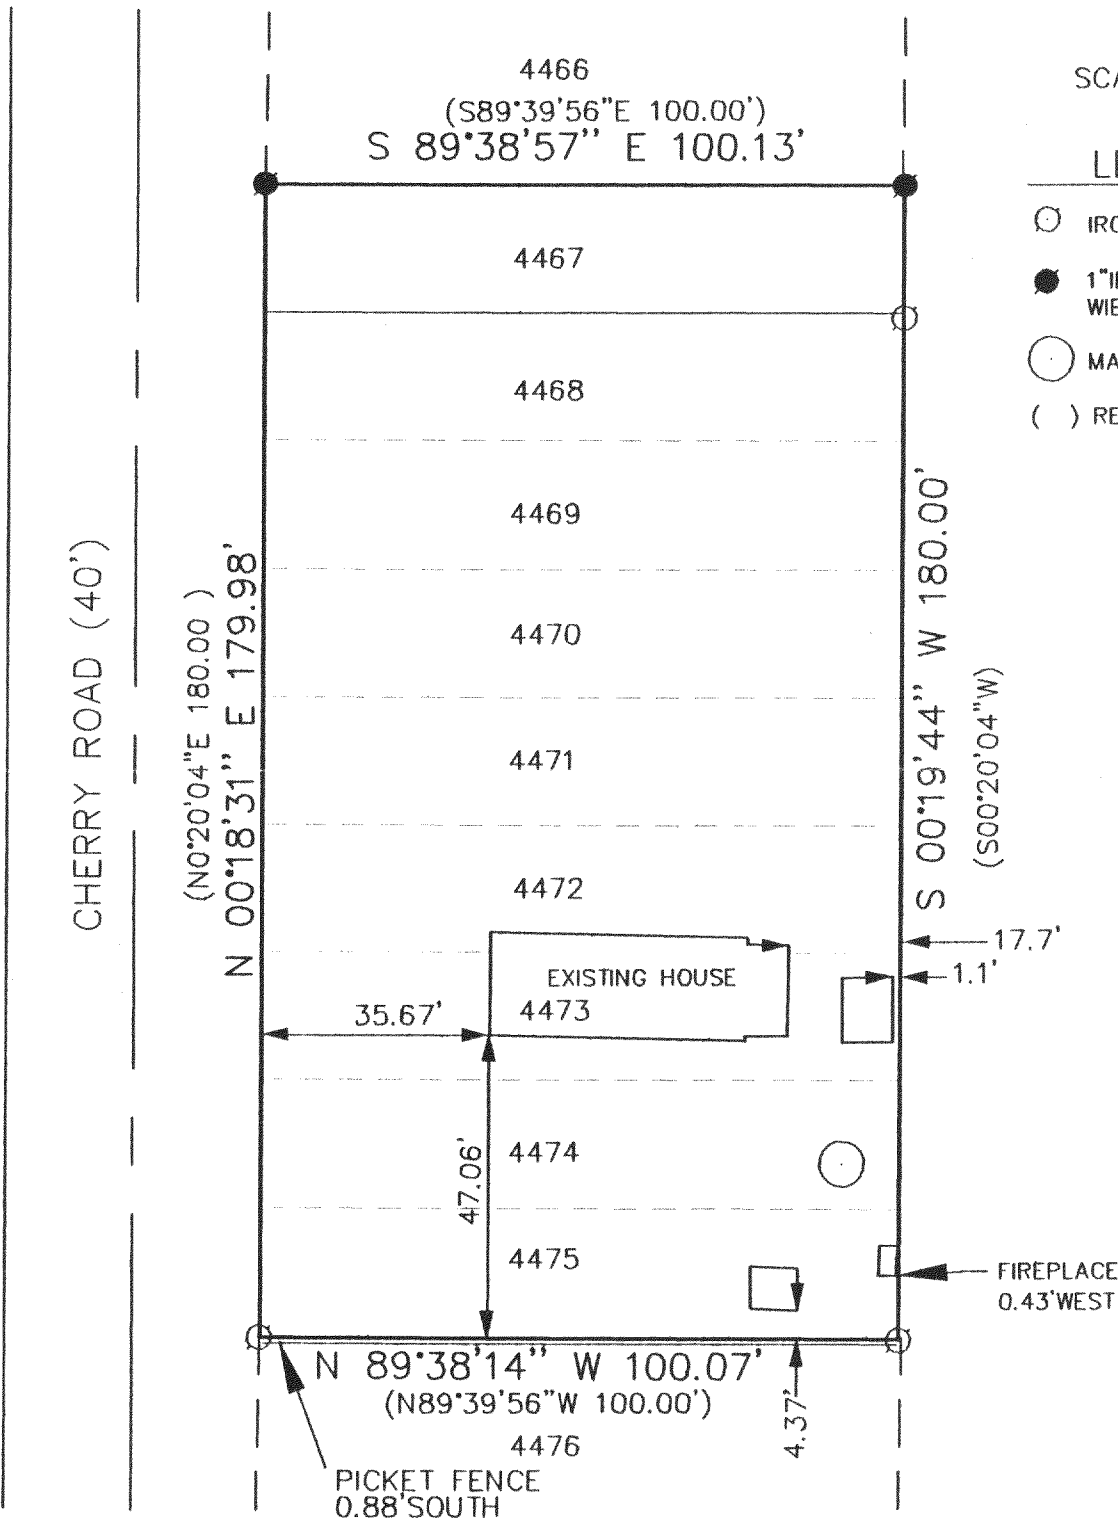

THE ABOVE MAP IS A TRUE REPRESENTATION THEREOF AND
SHOWS THE SIZE AND LOCATION OF ALL THE PROPERTY,
EXTERIOR BOUNDARIES, THE LOCATION OF ALL VISIBLE
BOUNDARY FENCES, APPARENT EASEMENTS, ROADWAYS
AND VISIBLE ENCROACHMENTS, IF ANY

THIS SURVEY IS MADE FOR THE USE OF THE PRESENT
OWNERS OF THE PROPERTY, AND ALSO THOSE WHO
PURCHASE, MORTGAGE OR GUARANTEE TITLE THERETO
WITHIN ONE (1) YEAR FROM DATE HERETO.

JOHN P. KROTT, R.L.S. 2258

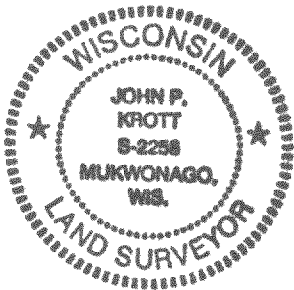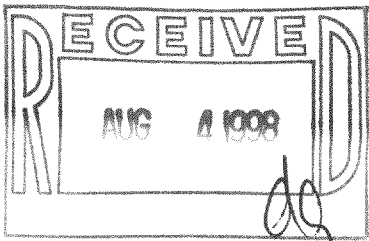

NOTE: THIS IS NOT A CERTIFIED COPY
UNLESS SEAL IS IN RED.
JOB NUMBER 98096

JCB-880
217-1651