


48-47

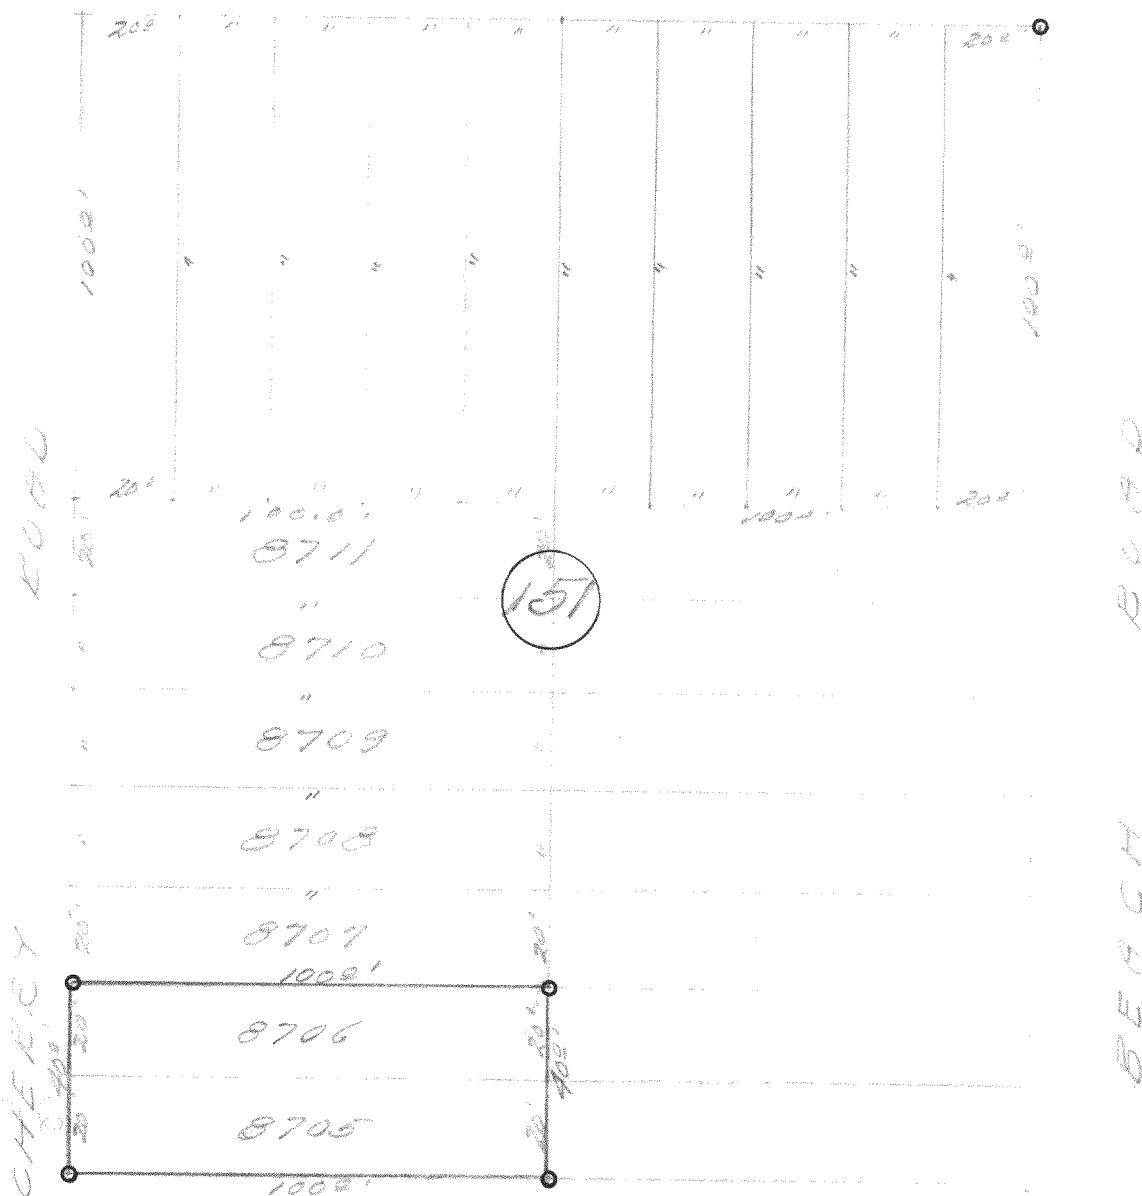

DESCRIPTION: Lots 8795 and 8796, of the Fourth Map of Lake Como Beach Subdivision of a portion of Section 21, Town 2 north, Range 17 east of the 4th Principal Meridian.

CERTIFICATE: I, hereby certify that I, have on this the 17th day of July 1948, surveyed the above described property according to the official records on file in the office of the Recorder of Deeds in and for Walworth County, Wisconsin, and find that the measurements and bearings of the boundary lines of said property as taken at the site on this day substantially agree with those in the above description and that no encroachments exist.

SIGNED AND SEALED ON THIS THE 19TH DAY OF JULY 1948

Joseph M. Biagi, Professional Engineer
Ekhorn, Wisconsin.

2D - 166B

JLCB-1864