


Wisconsin Registered Land Surveyor S-1594

Rt. 3, Box 273
Elkhorn, Wisconsin 53121
Phone: (414) 723-4260 (office)
(414) 723-7209 (FAX)


PLAT OF SURVEY

LOTS 6462 - 6465 OF BLOCK 111 OF LAKE COMO BEACH
SUBDIVISION, LOCATED IN SECTION 28, TOWN 2 NORTH,
RANGE 17 EAST, WALWORTH COUNTY, WISCONSIN.

OWNER: LOUISE PEITRAROSSO, TRUSTEE
78 WEST NORTH AVE.
NORTHLAKE, IL. 60164

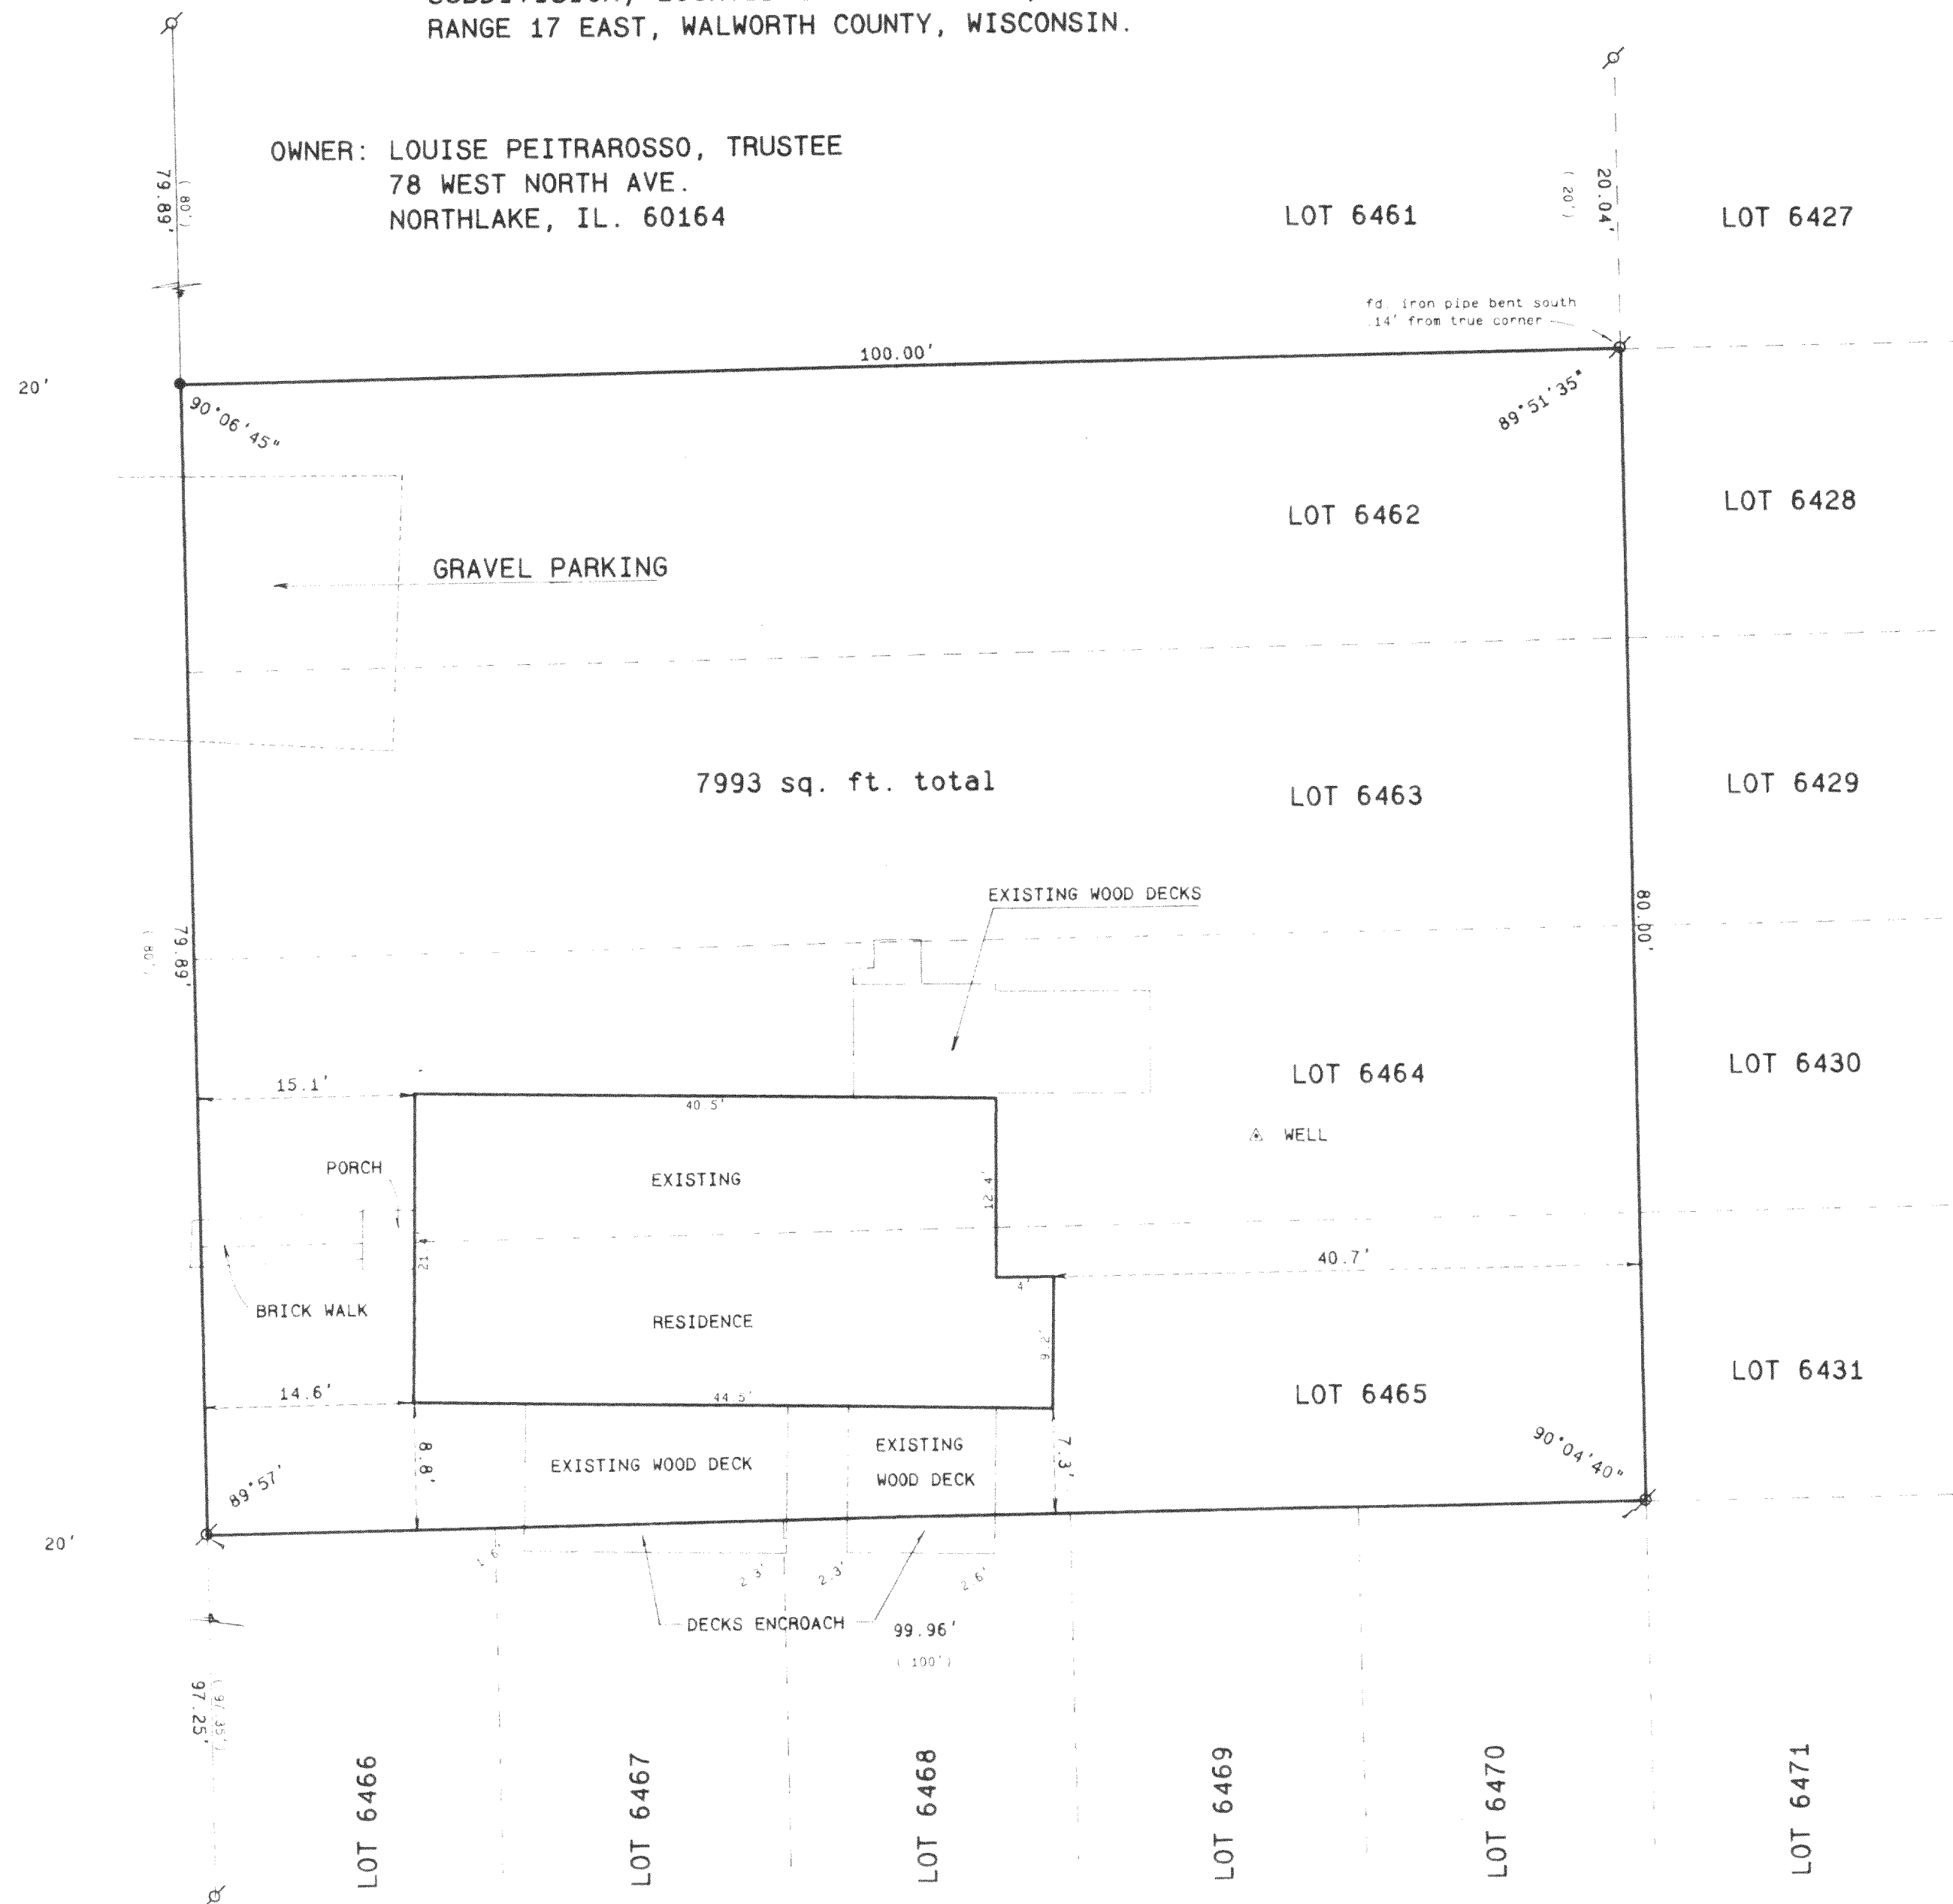


SCALE 1" = 10 FEET

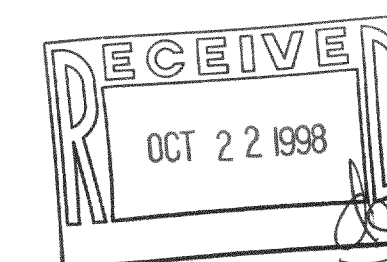

Legend

- 17 FOUND IRON PIPE
 20 FOUND IRON ROD
 FOUND BRASS CAPPED MONUMENT
 X FOUND CONCRETE MONUMENT
 + CHISEL CUT IN CONCRETE
 20 SET IRON ROD, 24 LONG, WEIGHING
 15 LBS. LINEAL FT., 3 3/4 DIA.
 20 SET IRON ROD, 30" LONG, WEIGHING
 45 LBS. LINEAL FT., 1 11/16" DIA.
 (xx) RECORDED AS DIMENSION
 EXISTING FENCE

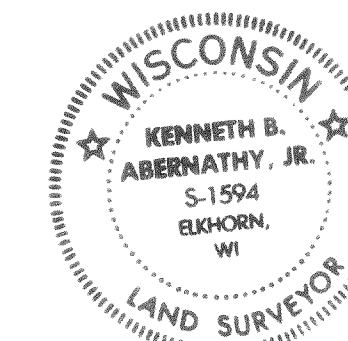

SCALE: 1" = 10 FEET

That the above described property has been surveyed by me as shown under my direction and that the above map is a true representation thereof, shows the size and location of the property, its boundaries, the location of all visible structures and dimensions of all principal buildings thereon, boundary fences, apparent easements, roadways and visible encroachments, if any.

one year from date hereof

Kenneth B. Wilf.

KENNETH B. ABERNATHY, JR.
WISCONSIN REGISTERED LAND SURVEYOR,

Date: SEPT 4, 1998 Job No. 98 902

217-11680
JLCB-1342