

PLAT OF SURVEY

PATHFINDER SURVEYING
FORMERLY KOLB LAND CONSULTING
929 WILLIAMS STREET LAKE GENEVA, WI. 53147
(414) 248-3697

ORDERED BY:
MILTON STOLTZ
N 3227 CHERRY ROAD
LAKE GENEVA, WI.
53147


DATE: 10 / 23 / 1998

NOTE: THIS IS A PARCEL SPLIT

DESCRIPTION: LOTS 5220 THRU 5222, LOTS 5223 THRU 5230 AND LOTS 5240 THRU 5245 ALL INCLUSIVE, BLOCK 93 LAKE COMO BEACH SUBDIVISION A SUBDIVISION LOCATED TOWN 2 NORTH, RANGE 17 EAST, WALWORTH COUNTY WISCONSIN.


NOTE: LOTS 5223 AND 5224 ARE TO BE TAKEN FROM TAX KEY # JLCB-1053 AND ADDED TO TAX KEY # JLCB 1052

AREA OF LANDS TO REMAIN IN TAX KEY # JLCB-1053 = 24086 SQUARE FEET MORE OR LESS
AREA OF TAX KEY # JLCB1052 AFTER ADDING LOTS 5223 AND 5224 = 10027 SQUARE FEET MORE OR LESS

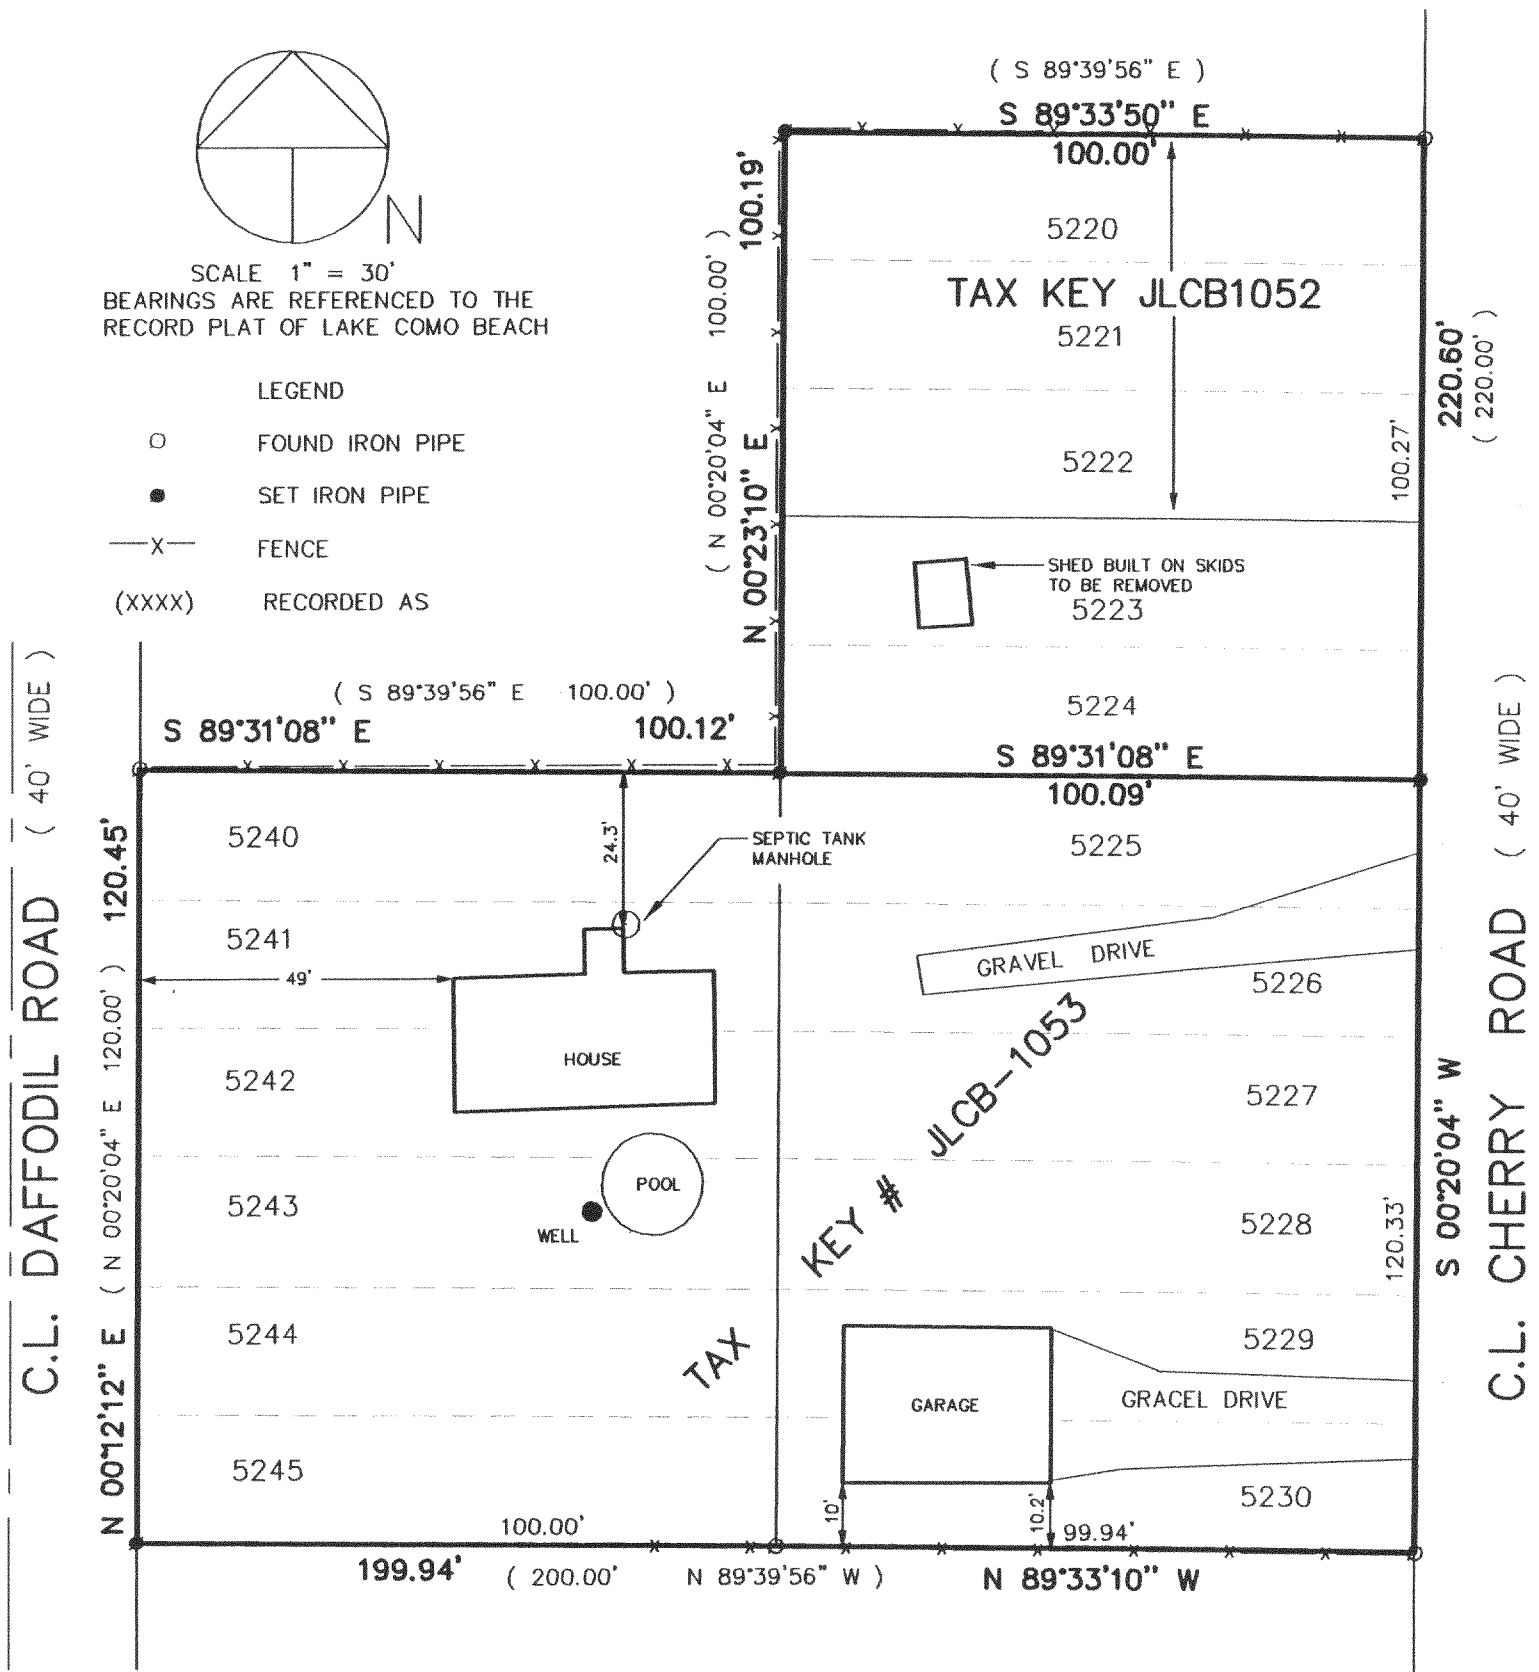

THE ABOVE MAP IS A TRUE REPRESENTATION THEREOF AND SHOWS THE SIZE AND LOCATION OF ALL THE PROPERTY, EXTERIOR BOUNDARIES, THE LOCATION OF ALL VISIBLE BOUNDARY FENCES, APPARENT EASEMENTS, ROADWAYS AND VISIBLE ENCROACHMENTS, IF ANY

THIS SURVEY IS MADE FOR THE USE OF THE PRESENT OWNERS OF THE PROPERTY, AND ALSO THOSE WHO PURCHASE, MORTGAGE OR GUARANTEE TITLE THERETO WITHIN ONE (1) YEAR FROM DATE HERETO.

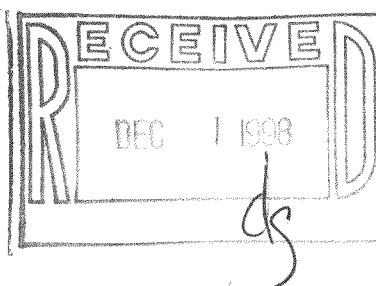

John P. Krott
JOHN P. KROTT, R.L.S. 2258

NOTE: THIS IS NOT A CERTIFIED COPY UNLESS SEAL IS IN RED.

JOB NUMBER: 2-17-JLCB-1052&1053

JLCB-1052
JLCB-1053 217-1687