


ABELL
SURVEYING & MAPPING
DELAVER, WISCONSIN 53115
414-728-6737

ROAD

OPAL

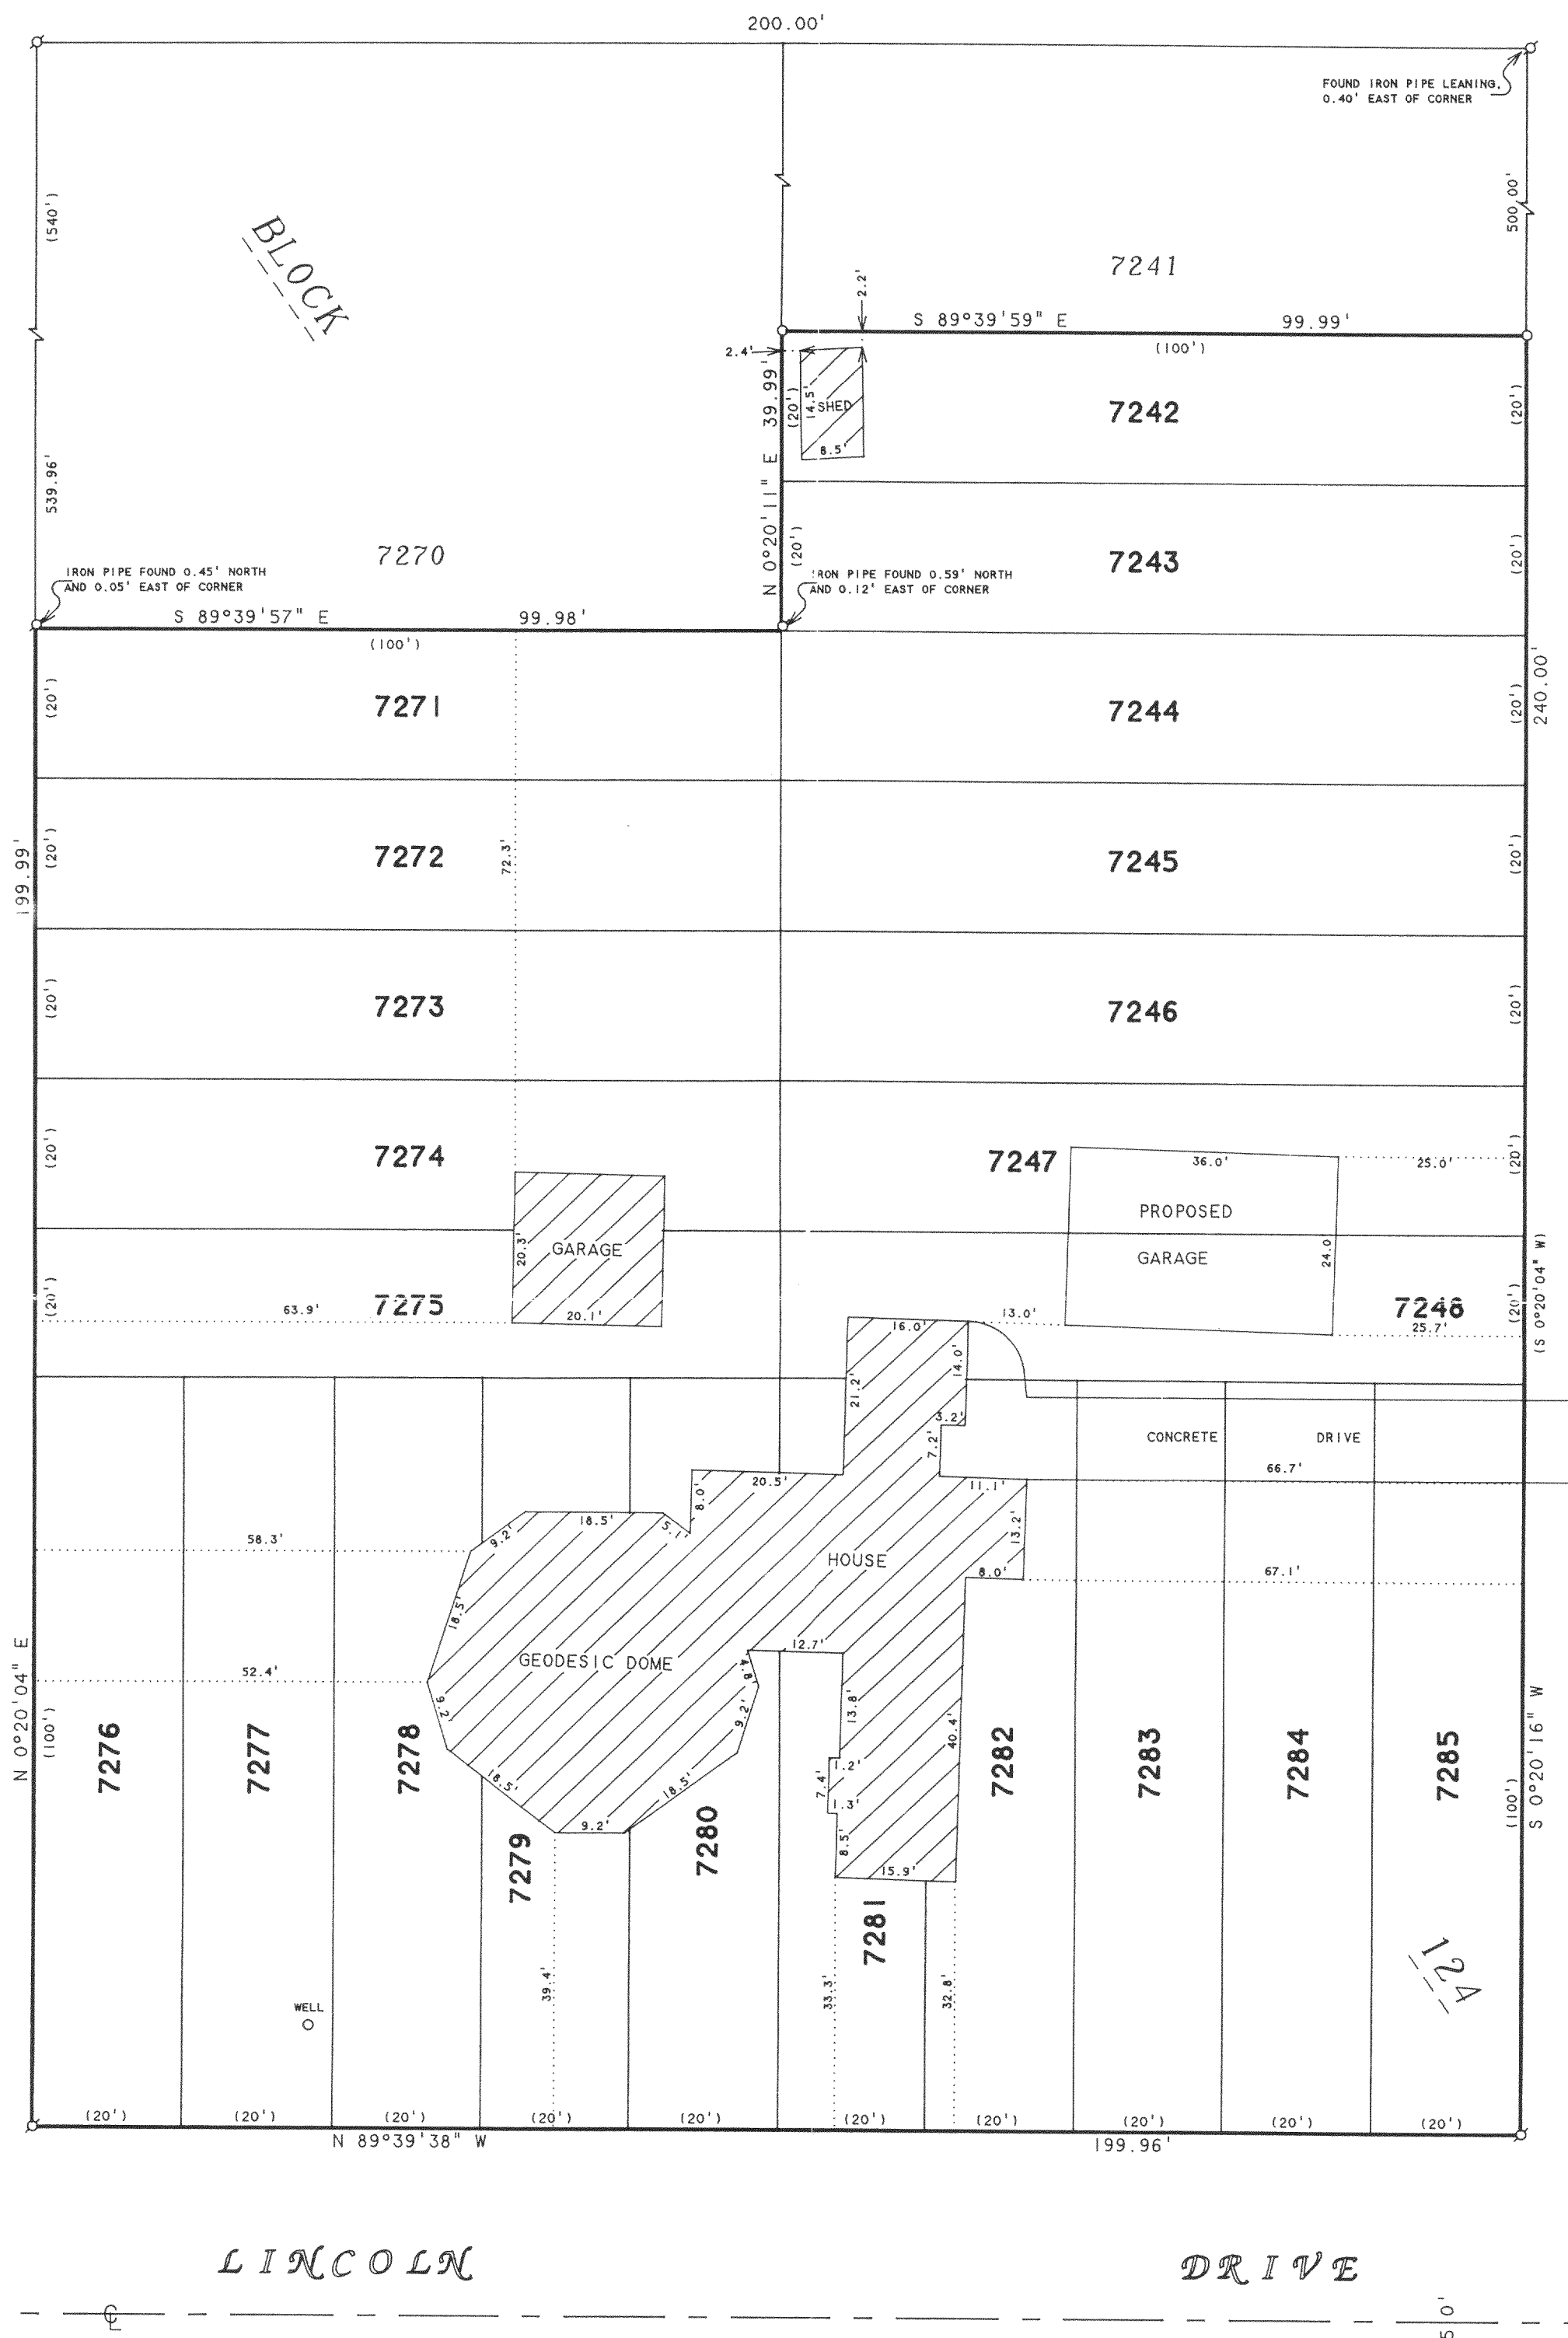

ROAD

NYPH

LINCOLN

DRIVE

50'

NOTE: BEARINGS ARE REFERENCED TO THE
RECORDED SUBDIVISION PLAT.

ORDERED BY: STEVE PROKOP
N3211 NYMPH ROAD
LAKE GENEVA, WI 53147

N




SCALE 1"=20'

LEGEND

- - IRON PIPE FOUND
- - IRON ROD FOUND
- - IRON PIPE SET
- () - RECORDED AS

PLAT OF SURVEY OF

LOTS 7242-7248 AND 7271-7285, BLOCK 124, LAKE COMO
BEACH SUBDIVISION, LOCATED IN T2N, R17E, WALWORTH
COUNTY, WISCONSIN.

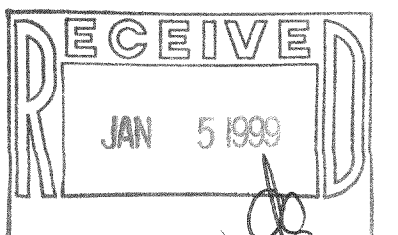

I, DAVID F. ABELL, DO HEREBY CERTIFY THAT I HAVE SURVEYED THE PROPERTY HEREON
DESCRIBED ACCORDING TO THE OFFICIAL RECORDS AND THAT THE PLAT HEREON IS A
CORRECT REPRESENTATION OF THE PROPERTY LINES TO THE BEST OF MY KNOWLEDGE AND
BELIEF.

David F. Abell

DAVID F. ABELL
WISCONSIN REGISTERED LAND SURVEYOR, S-1596

September 14, 1998

DATE: _____ JOB NUMBER: 98124
NOTE: THIS IS NOT A CERTIFIED COPY UNLESS SEALED.

JLCB-1542

217-11689