


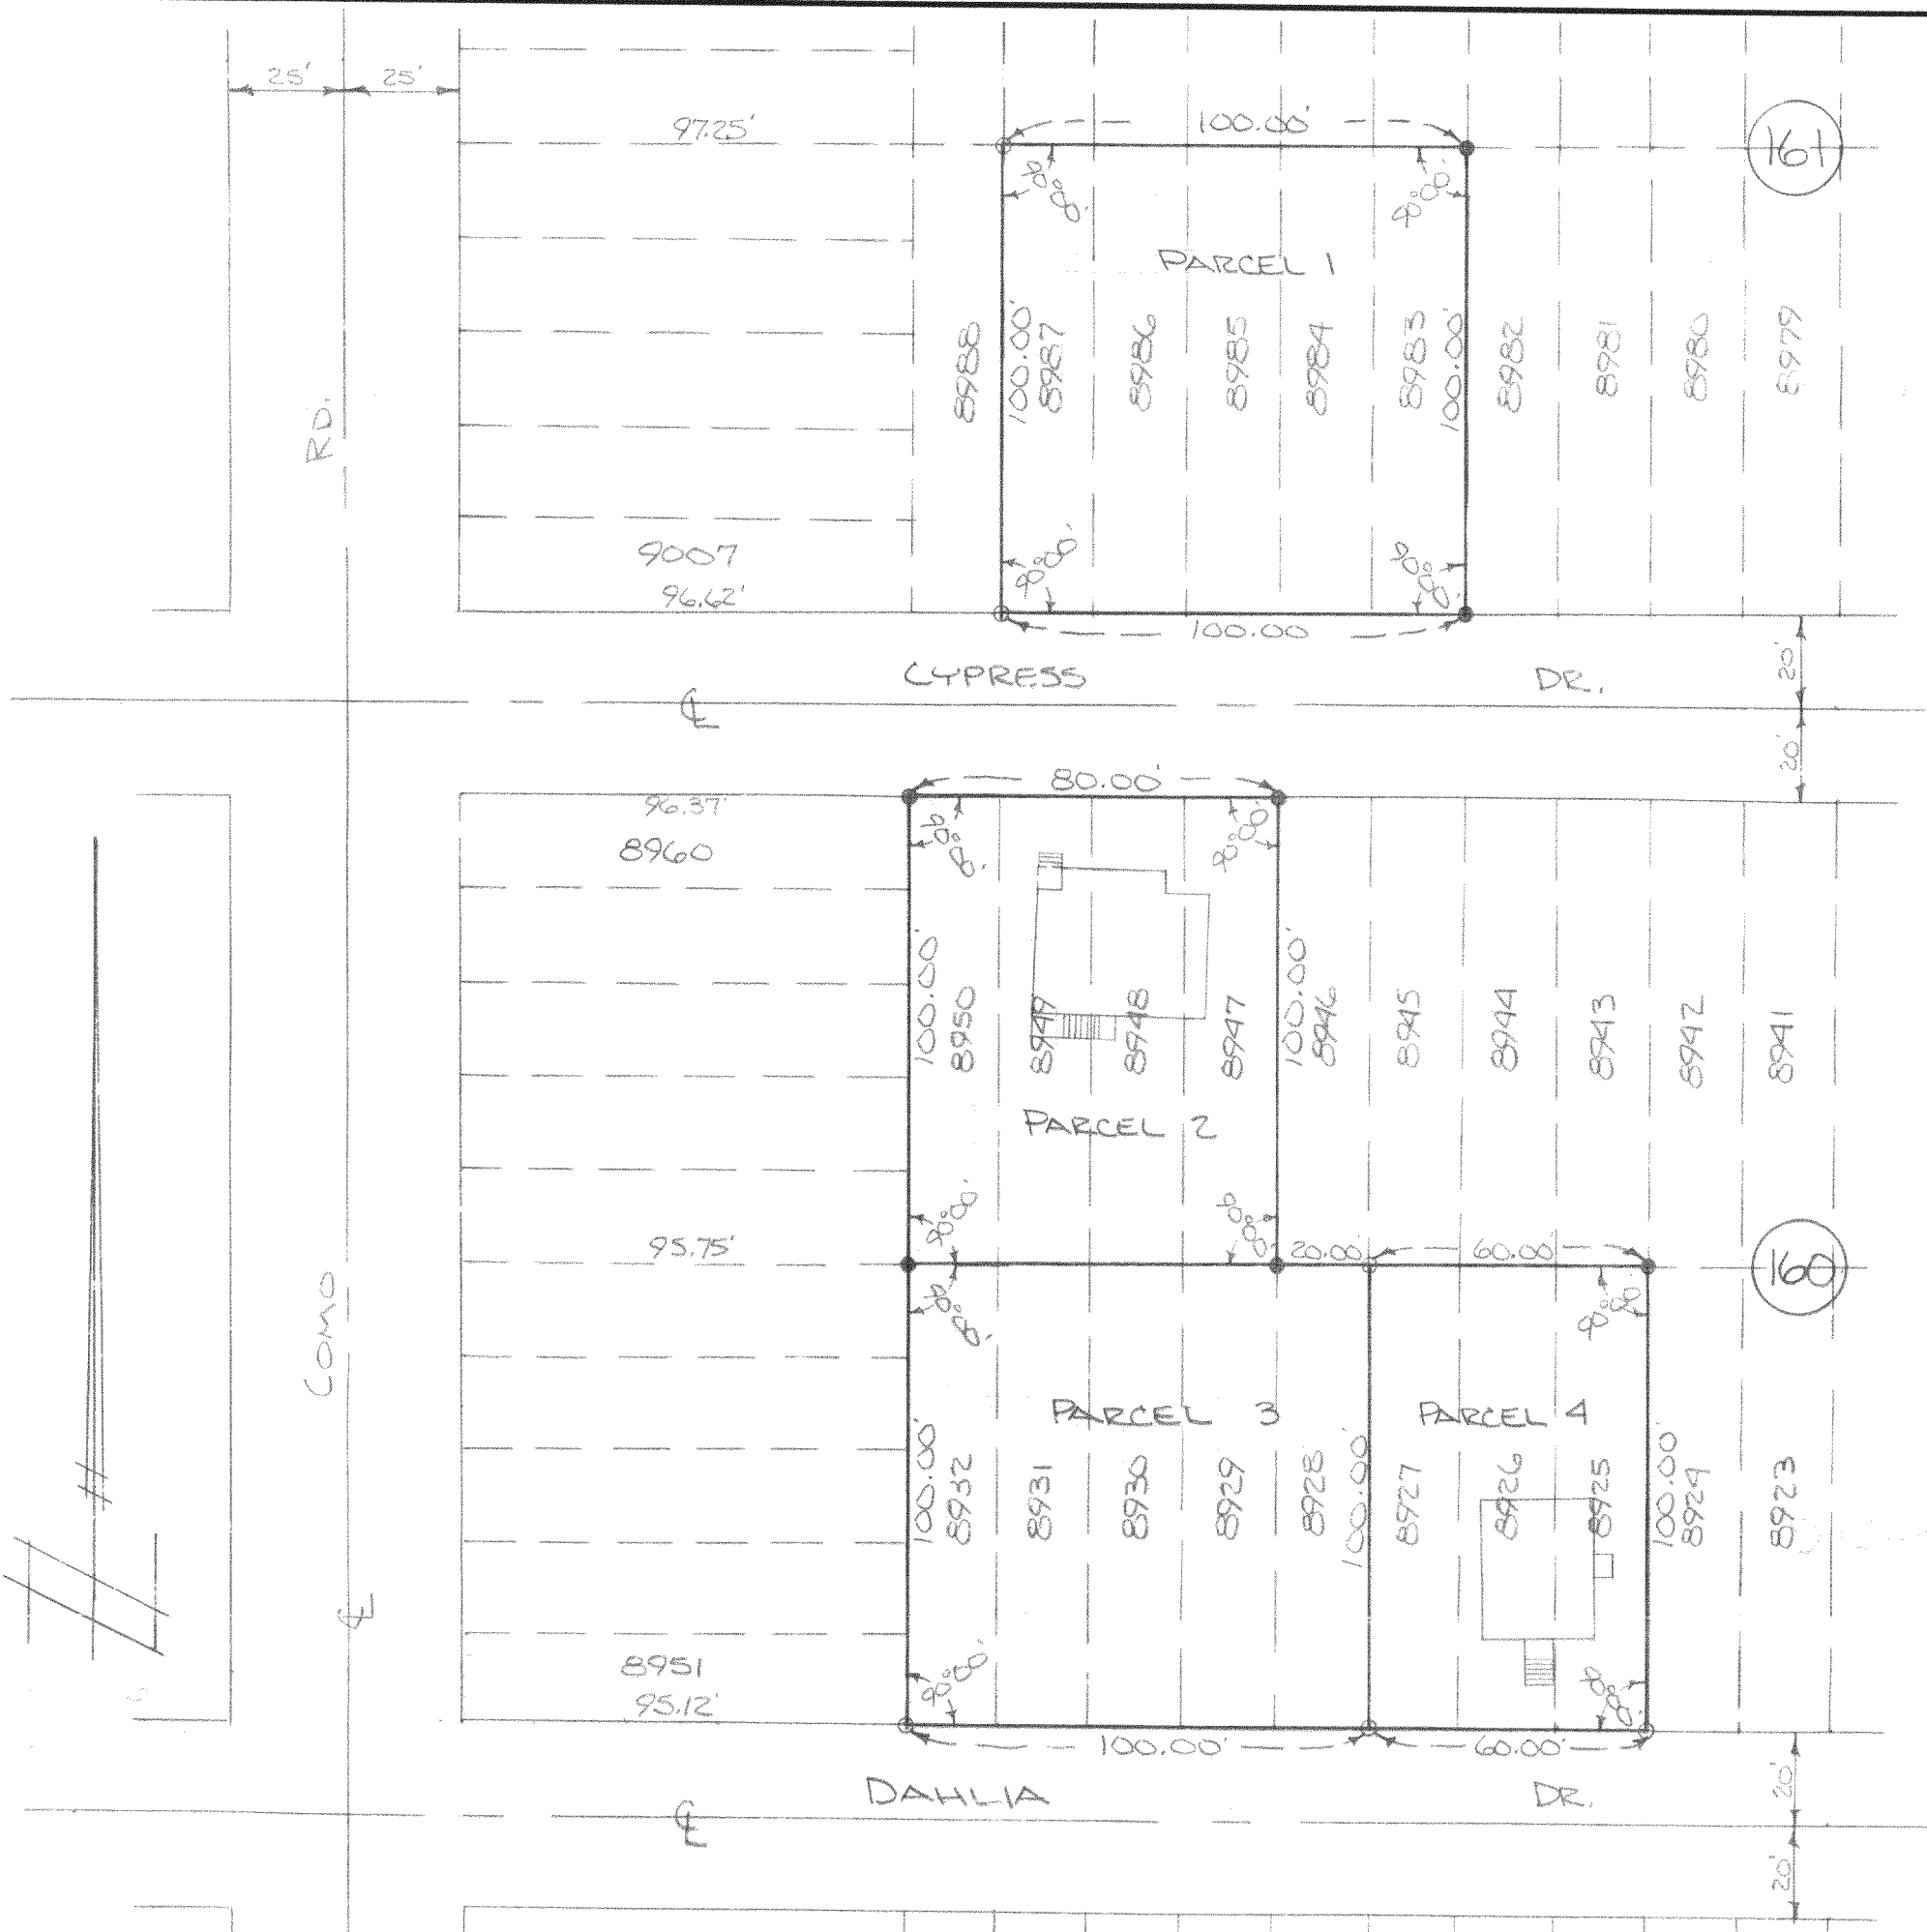

LEGEND:

- - INDICATES IRON PIPE FOUND
- - INDICATES IRON PIPE SET

NOTE:

ALL LOTS NOT FRONTING ON COMO RD. ARE 20.00' X 100.00'

DESCRIPTIONS:

PARCEL 1;

Lots 8983, 8984, 8985, 8986, & 8987 all in Block 161 of the 4th Map of Lake Como Beach Plats

PARCEL 2;

Lots 8947, 8948, 8949, & 8950 all in Block 160 of the 4th Map of Lake Como Beach Plats

PARCEL 3;

Lots 8932, 8931, 8930, 8929, & 8928 all in Block 160 of the 4th Map of Lake Como Beach Plats

PARCEL 4;

Lots 8927, 8926, & 8925 all in Block 160 of the 4th Map of Lake Beach Plats

The aforementioned Lake Como Beach Plats being a subdivision located in Sections 21 & 22, T2N, R17E, Walworth County, Wisconsin.

CERTIFICATE:

I, Joseph M. Biagi, surveyor, do hereby certify that I have surveyed the lands hereon described

DATE:

August 3, 1973

Joseph M. Biagi
Elkhorn, Wisconsin

RLS #12

JLCB-1929, 1932, 197A, 197

PLAT OF SURVEY FOR MR. STEVE SLOBODIAN		
PART OF BLKS 160 & 161 OF LAKE COMO BEACH PLATS	SCALE 1"=40'-0"	DRAWN BY GPW
	REVISED	
DATE	APPROVED BY	DRAWING NUMBER