



ABERNATHY and ASSOCIATES

Kenneth B. Abernathy Jr.

Wisconsin Registered Land Surveyor S-1594

W4056 Bray Road
Elkhorn, Wisconsin 53121
Phone: (414) 723-4260 (office)
(414) 723-7209 (fax)

PLAT OF SURVEY

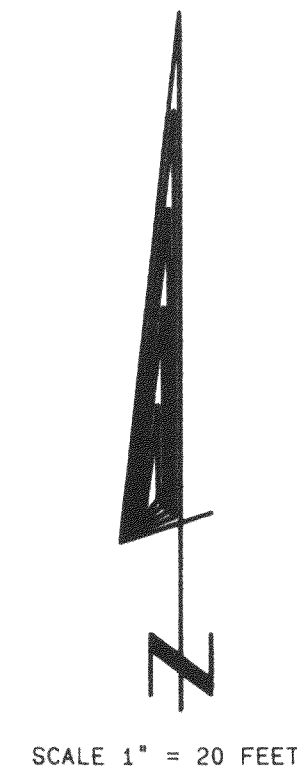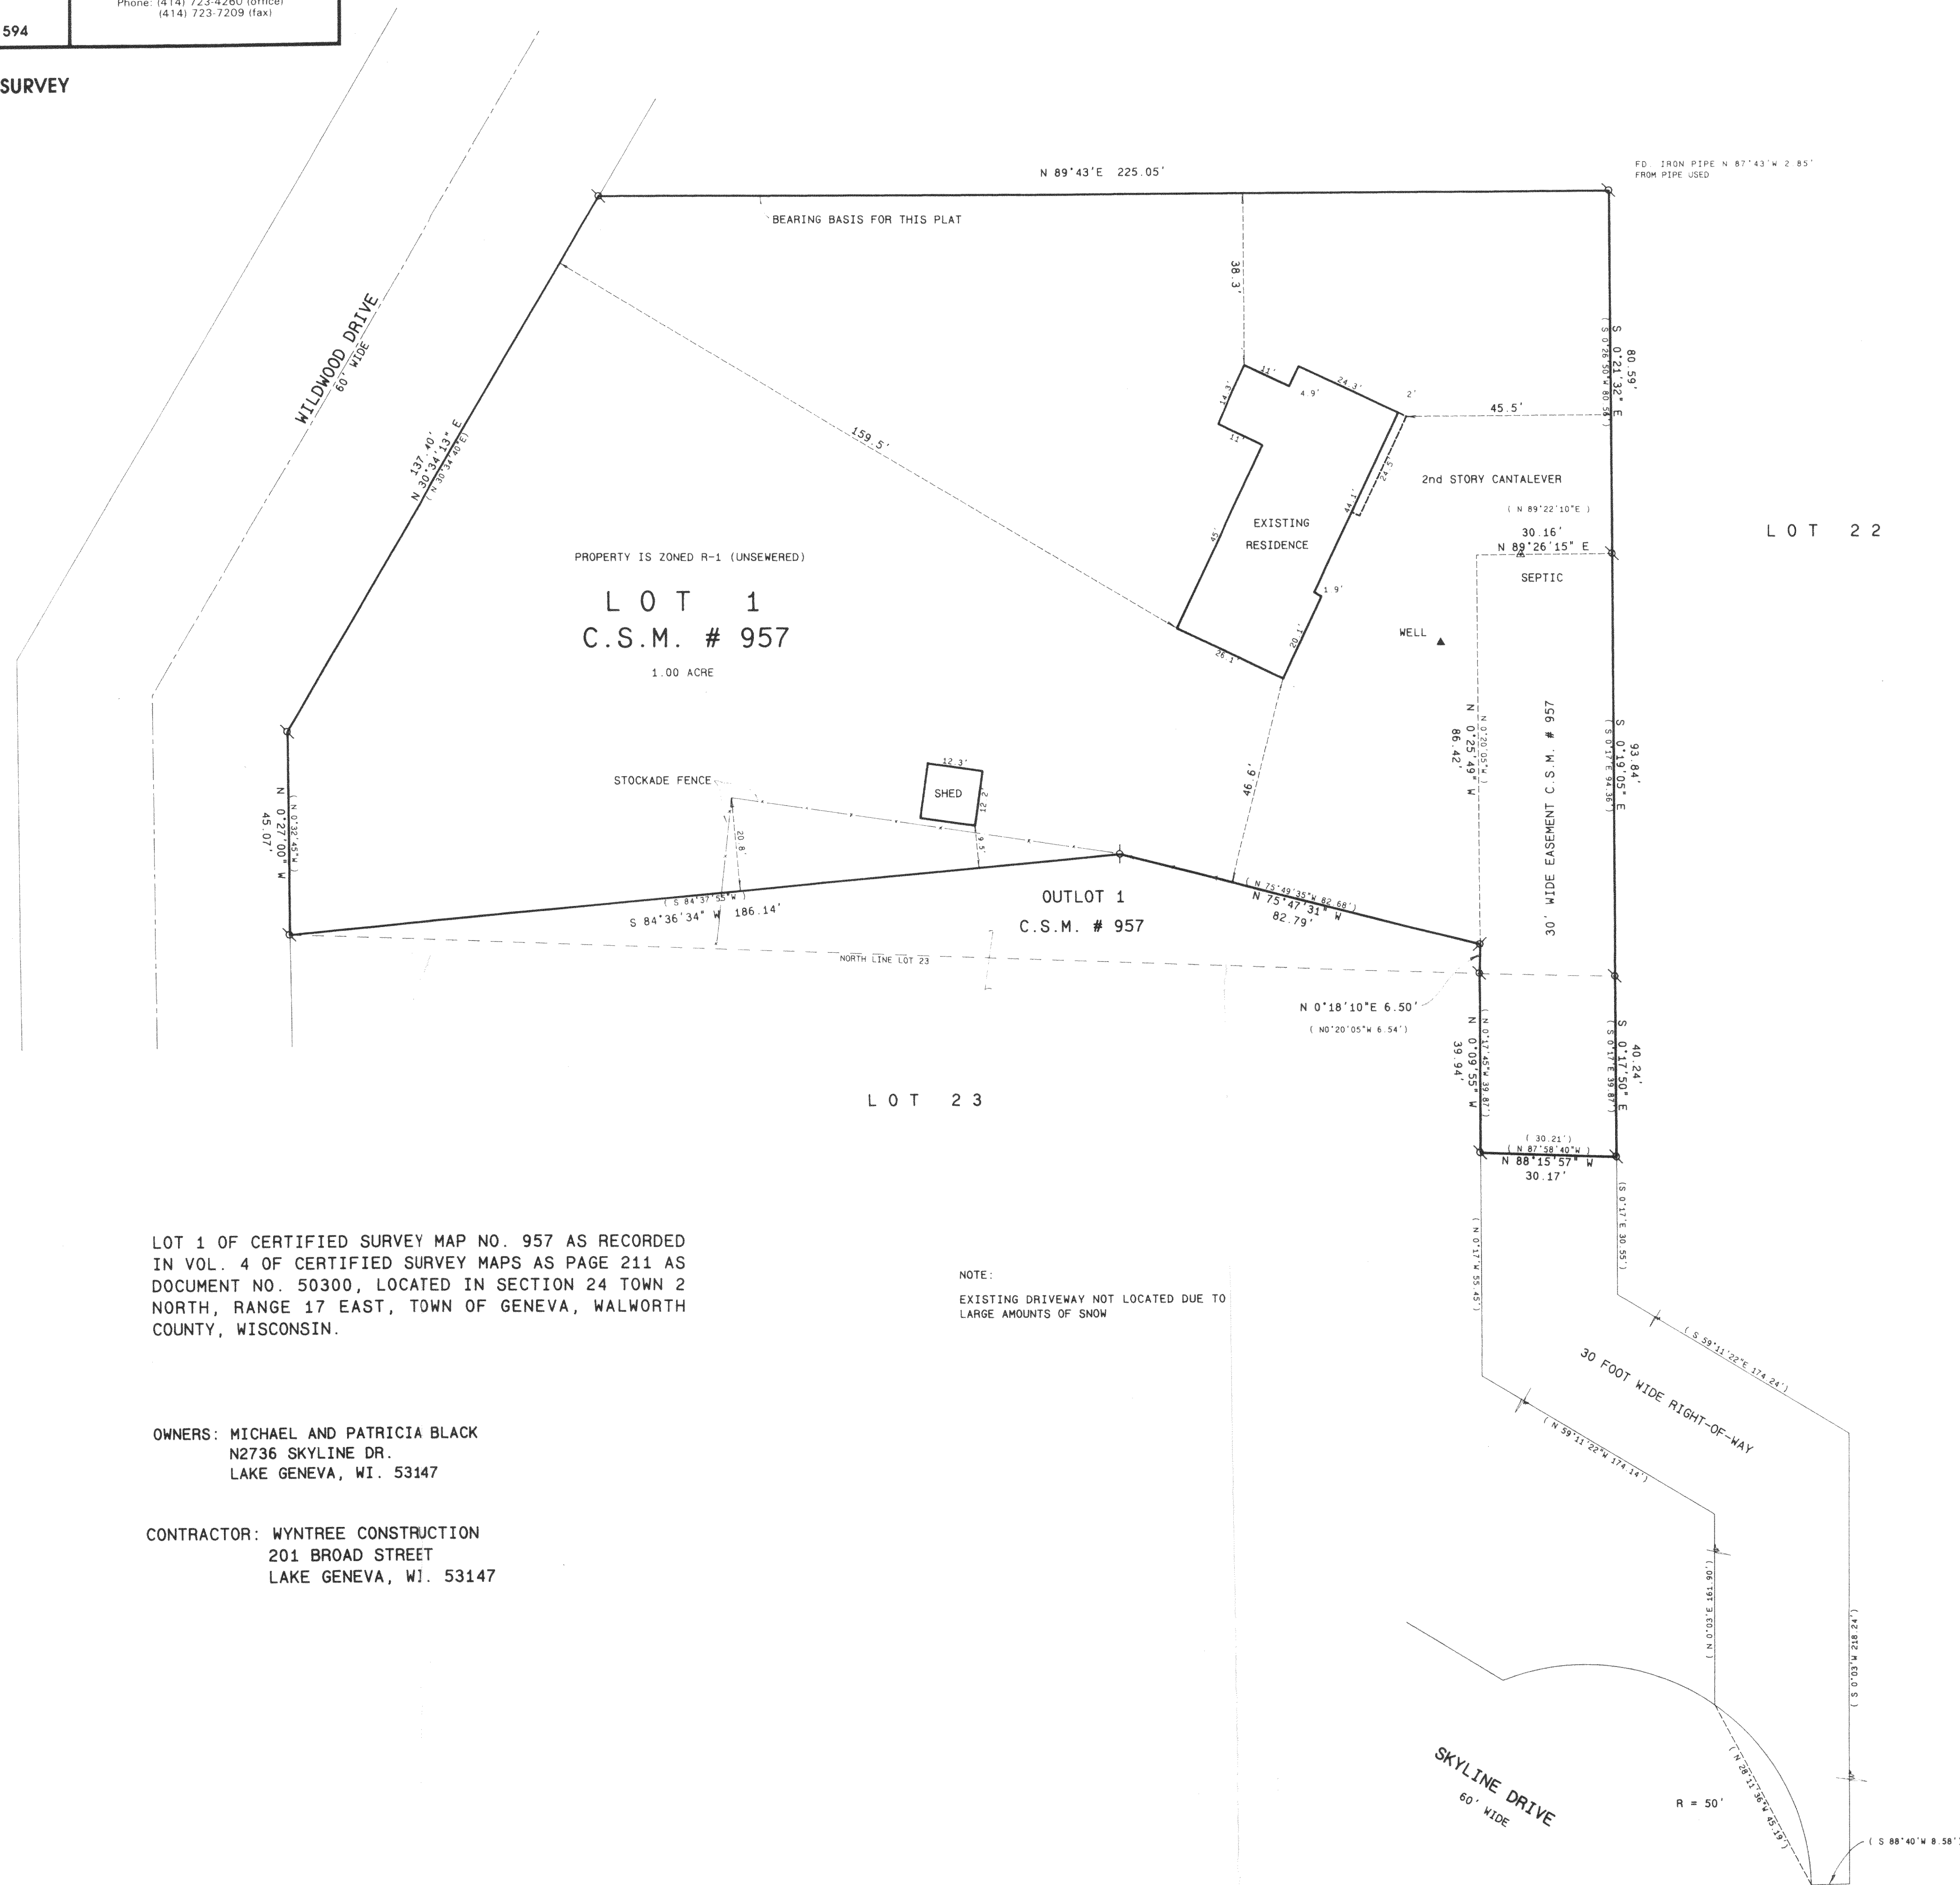

THE NORTH LINE OF
CERTIFIED SURVEY MAP NO.
957 WAS ASSUMED TO BEAR
N 89°43'E AS PLATTED.

LOT 1 OF CERTIFIED SURVEY MAP NO. 957 AS RECORDED
IN VOL. 4 OF CERTIFIED SURVEY MAPS AS PAGE 211 AS
DOCUMENT NO. 50300, LOCATED IN SECTION 24 TOWN 2
NORTH, RANGE 17 EAST, TOWN OF GENEVA, WALWORTH
COUNTY, WISCONSIN.

OWNERS: MICHAEL AND PATRICIA BLACK
N2736 SKYLINE DR.
LAKE GENEVA, WI. 53147

CONTRACTOR: WYNTREE CONSTRUCTION
201 BROAD STREET
LAKE GENEVA, WI. 53147


NOTE:

EXISTING DRIVEWAY NOT LOCATED DUE TO
LARGE AMOUNTS OF SNOW

Legend

- FOUND IRON PIPE
- FOUND IRON ROD
- FOUND BRASS CAPPED MONUMENT
- FOUND CONCRETE MONUMENT
- CHISEL CUT IN CONCRETE
- SET IRON ROD, 24" LONG, WEIGHING
1.5 LBS./LINEAL FT., 3/4" DIA.
- SET IRON ROD, 30" LONG, WEIGHING
4.5 LBS./LINEAL FT., 1-1/16" DIA.
- RECORDED AS DIMENSION
- EXISTING FENCE

SCALE: 1"= 20 FEET

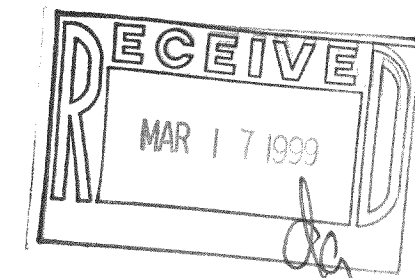

I hereby certify that the above described property has been surveyed
by me or under my direction and that the above map is a true
representation thereof and shows the size and location of the property,
its exterior boundaries, the location of all visible structures and
dimensions of all principal buildings thereon, boundary fences, apparent
easements, roadways and visible encroachments, if any.
This survey is made for the use of the present owners of the property,
and also those who purchase, mortgage, or guarantee the title thereto
within one year from date hereof.

Kenneth B. Abernathy, Jr.

KENNETH B. ABERNATHY, JR.
WISCONSIN REGISTERED LAND SURVEYOR,
S-1594

Date: Jan 19, 1999 Job No. 99.105

JA-957-1 217-1724