


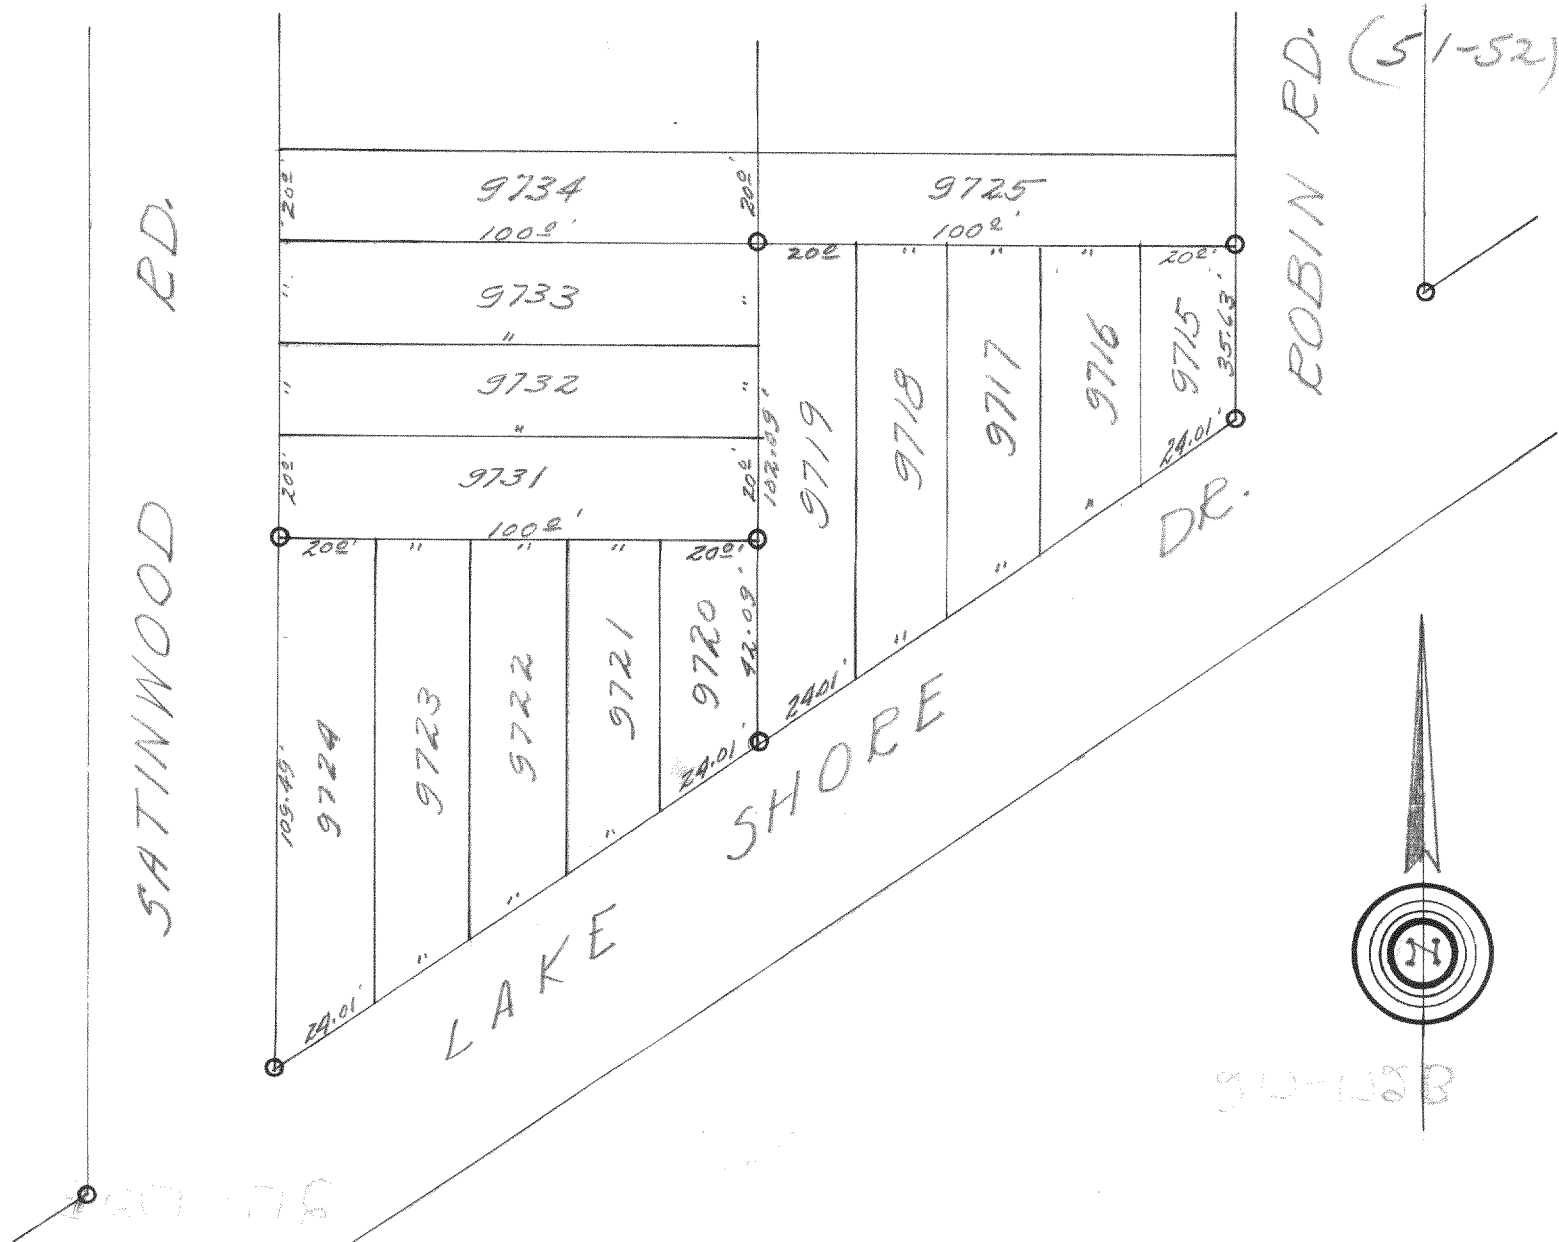

DESCRIPTION:

Lots 9715 to 9724 inclusive 5th Map of Lake Como Beach Subdivision of a portion of Sections 28 and 29, Town 2 north, Range 17 east of the 4th Principal Meridian.

CERTIFICATE:

I, hereby certify that I have on this the 9th day of June 1951, surveyed the above described property according to the official record on file in the office of the Recorder of Deeds in and for Walworth County, Wisconsin, and find that the measurements and bearings of the boundary lines of said property as taken at the site on this day substantially agree with those in said official record and that no encroachments exist.

SIGNED AND SEALED ON THIS THE 11TH DAY OF JUNE 1951.

Joseph M. Biagi
Joseph M. Biagi. Professional Engineer.
Elkhorn Wisconsin.

217-172B