
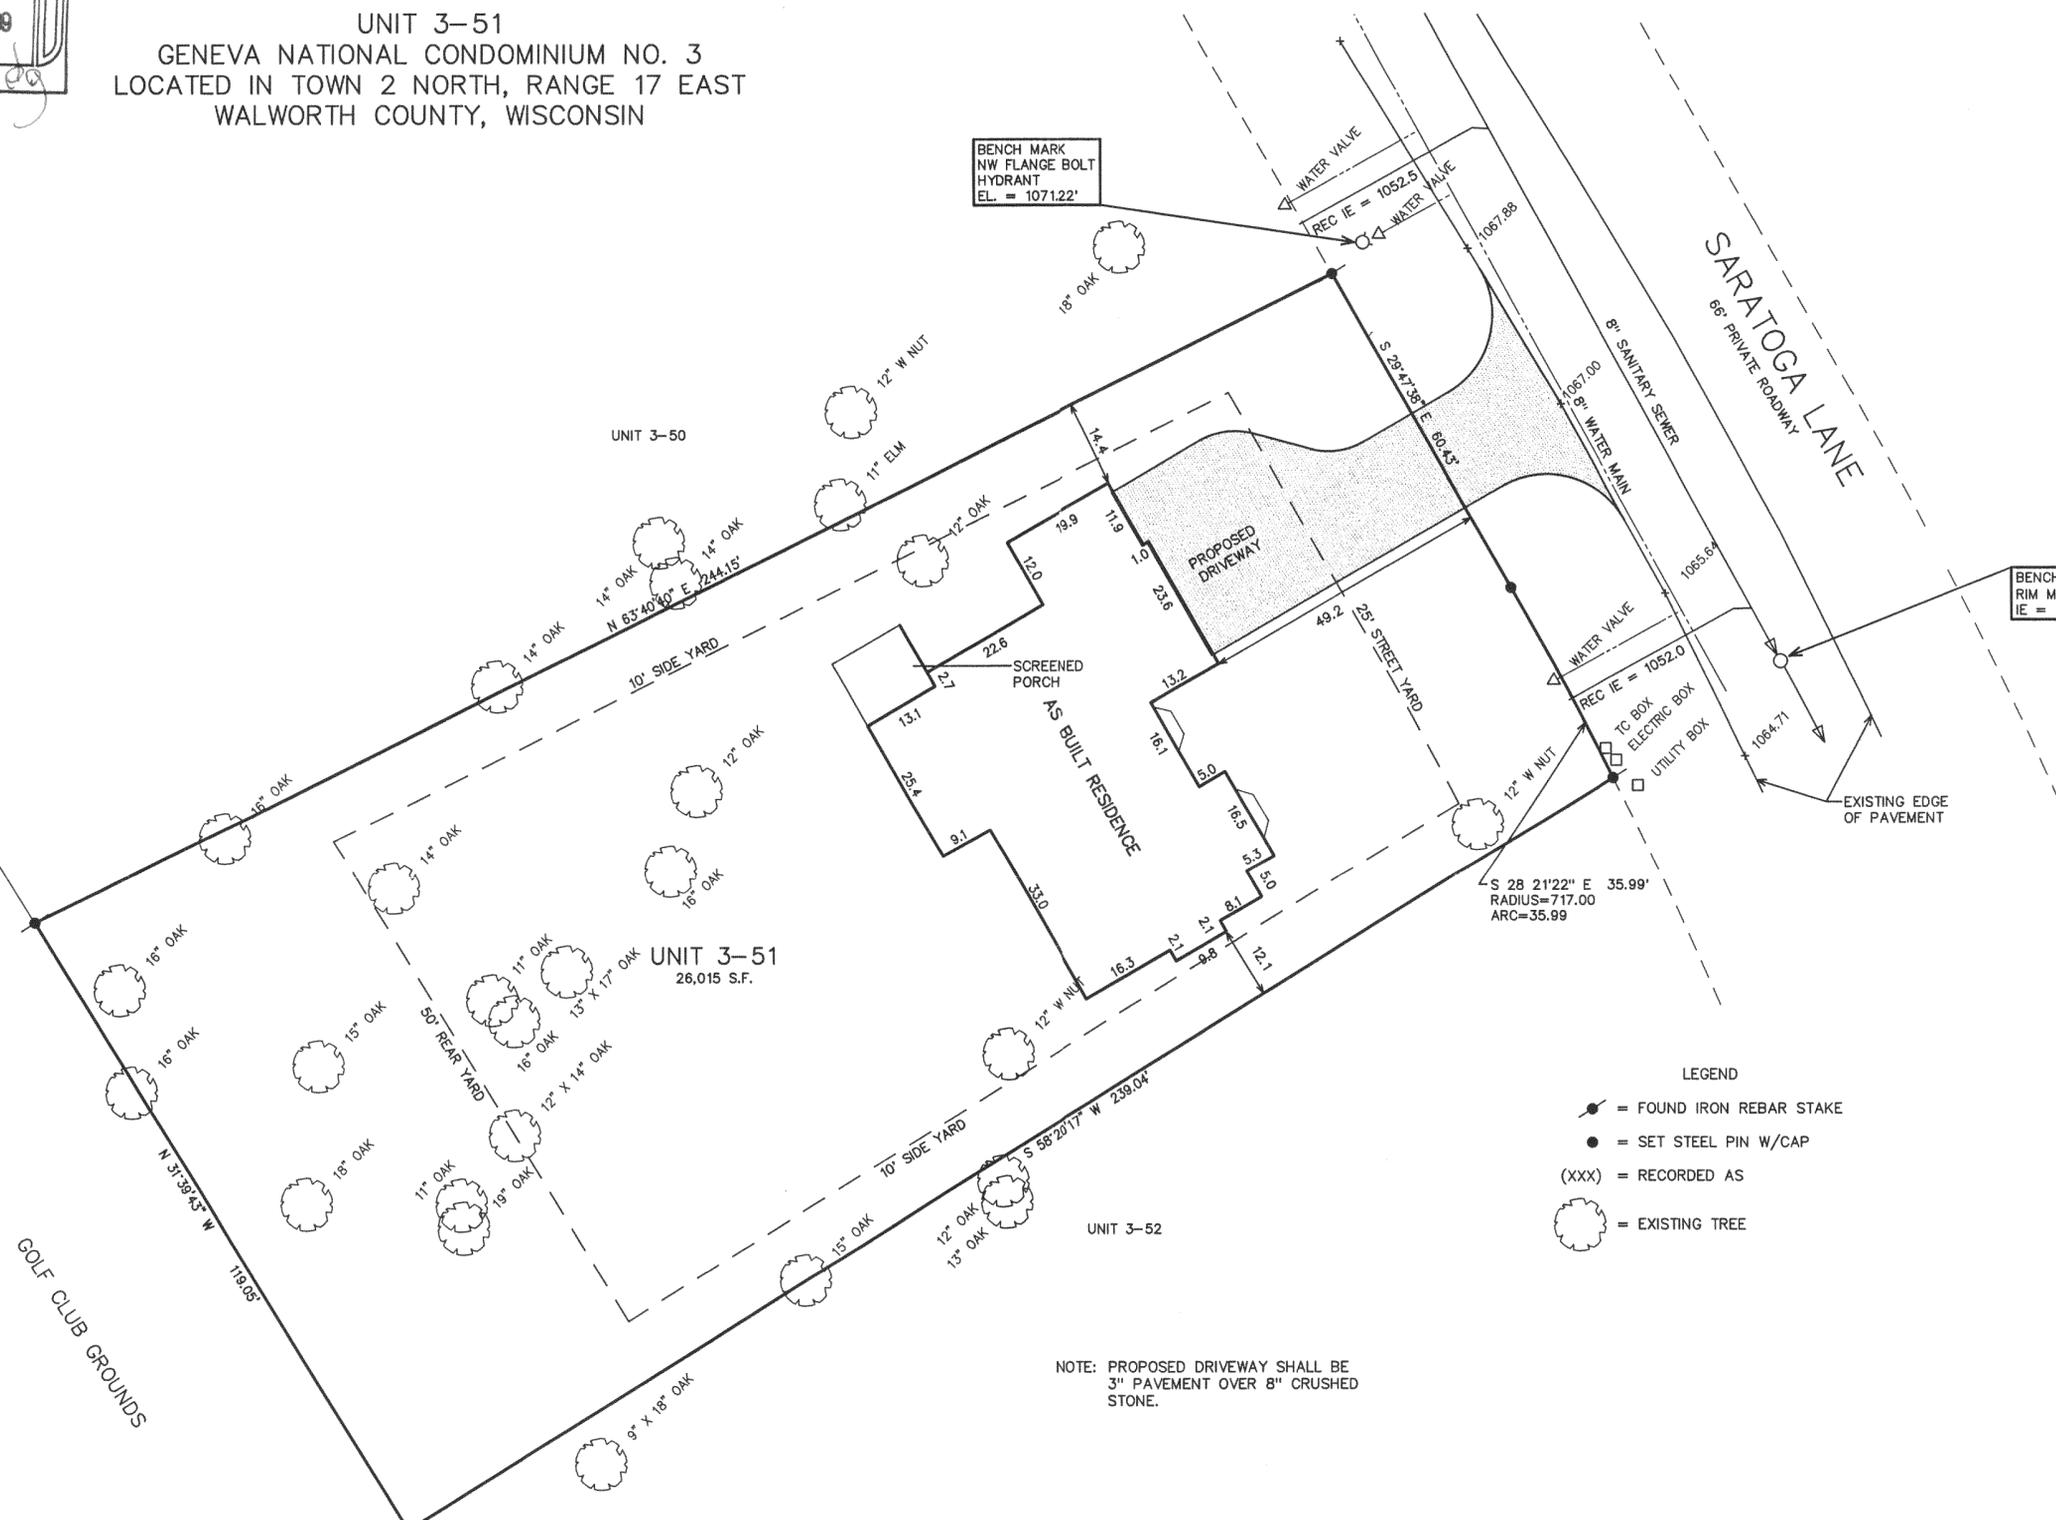


RECEIVED
JUL 26 1999

PLAT OF SURVEY

UNIT 3-51
GENEVA NATIONAL CONDOMINIUM NO. 3
LOCATED IN TOWN 2 NORTH, RANGE 17 EAST
WALWORTH COUNTY, WISCONSIN

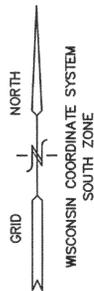

- LEGEND
- = FOUND IRON REBAR STAKE
 - = SET STEEL PIN W/CAP
 - (XXX) = RECORDED AS
 - = EXISTING TREE

NOTE: PROPOSED DRIVEWAY SHALL BE 3" PAVEMENT OVER 8" CRUSHED STONE.


NOTE: COPIES OF THIS MAP TO WHICH THE FOLLOWING CERTIFICATE WILL APPLY SHOW SURVEYOR'S ORIGINAL SEAL AND SIGNATURE IN RED INK. COPIES BY ANY OTHER MEANS MAY HAVE ALTERATIONS WHICH DO NOT REPRESENT THE SURVEYOR'S WORK PRODUCT.

I HEREBY CERTIFY THAT THE ABOVE DESCRIBED PROPERTY HAS BEEN SURVEYED UNDER MY DIRECTION AND THAT THE ABOVE MAP IS A TRUE REPRESENTATION THEREOF AND SHOWS THE SIZE AND LOCATION OF THE PROPERTY AND ITS EXTERIOR BOUNDARIES. THIS SURVEY IS MADE FOR THE USE OF THE PRESENT OWNERS OF THE PROPERTY, AND ALSO THOSE WHO PURCHASE, MORTGAGE, OR GUARANTEE THE TITLE THERETO WITHIN ONE YEAR FROM THE DATE HEREOF.



DATED: 08-28-99
PETER S. GORDON R.L.S. 2101

REVISED 06-16-99 TO SHOW SIZE & LOCATION OF RESIDENCE AS BUILT

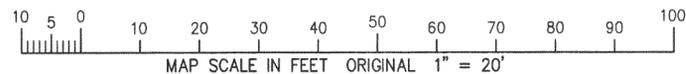

PLAT OF SURVEY
UNIT 3-51
GENEVA NATIONAL CONDOMINIUM NO. 3
WALWORTH COUNTY, WISCONSIN

KEARNS RESIDENCE

FARRIS, HANSEN & ASSOCIATES, INC.
Engineering, Architecture, Surveying
7 Ridgeway Court P.O. Box 437
ELKHORN, WISCONSIN 53121
Office: (414) 723-2098
Fax: (414) 723-5886

REVISIONS

PROJECT NO.
3269.3-51
DATE:
08/28/98
SHEET NO.
1 OF 1

JGN-3-51 217-1752

JUN 15 1999