

PLAT OF SURVEY


PATHFINDER SURVEYING
FORMERLY KOLB LAND CONSULTING
929 WILLIAMS STREET LAKE GENEVA, WI. 53147
(414) 248-3697

ORDERED BY: MARIE PITIRO
3742 N LOCKWOOD AVE
CHICAGO IL. 60641-3343

DATE: 3-4-1999



DESCRIPTION: PARCEL "A" LOTS 11493 THRU 11497 INCLUSIVE AND THE SOUTHERLY 10.05 FEET OF LOTS 11518
ALL LOCATED IN BLOCK 207 LAKE COMO BEACH SUBDIVISION AREA = 10000 SQUARE FT.

PARCEL "B" LOTS 11518 THRU 11524 ALL INCLUSIVE EXCEPTING THEREFROM THE SOUTHERLY 10.05
FEET OF LOT 11518 ALL LOCATED IN BLOCK 207 LAKE COMO BEACH SUBDIVISION AREA = 12975 SQUARE FT.

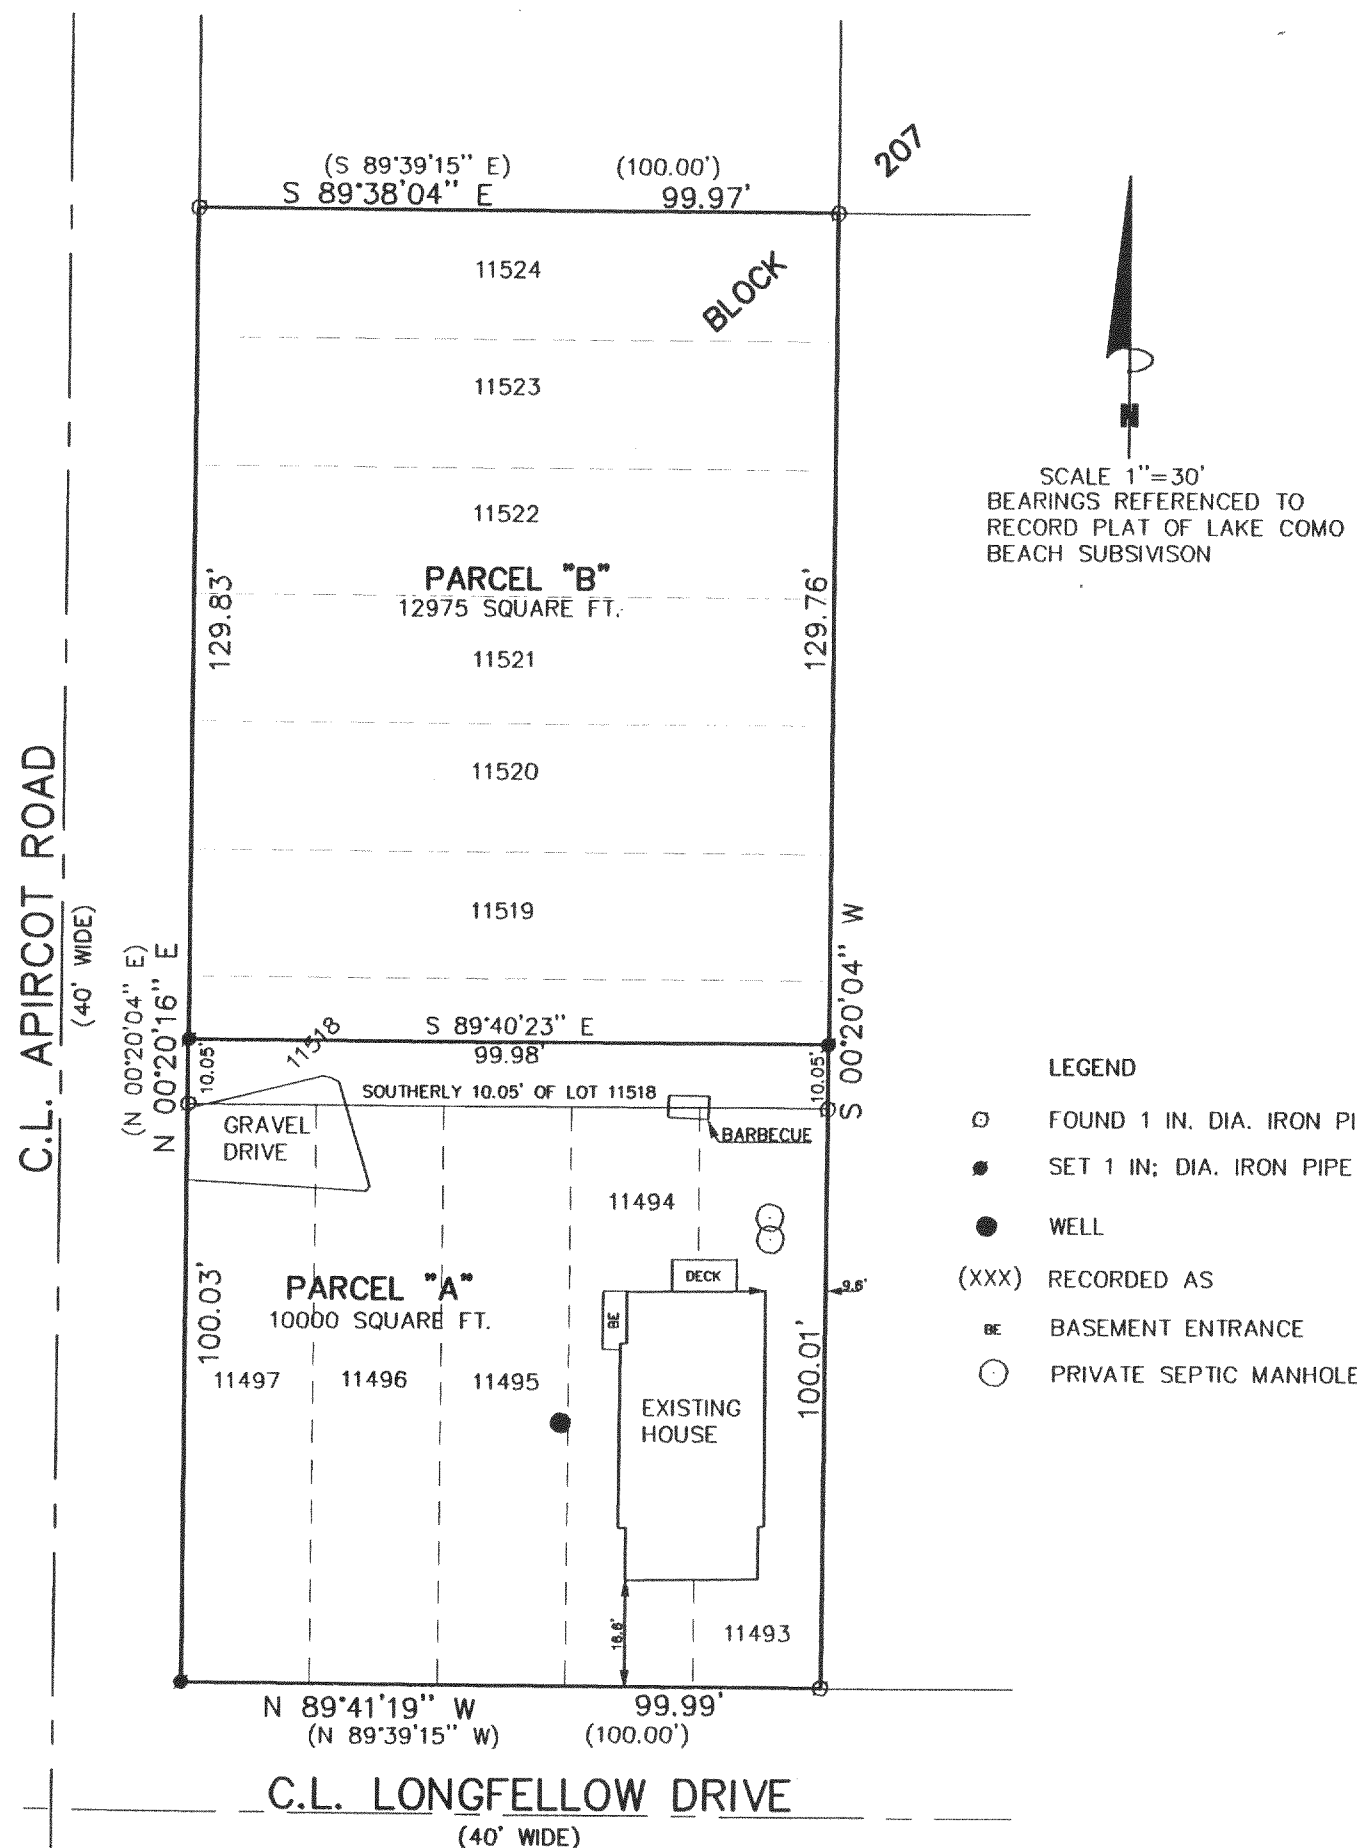

THE ABOVE MAP IS A TRUE REPRESENTATION THEREOF AND SHOWS THE SIZE AND LOCATION OF ALL THE PROPERTY, EXTERIOR BOUNDARIES, THE LOCATION OF ALL VISIBLE BOUNDARY FENCES, APPARENT EASEMENTS, ROADWAYS AND VISIBLE ENCROACHMENTS, IF ANY. THIS SURVEY IS MADE FOR THE USE OF THE PRESENT OWNERS OF THE PROPERTY, AND ALSO THOSE WHO PURCHASE, MORTGAGE OR GUARANTEE TITLE THERETO WITHIN ONE (1) YEAR FROM DATE HERETO.

John P. Krott
JOHN P. KROTT, R.L.S. 2258

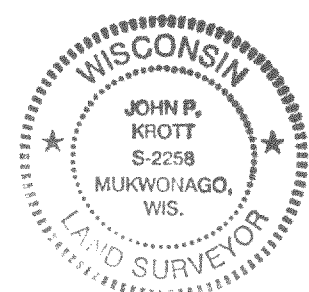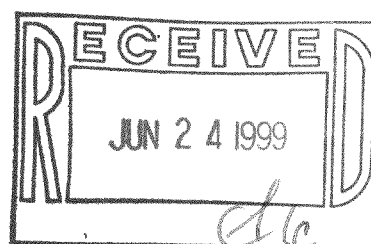

NOTE: THIS IS NOT A CERTIFIED COPY
UNLESS SEAL IS IN RED.
JOB NUMBER #99030 2-17-JLCB 02498

217-1758

JLCB-2498
2497A