


PATHFINDER SURVEYING
FORMERLY KOLB LAND CONSULTING
929 WILLIAMS STREET LAKE GENEVA, WI. 53147
(414) 248-3697

DATE: 5-21-1999

DESCRIPTION: LOTS 4251 THRU 4259 BLOCK 73
LAKE COMO BEACH SUBDIVISON
A SUBDIVISON LOCATED IN T2N,
R17E, WALWORTH COUNTY,
WISCONSIN

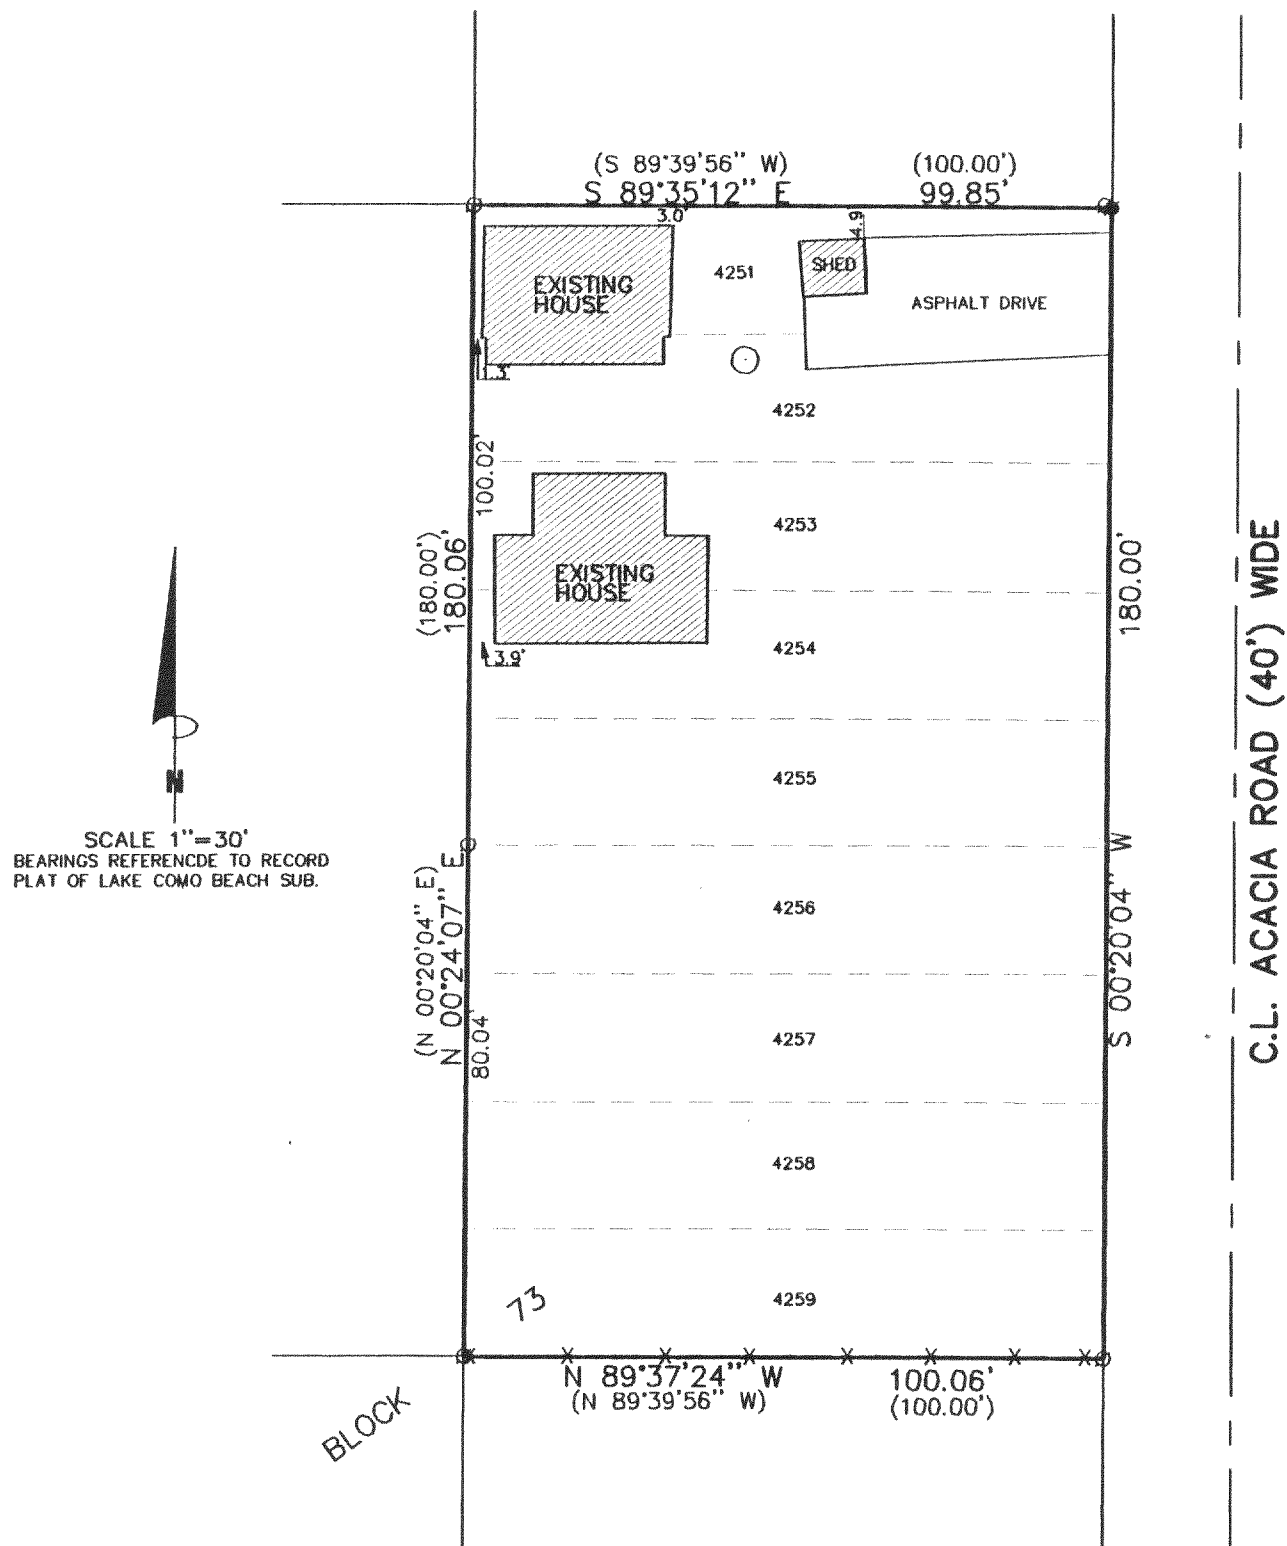



SCALE 1"=30'
BEARINGS REFERENCDE TO RECORD
PLAT OF LAKE COMO BEACH SUB.

□	FOUND IRON PIPE
●	SET IRON PIPE
○	MANHOLE
(XXX)	RECORDED AS
—X—	FENCE

THE ABOVE MAP IS A TRUE REPRESENTATION THEREOF AND SHOWS THE SIZE AND LOCATION OF ALL THE PROPERTY, EXTERIOR BOUNDARIES, THE LOCATION OF ALL VISIBLE BOUNDARY FENCES , APPARENT EASEMENTS , ROADWAYS AND VISIBLE ENCROACHMENTS , IF ANY

THIS SURVEY IS MADE FOR THE USE OF THE PRESENT OWNERS OF THE PROPERTY , AND ALSO THOSE WHO PURCHASE , MORTGAGE OR GURANTEE TITLE THERETO WITHIN ONE (1) YEAR FROM DATE HERETO.

John P. Krott
JOHN P. KROTT, R.L.S. 2258

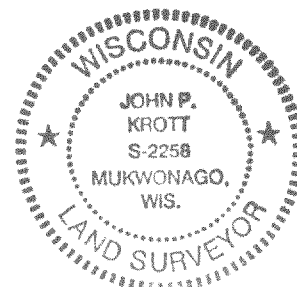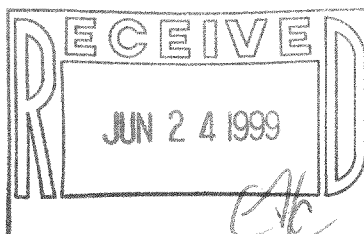

NOTE: THIS IS NOT A CERTIFIED COPY
UNLESS SEAL IS IN RED.

JOB NUMBER #99111 2-17-JCB 00827

JLCB-827
217-1765