


PLAT OF SURVEY

LOTS 10468 - 10472 INCLUSIVE OF
BLOCK 190 OF LAKE COMO BEACH
SUBDIVISION, BEING LOCATED IN
SECTION 28, TOWN 2 NORTH, RANGE
17 EAST, WALWORTH COUNTY,
WISCONSIN.

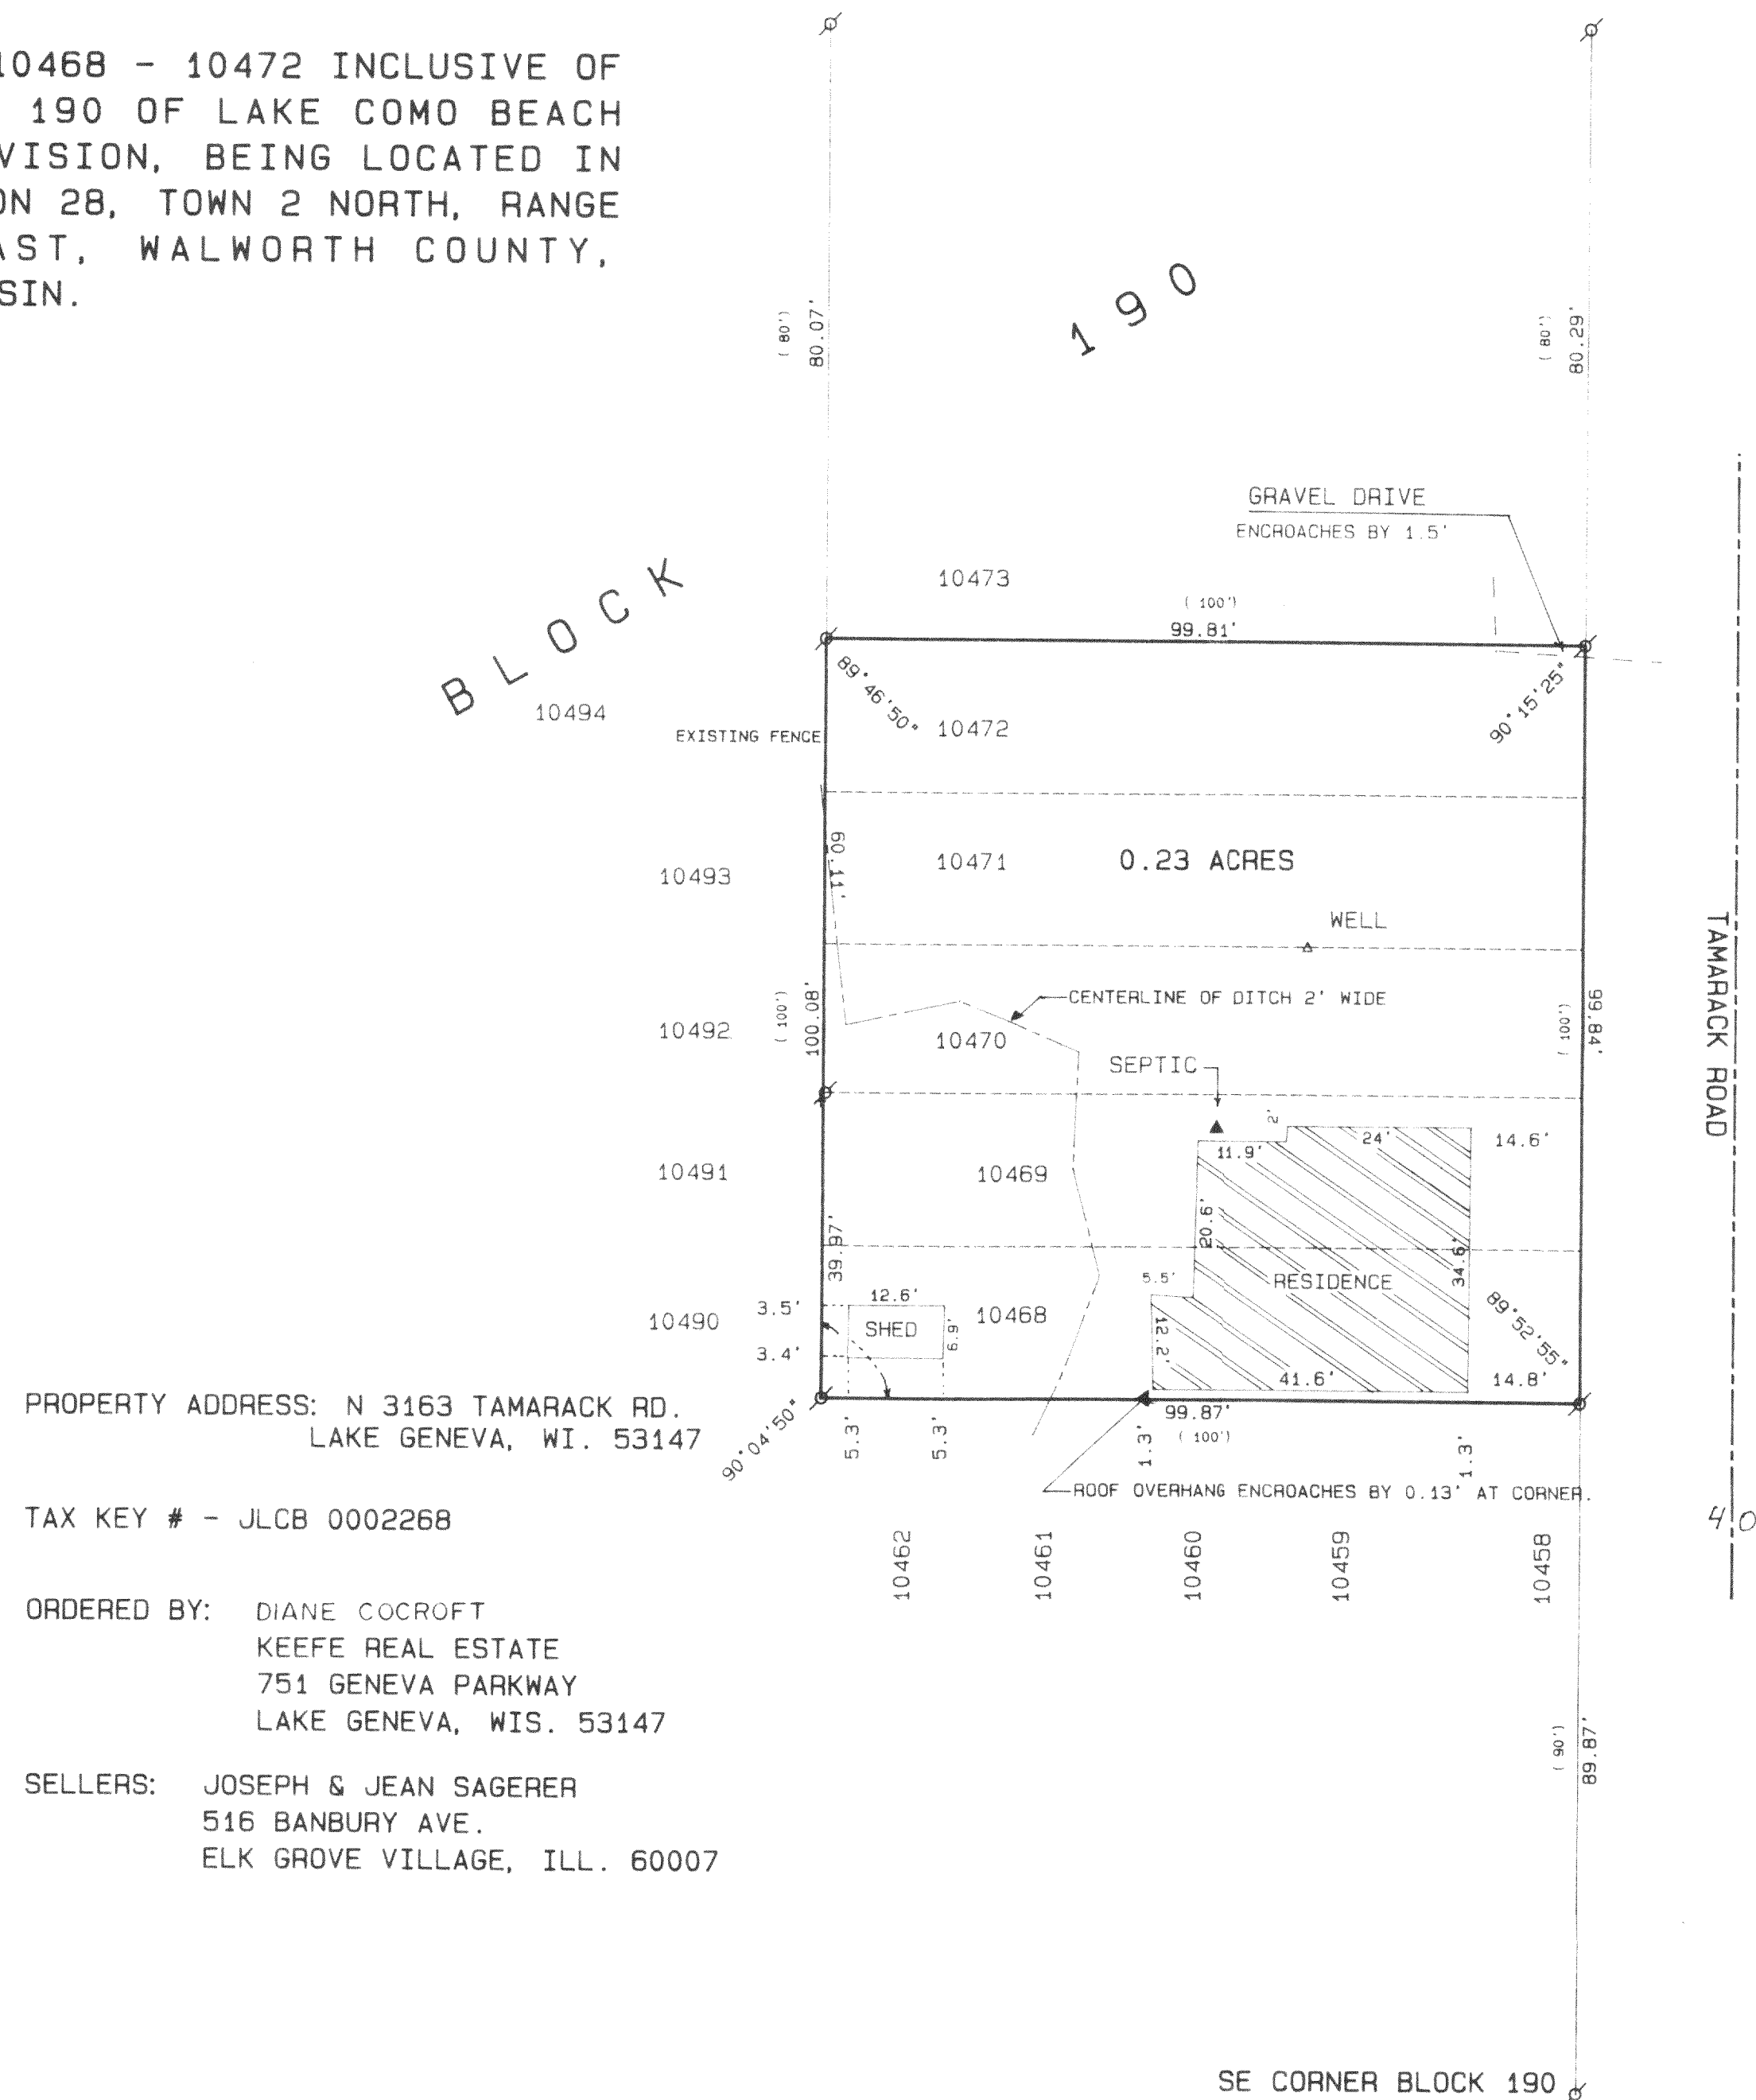


PROPERTY ADDRESS: N 3163 TAMARACK RD.
LAKE GENEVA, WI. 53147

TAX KEY # - JLCB 0002268


ORDERED BY: DIANE COCROFT
KEEFE REAL ESTATE
751 GENEVA PARKWAY
LAKE GENEVA, WIS. 53147

SELLERS: JOSEPH & JEAN SAGERER
516 BANBURY AVE.
ELK GROVE VILLAGE, ILL. 60007

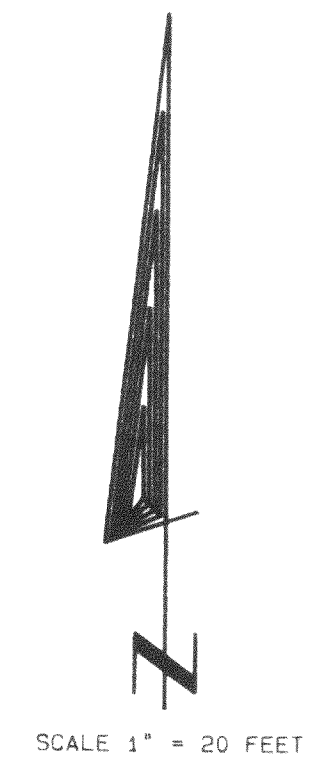

Legend

- FOUND IRON PIPE
 - FOUND IRON ROD
 - FOUND BRASS CAPPED MONUMENT
 - * FOUND CONCRETE MONUMENT
 - + CHISEL CUT IN CONCRETE
 - SET IRON ROD, 24" LONG, WEIGHING 1.5 LBS. LINEAL FT., 3/4" DIA.
 - SET IRON ROD, 30" LONG, WEIGHING 4.5 LBS. LINEAL FT., 1-1/16" DIA.
- [XXX] RECORDED AS DIMENSION
- EXISTING FENCE

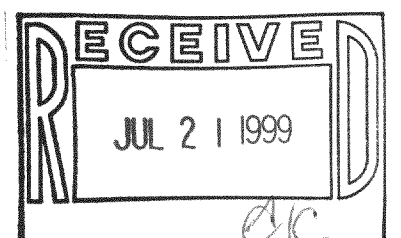

SCALE: 1" = 20 FEET



REVISÉ 7/21/99

I hereby certify that the above described property has been surveyed and shown as under my direction and that the above map is a true representation thereof and shows the site and location of the property, its exterior boundaries, the location of all visible structures and dimensions of all principal buildings thereon, boundary fences, apparent easements, roadways and visible encroachments, if any.

My survey was made for the use of the present owners of the property, and also those who purchase mortgage, to guarantee the title thereto within one year from date hereof.

one year from date hereof.

Kenneth B. Smith

KENNETH B. ABERNATHY, JR.
WISCONSIN REGISTERED LAND SURVEYOR,
S-1594

Date: JULY 14, 1997 Job No. 97.707

217-1772

JLCB-2268